


3.10.12
29.10.12
24.12.12

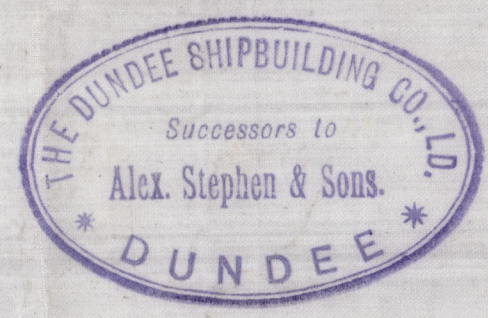

See letter 29.10.12


S.S. N° 249

PROFILE AND DECK PLANS


DIMENSIONS- 260'0" B.P. x 36'0" x 17'6" MOULDED

SCALE 1/8" = 1 FOOT

TO CLASS 100.A.I. AT LLOYDS

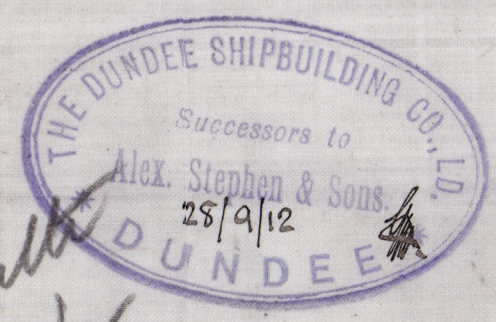


See letter 29/10/12

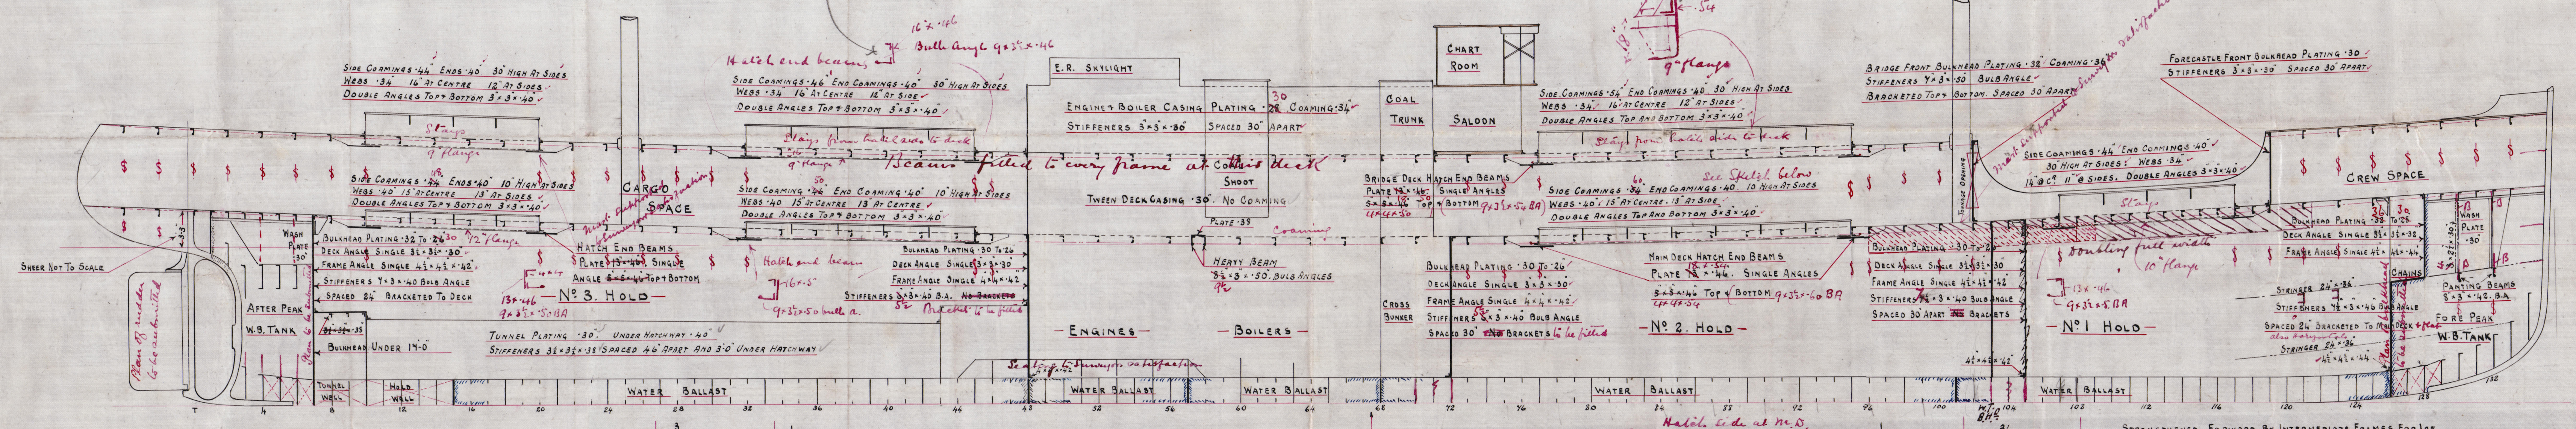


BRIDGE DECK

FORECASTLE DECK

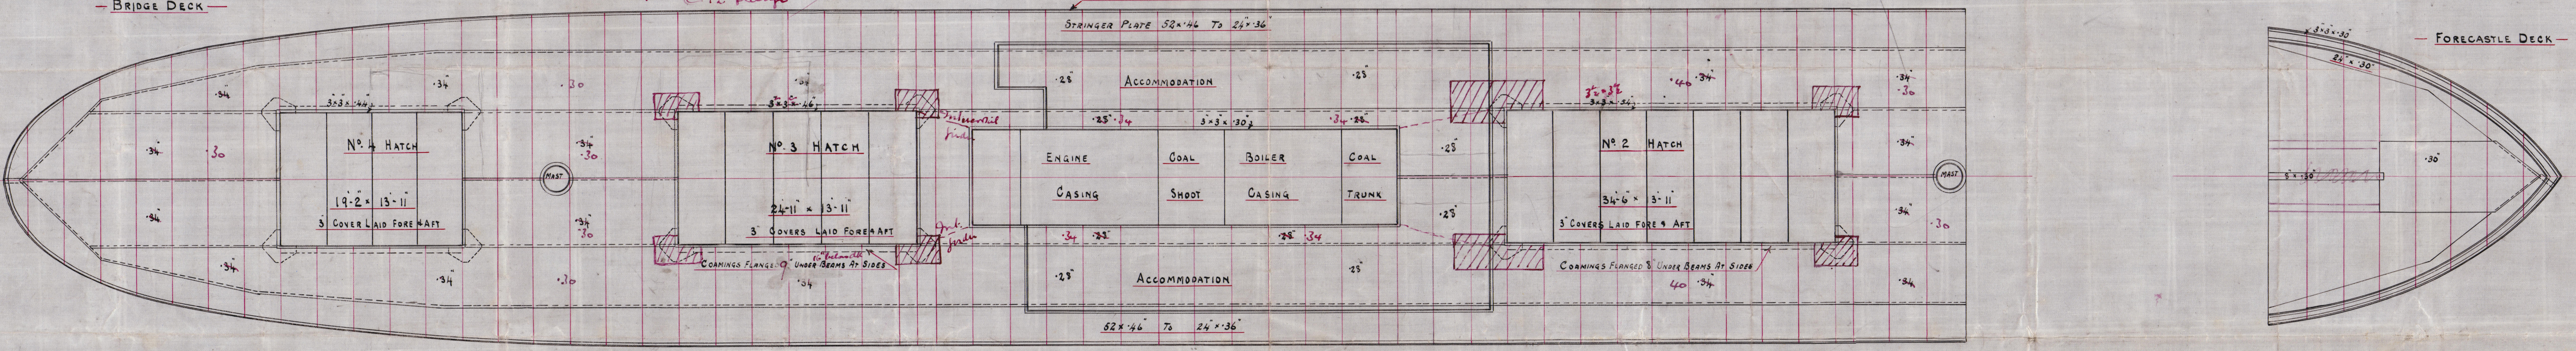

UPPER DECK

UPPER DECK

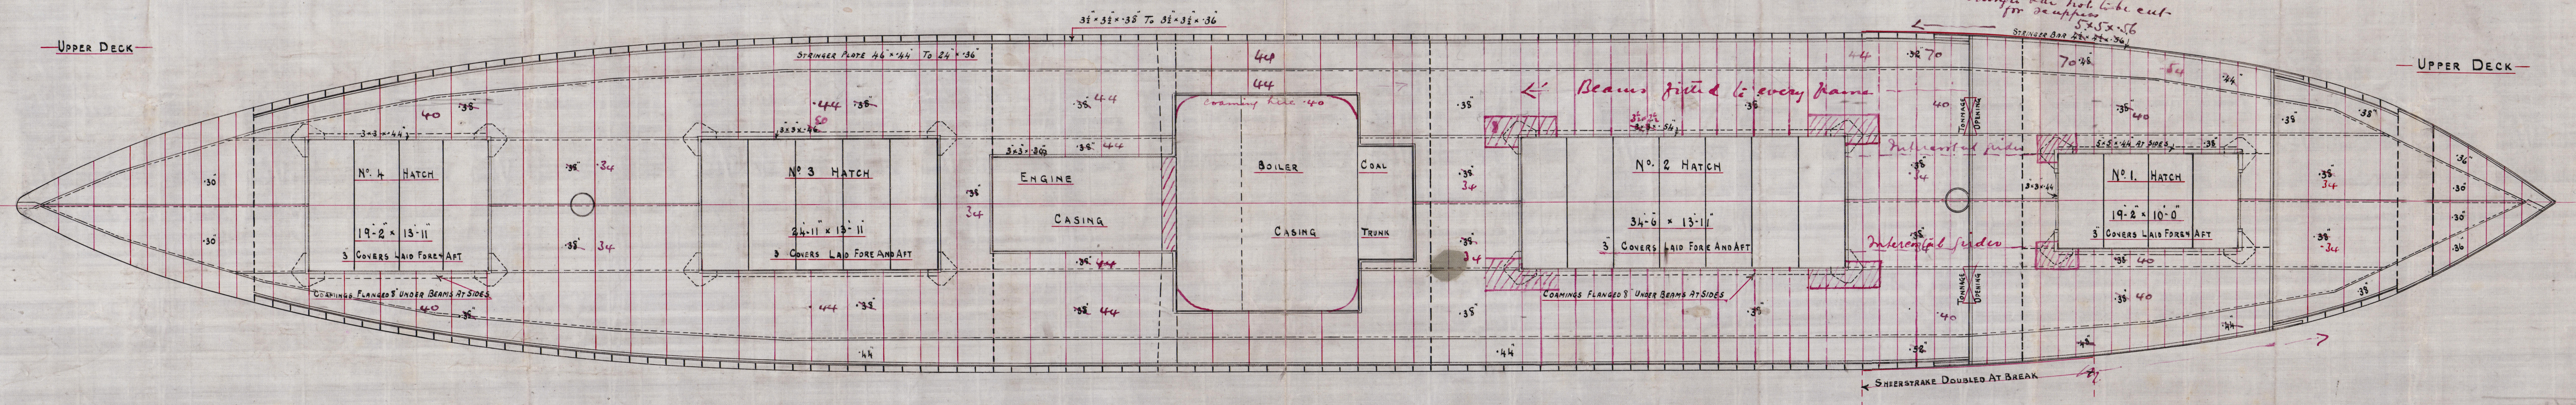

C.F.
3/10/12

004 6524: 1183
2:2 21710

W262-0075


PROFILE Y DECK PLAN

DUNDEE S.B. C^o L^{td}


N^o 249

S.S. 'SILVIO

DUN. RPT N^o 7783

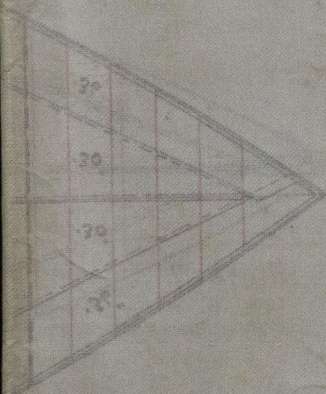

Y DECK —
1225 1226

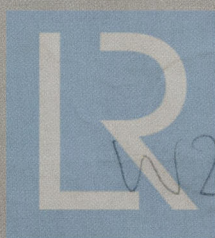

© 2019

Lloyd's Register
Foundation