


Hatch
LUGE 21'-1" x 14'-0"

OK

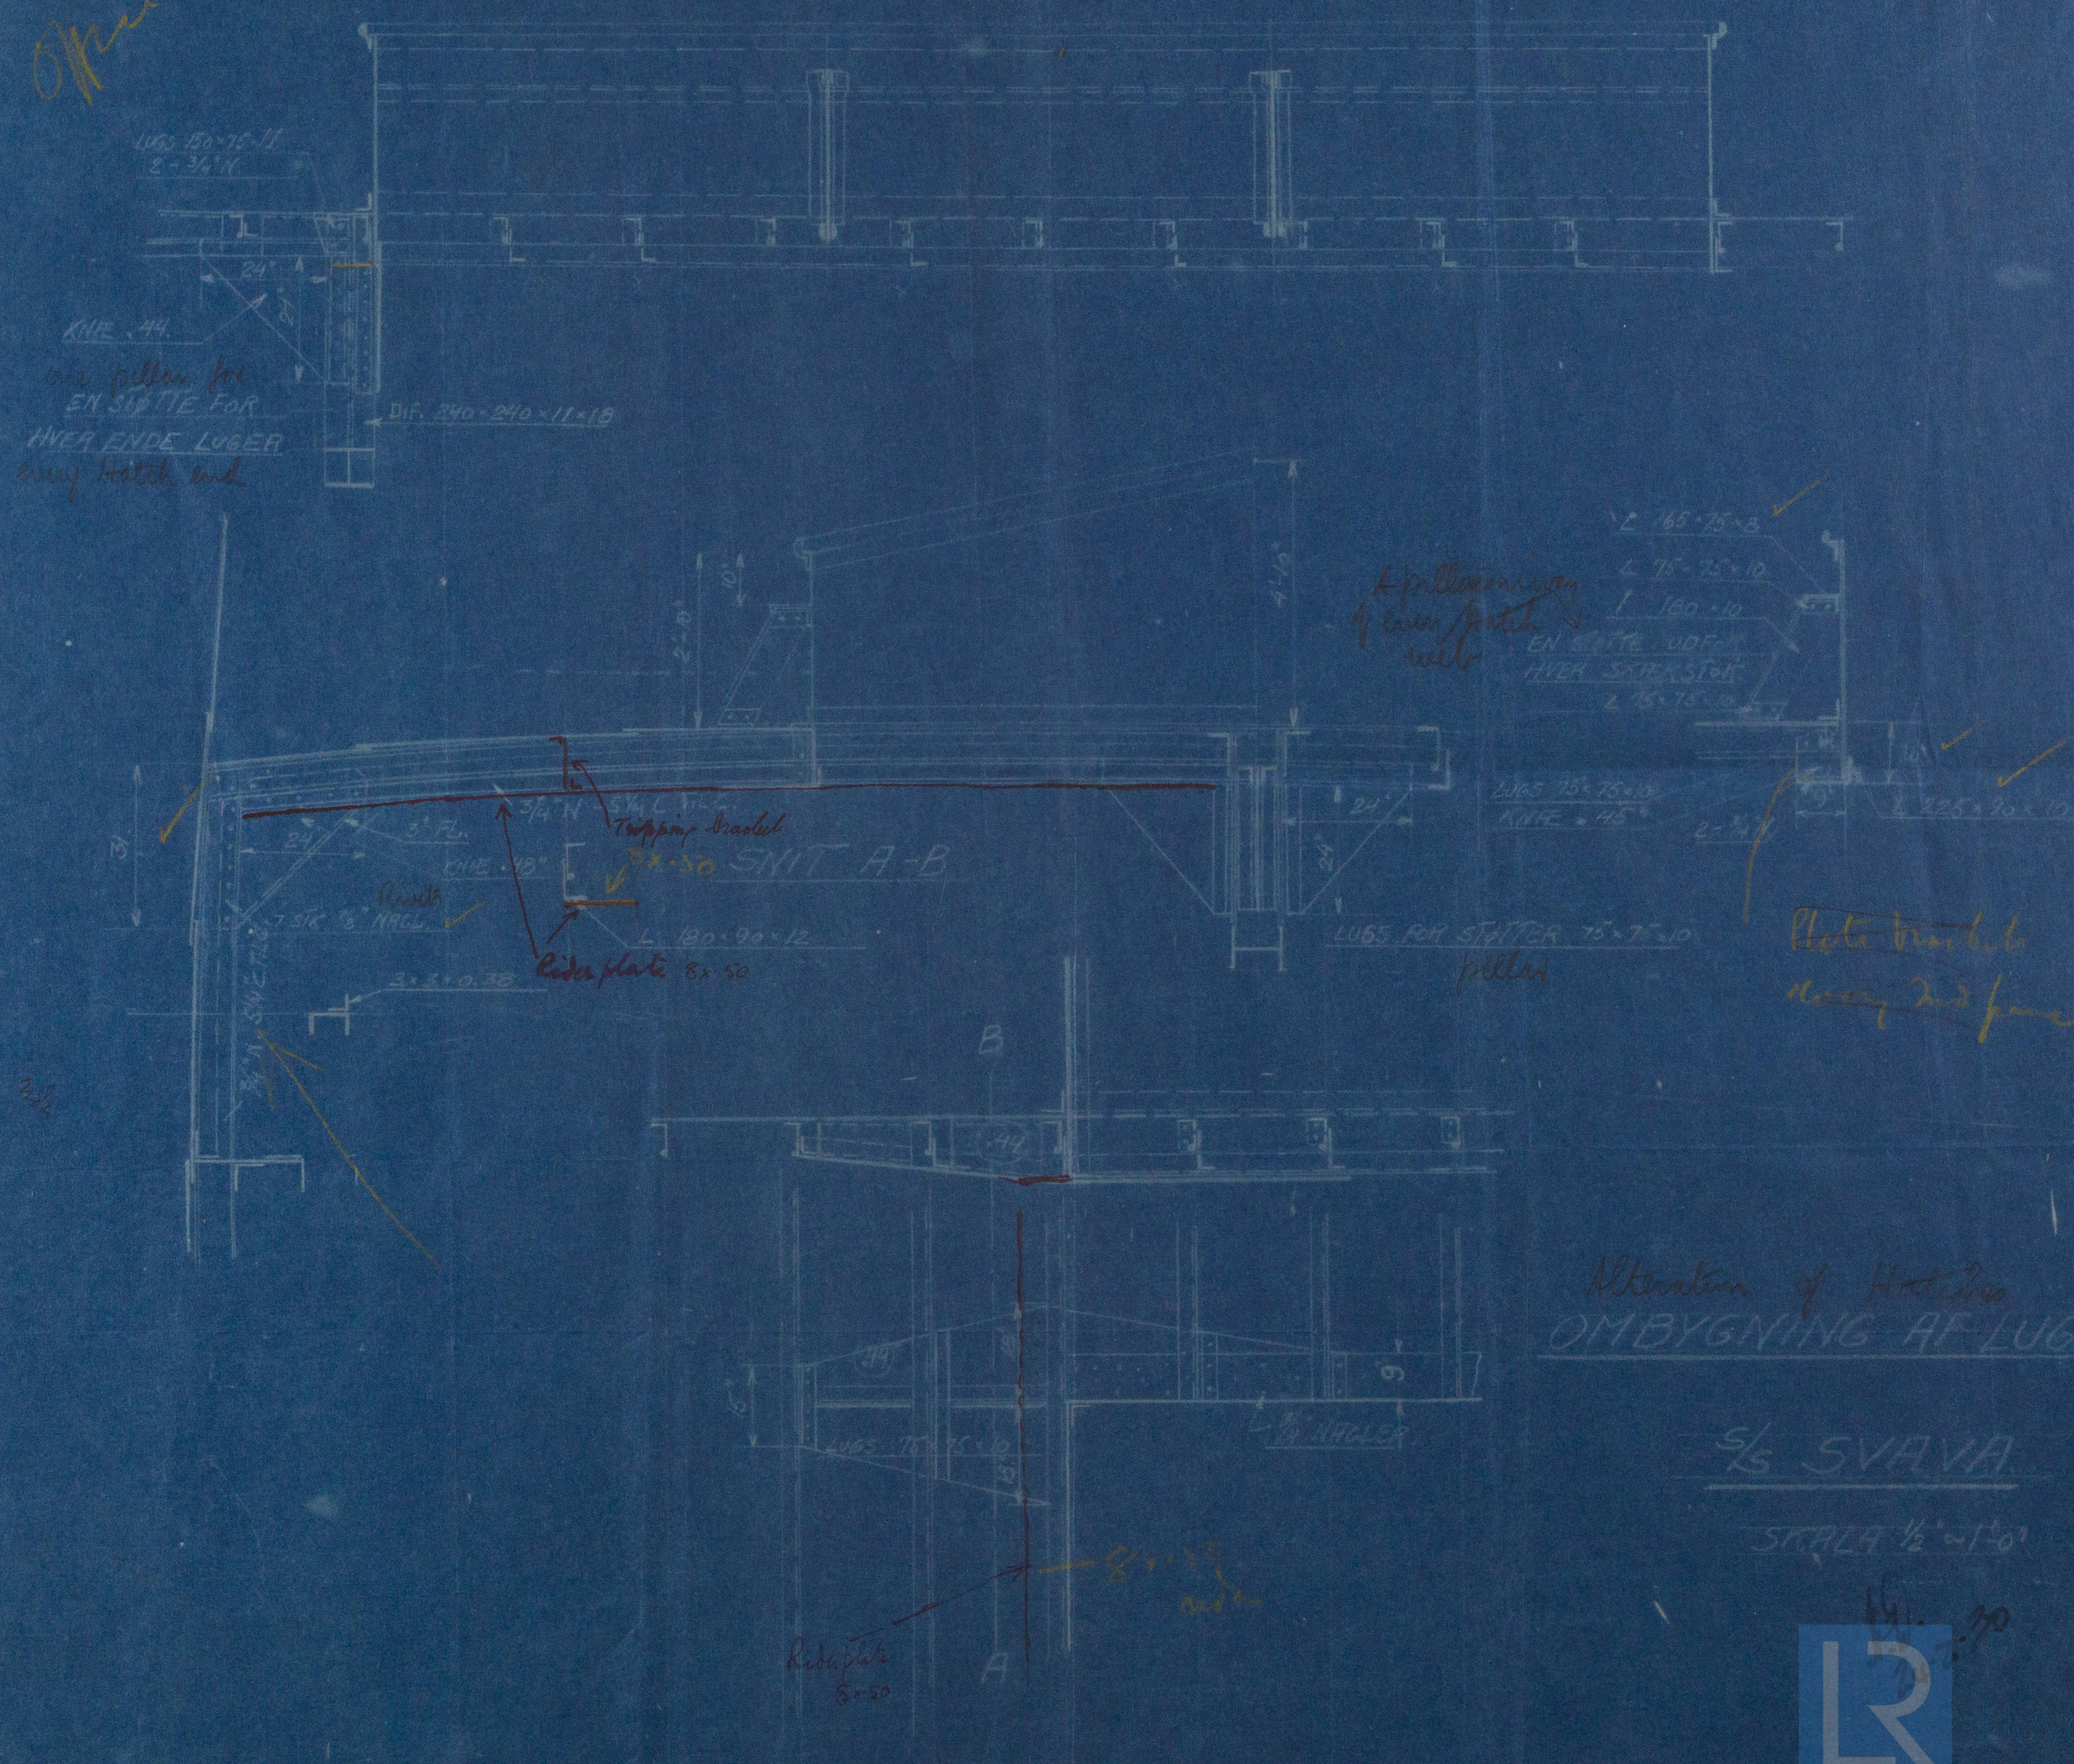


Foundation

W265-0022

Alteration to Hatchets
(Removal of side pillars in
way of hatchets)

S. S. "Svava"

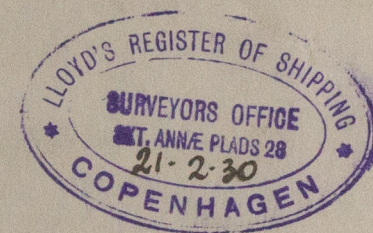

W 263-0022



© 2019

Lloyd's Register
Foundation