



PLAN OF POOPDECK.

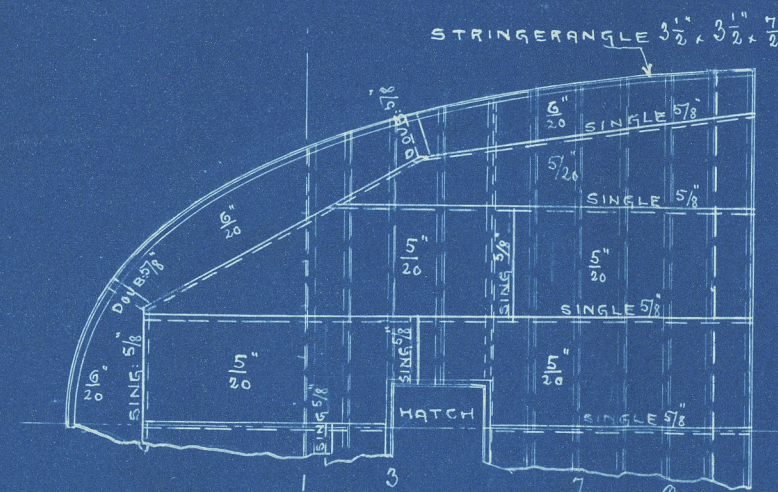


S.S. No 44
PLAN OF BRIDGEDECK

SCALE $\frac{1}{8}'' = 1 \text{ FOOT}$

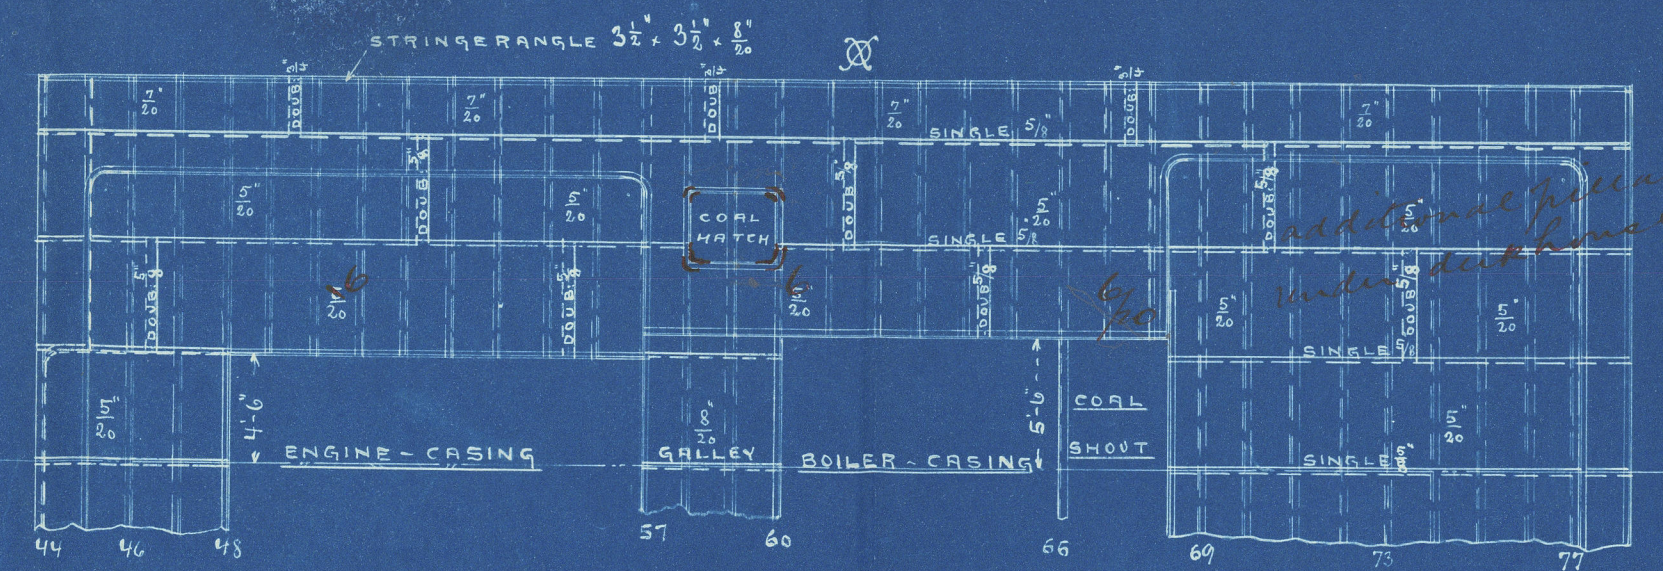

PLAN OF FORECASTLE.

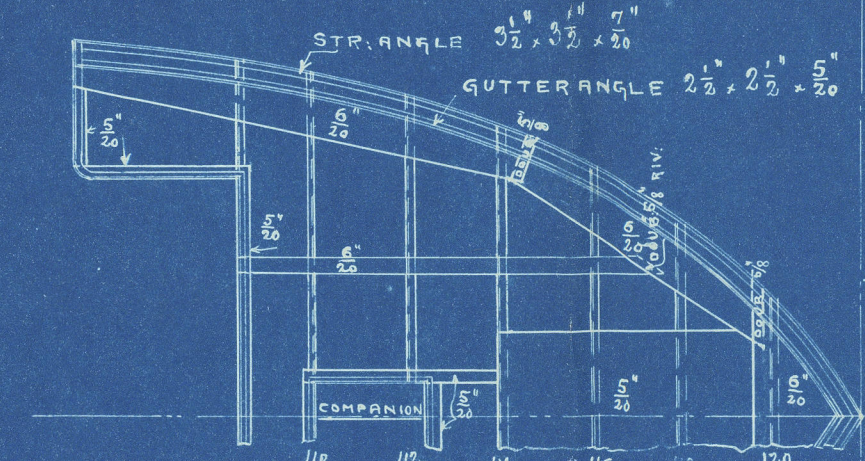

188

LR


© 2019

15/5.03


Madden


Plan of Bridge Deck
for
Kjøbenhavn Flydedok & Skibsoffs
Yard n^o 44

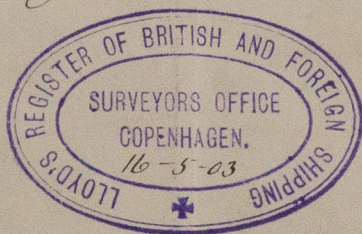


Bjorn

Apr. 1907

h. n. Svane

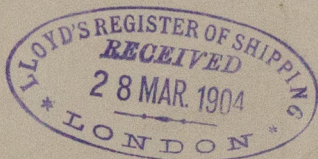

W263-0028 © 2019

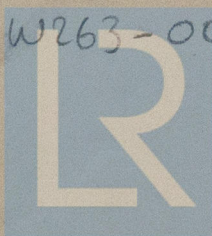

Lloyd's Register
Foundation