


13.5.03
21.5.03

S.S. N^o 44.

232'-0" x 34'-0" x 18'-10"
1/8" = 1' FOOT

*Winches to be additionally
handed to Surveyor
satisfaction*

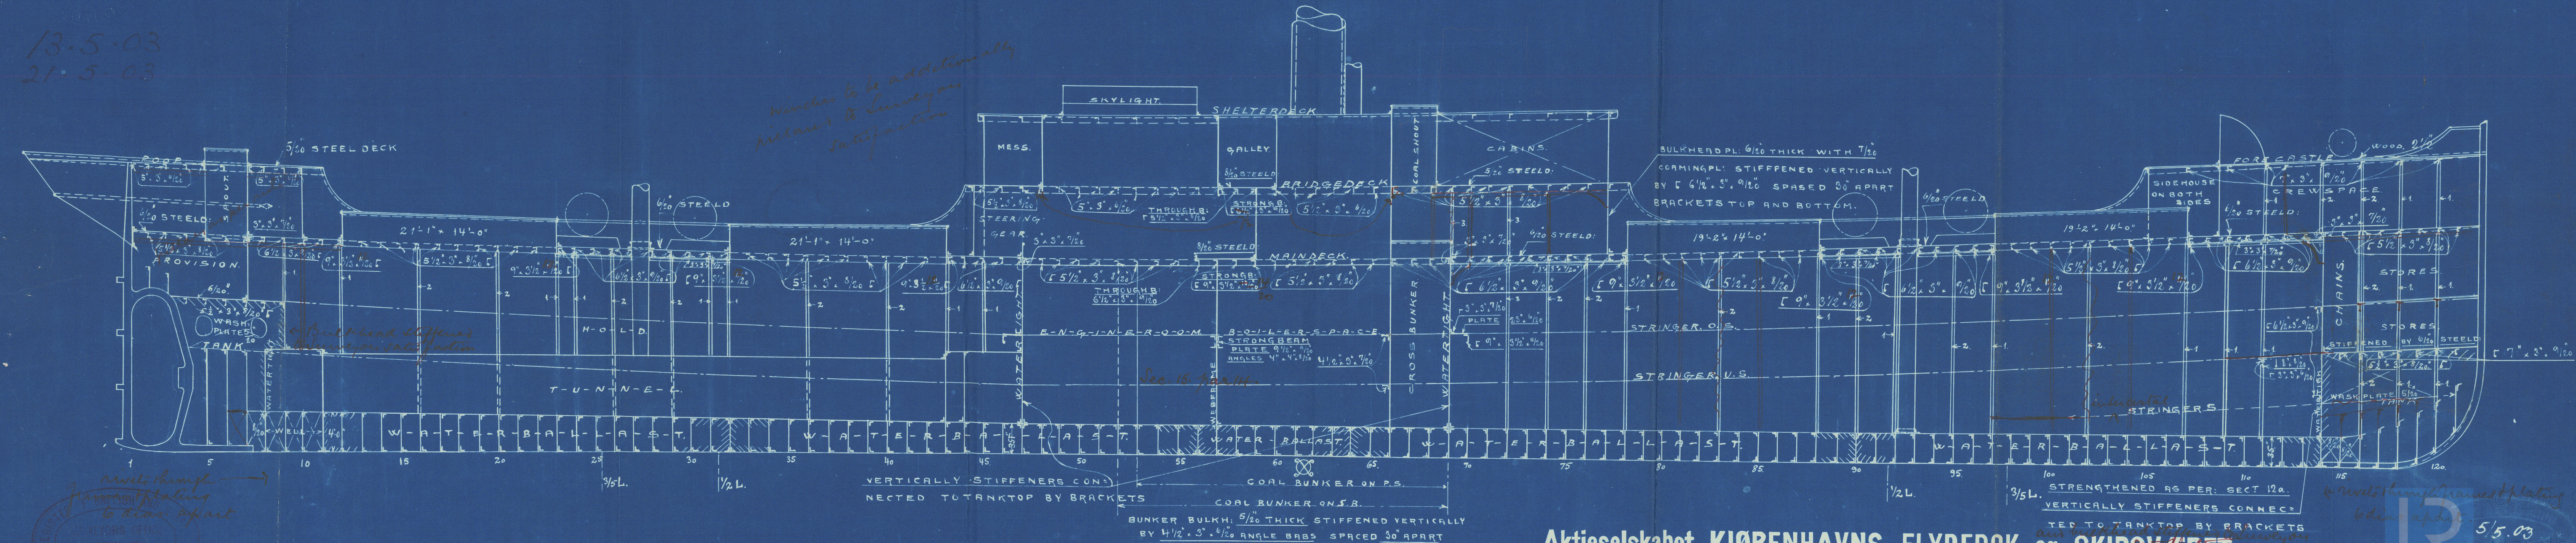

*rivets through
frames & plating
6 diam apart*



Aktieselskabet KJØBENHAVNS FLYDEDOK og SKIBSVÆRFT.


STRENGTHENED AS PER: SECT 12a.
VERTICALLY STIFFENERS CONN-
ECTED TO TANKTOP BY BRACKETS

*rivets through frames & plating
6 diam apart*


5/5.03
Hoyd's Register
Maiden

W263-0032

Longitudinal Plan.
of
Kjöbenhavn's Flydedok & Skibsværft's
Yard N^o 44.

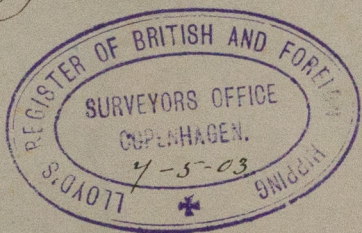


ss. "Bjorn"

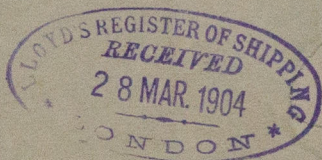

Apr. 1907

now "Svava"

SVAVA

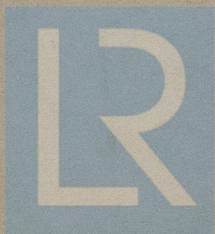

© 2019
W263-0032
Lloyd's Register
Foundation