


22.12.14  
21.1.15  
23.2.15


POOP DECK

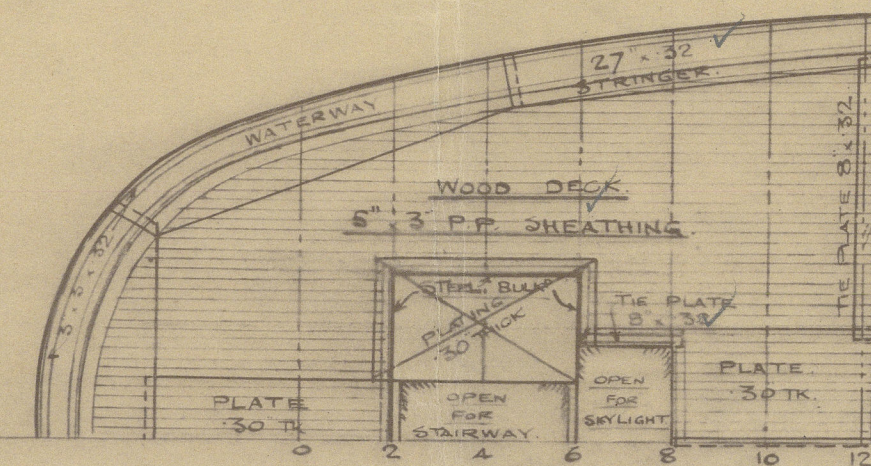


# DECK PLANS N°255 <sup>s</sup>/<sub>s</sub>.

SCALE 1/8" = 1 FOOT


BRIDGE DECK

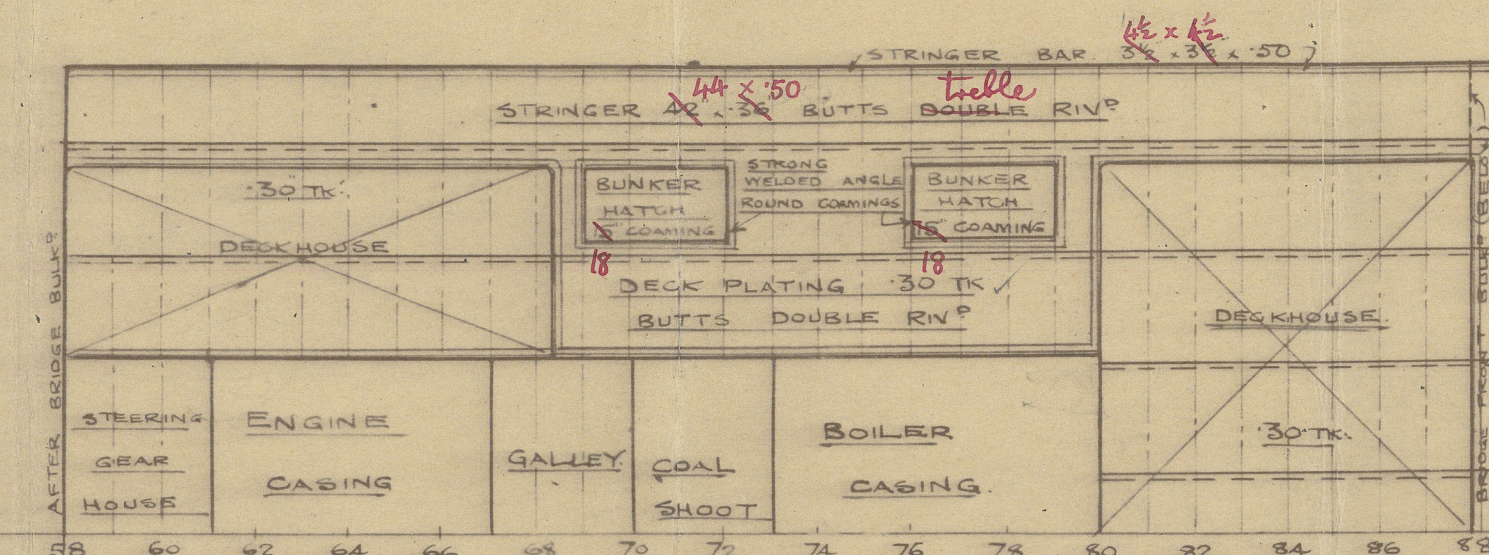

FORECASTLE DECK

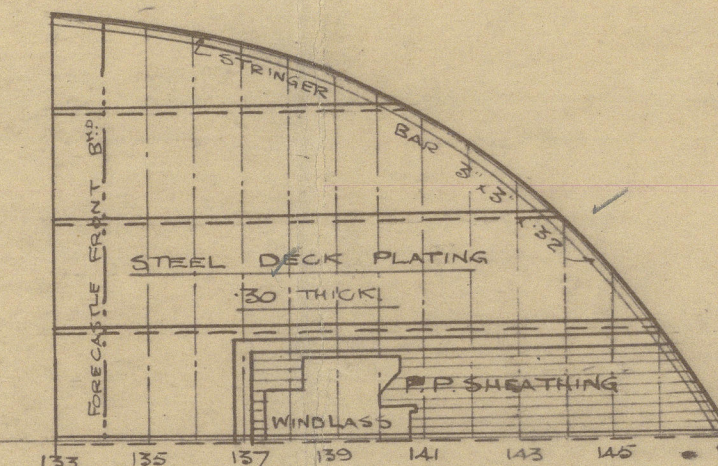

CABIN SOLE

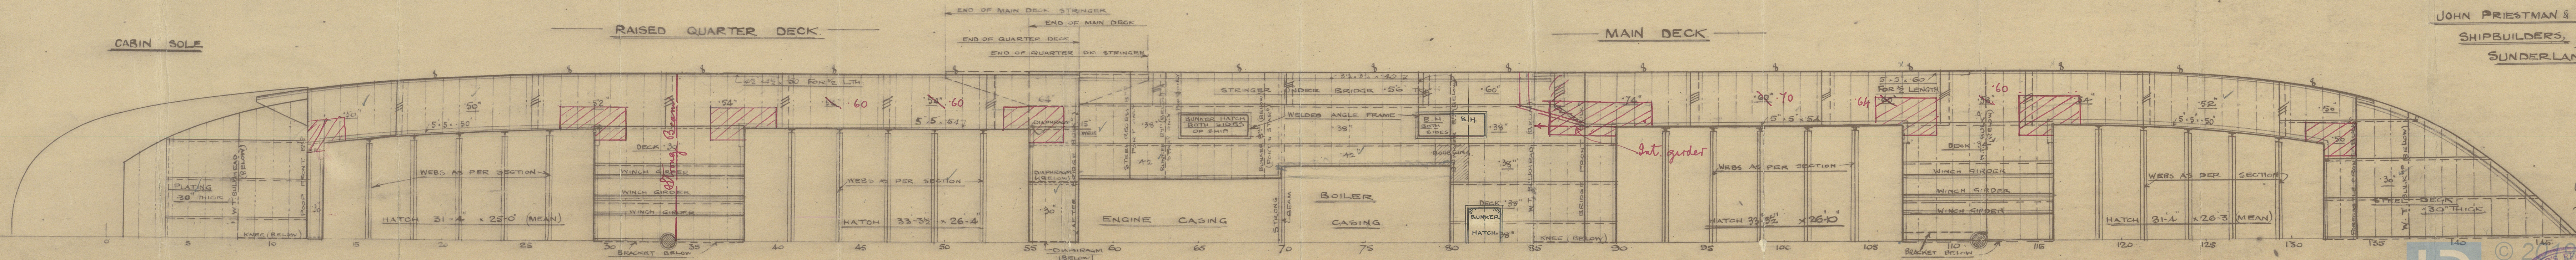





JOHN PRIESTMAN & Co.,  
SHIPBUILDERS,  
SUNDERLAND



W263-0138



S.S. USK MOUTH  
DECK PLANS  
SLD RPT N<sup>o</sup>  
PRIESTMANS N<sup>o</sup> 255

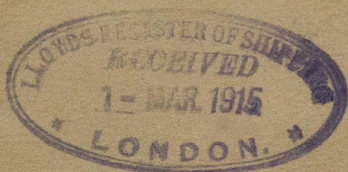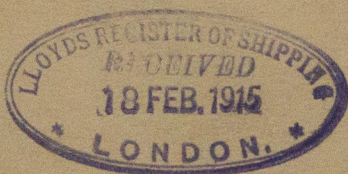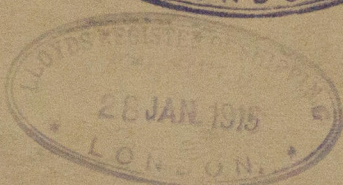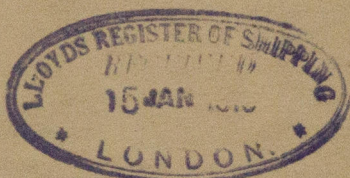

n. n. "Sellinge."

SUNDERLAND RPT. NO.

26767

W263-21389

Lloyd's Register  
Foundation