



# DECK PLANS N<sup>o</sup>255 <sup>s</sup>/<sub>s</sub>. S.S. "USKMOUTH."

SCALE  $\frac{1}{8}$  = 1 FOOT


POOP DECK

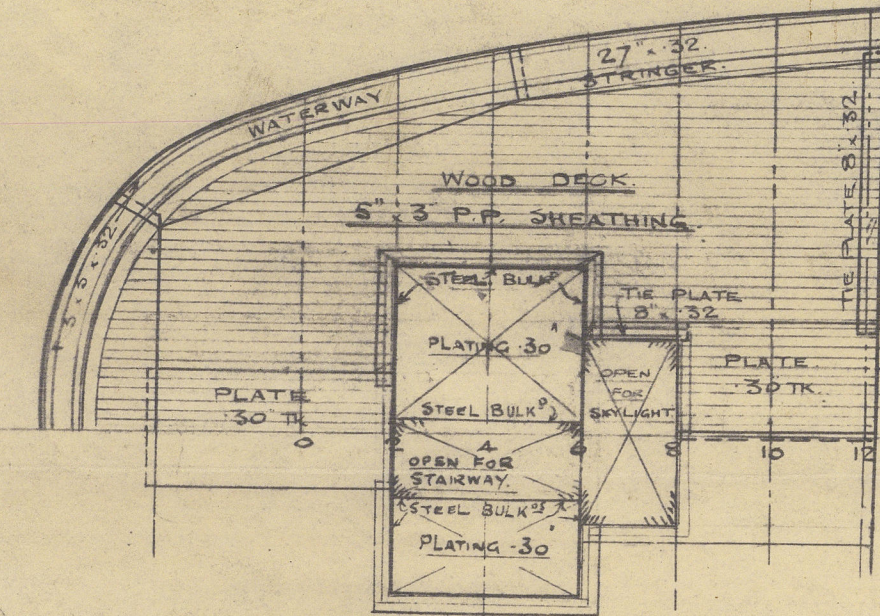

CABIN SOLE

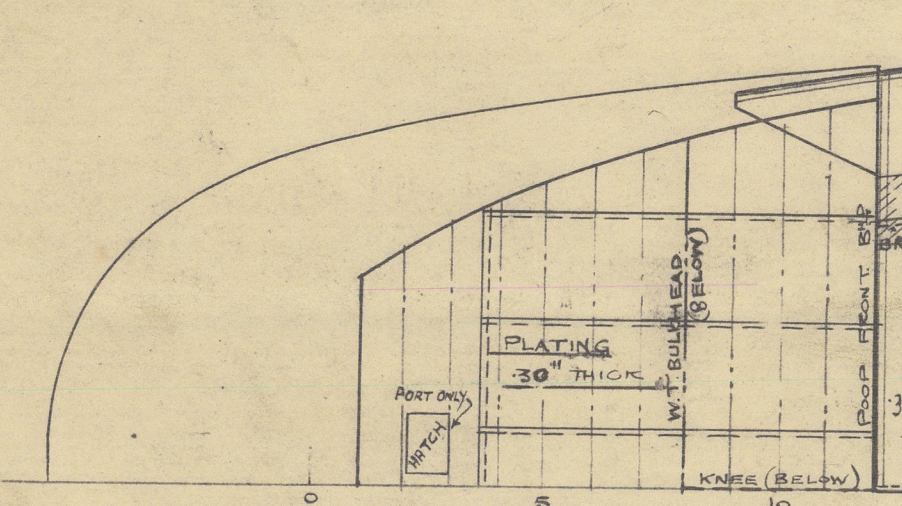


RAISED QUARTER DECK

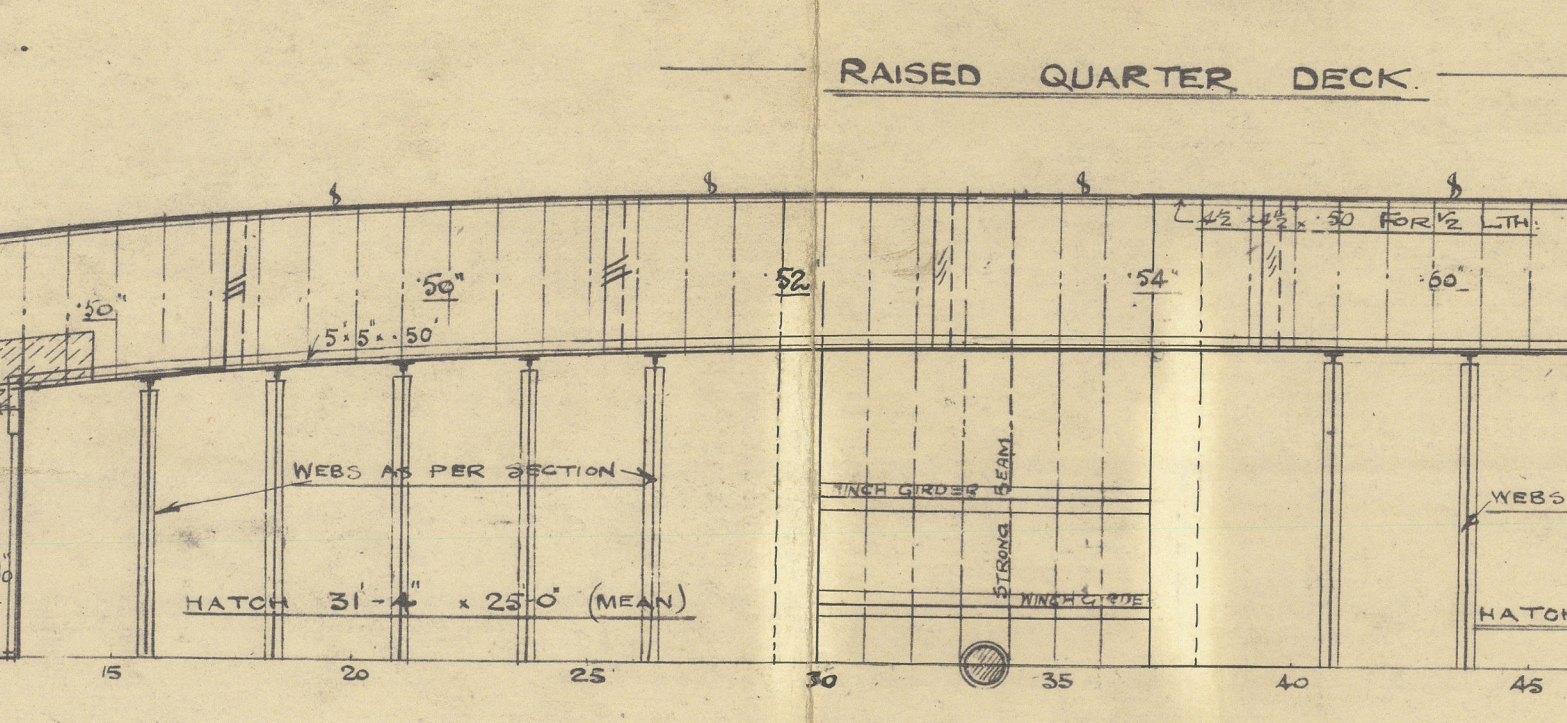


FOR MAIN DECK & WINCH DECK DETAILS  
SEE SEPARATE PLAN.

BRIDGE DECK

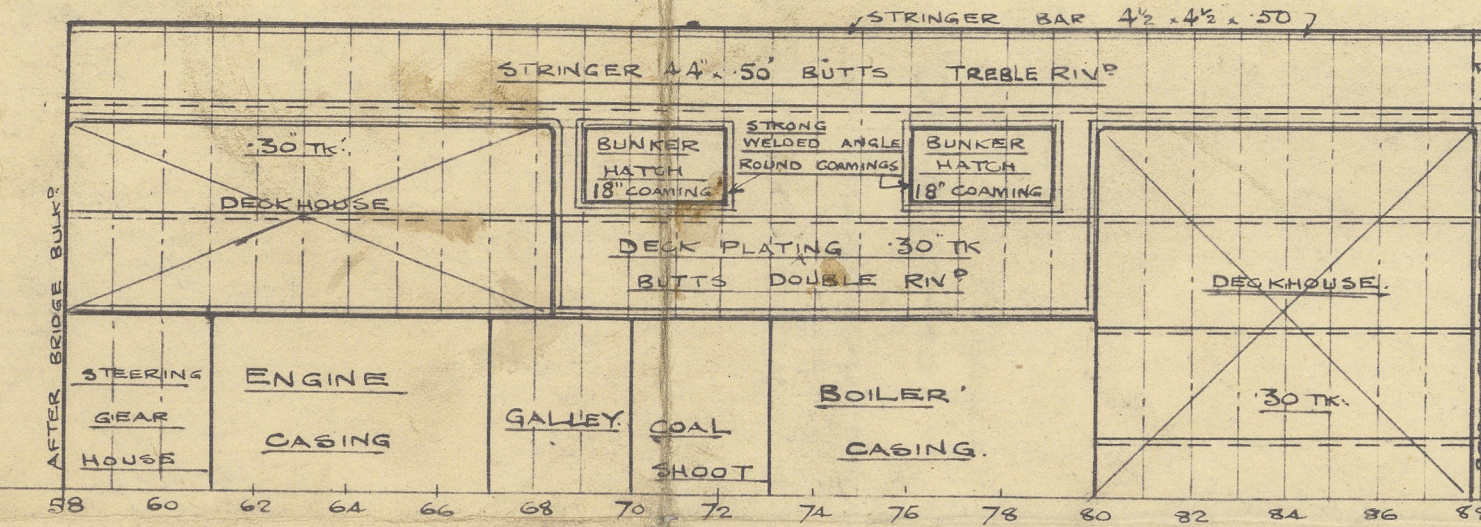


MAIN DECK

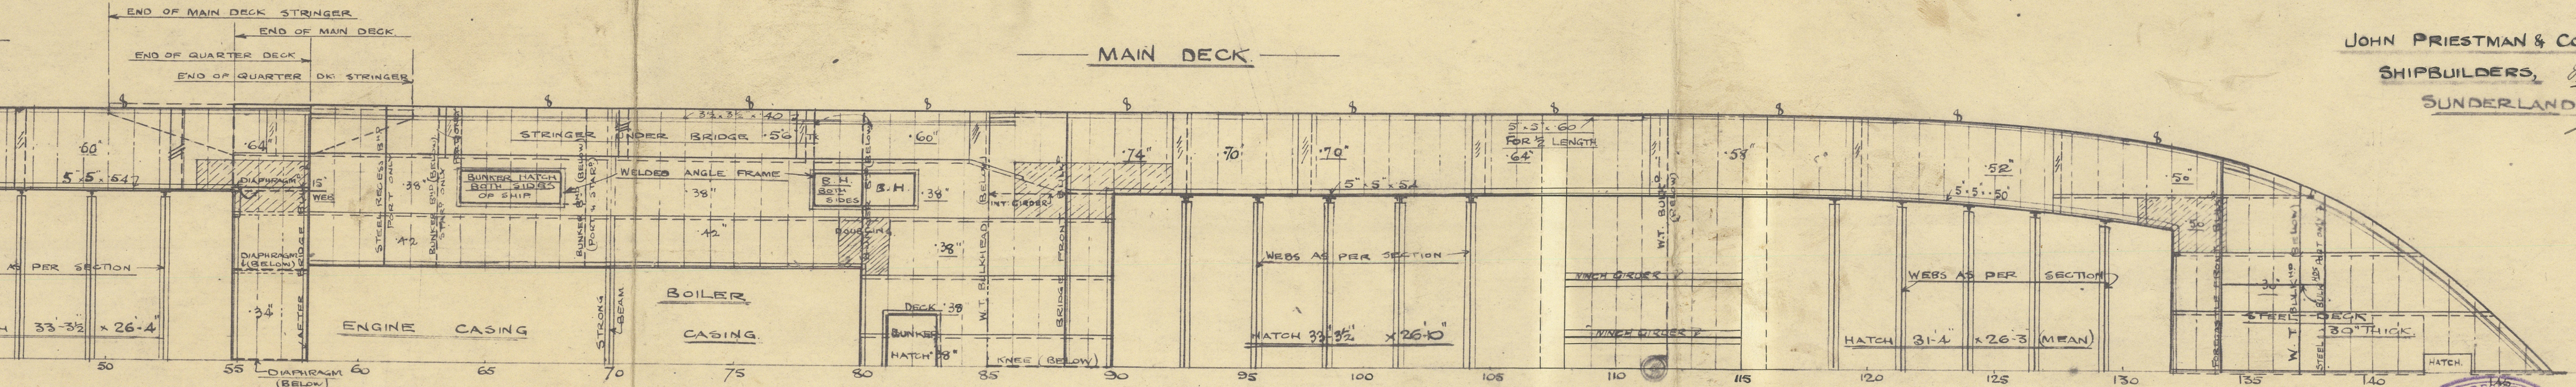

FOR MAIN DECK & WINCH DECK DETAILS  
SEE SEPARATE PLAN.

FORECASTLE DECK

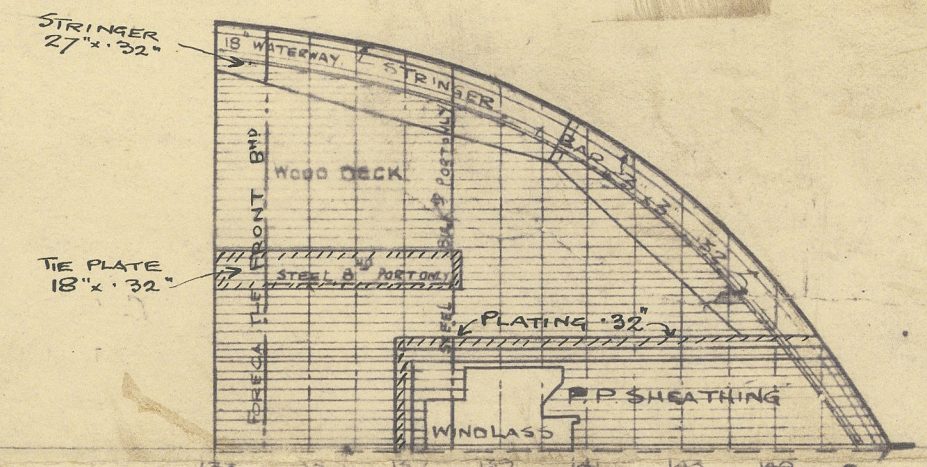

JOHN PRIESTMAN & Co.,  
SHIPBUILDERS, *P.R.*  
SUNDERLAND 22.7.16





S.S. USKMOUTH

PRIESTMAN N° 255

DECK PLANS

(AS FITTED)

SLD RPT N° 26767

L. n. Sellinger

W263-0139



© 2019

Lloyd's Register  
Foundation