


PROFILE N° 255.

SCALE 1/8" = 1 FOOT

DIMENSIONS
LENGTH B.P. 290'-0"
BREADTH EXT. 40'-9"
DEPTH MLD. 20'-6"

JOHN PRIESTMAN & CO.
SHIPBUILDERS
SUNDERLAND

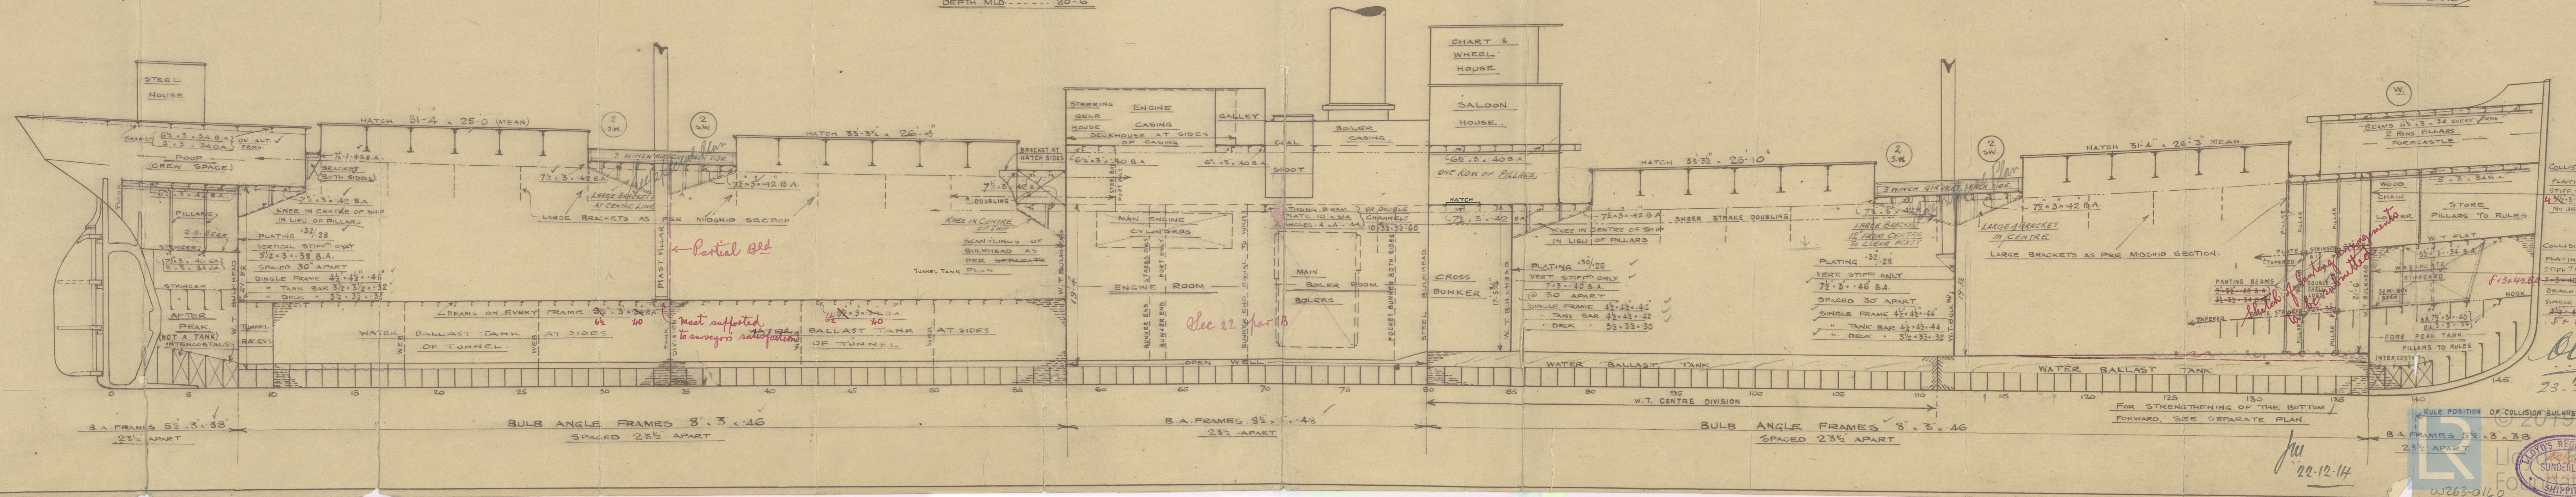

COLLISION BULKHEAD
PLATING 30"
STIFF VERT ONLY
4" x 3" x 24"
NO BRACKETS

COLLISION BULKHEAD
PLATING 34" x 36"
STIFF VERT ONLY
4" x 3" x 24"
BRACKETS AT TOP
SINGLE FRAME
1 1/2" x 5" x 46"

23.2.15.

RULE POSITION OF COLLISION BULKHEAD
FORWARD, SEE SEPARATE PLAN.







B.A. FRAMES 5 1/2" x 3" x 38"
23 1/2" APART.

22-12-14

W263-0140

LLOYD'S REGISTER OF SHIPPING
SUNDERLAND

S. S. USK MOUTH
PROFILE
SLD RPT N^o.
PRIESTMAN'S N^o 255

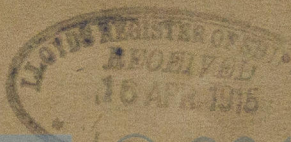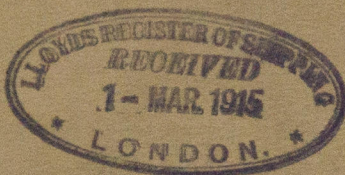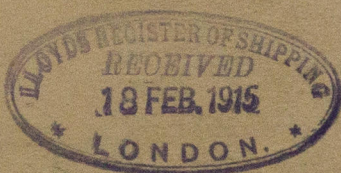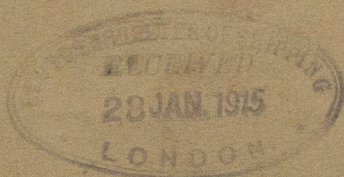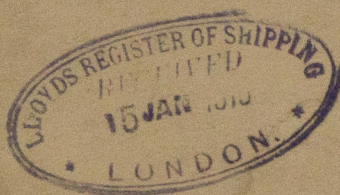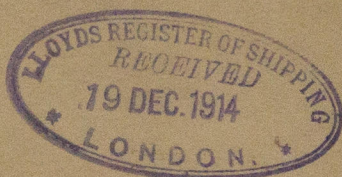

W263-0140

UNDERLAND

RPT. NO.

28767

~~2550~~ 1002

Lloyd's Register

Selling

Week Review