


23/5/23

# NO 533 SHIP. PROFILE & DECK PLANS.


DIMENSIONS: - LENGTH 449'-3" ON SUMMER L.W.L.  
BREADTH 60'-0" MOULDED  
DEPTH 41'-0" MOULDED TO UPPER DECK

FIRST LONGITUDINAL NUMERAL 18419  
SECOND - 48572

SCALE 1/8" = 1 FOOT

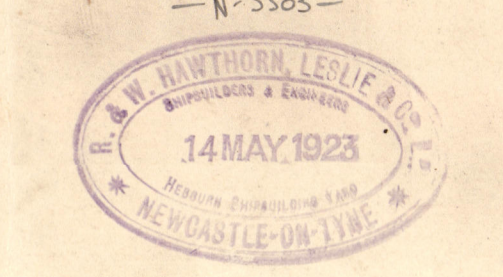

Plan of Upper Storey Arrangement in  
by of drawings to be submitted  
Plan of lower storey to be submitted

 

## BRIDGE DECK

## ISLAND DECK

## FORECASTLE DECK

## UPPER DECK

## UPPER DECK

## SECOND DECK

## SECOND DECK

## THIRD DECK

## THIRD DECK



2

Profile and decks

S. S. No 533.

Hawthorn Leslie & Co. Ltd.

---

S. S. TALAMBA.

NEWCASTLE ON TYNE.

Report No. 78430.

---

W 264 - 0232



© 2019

Lloyd's Register  
Foundation