
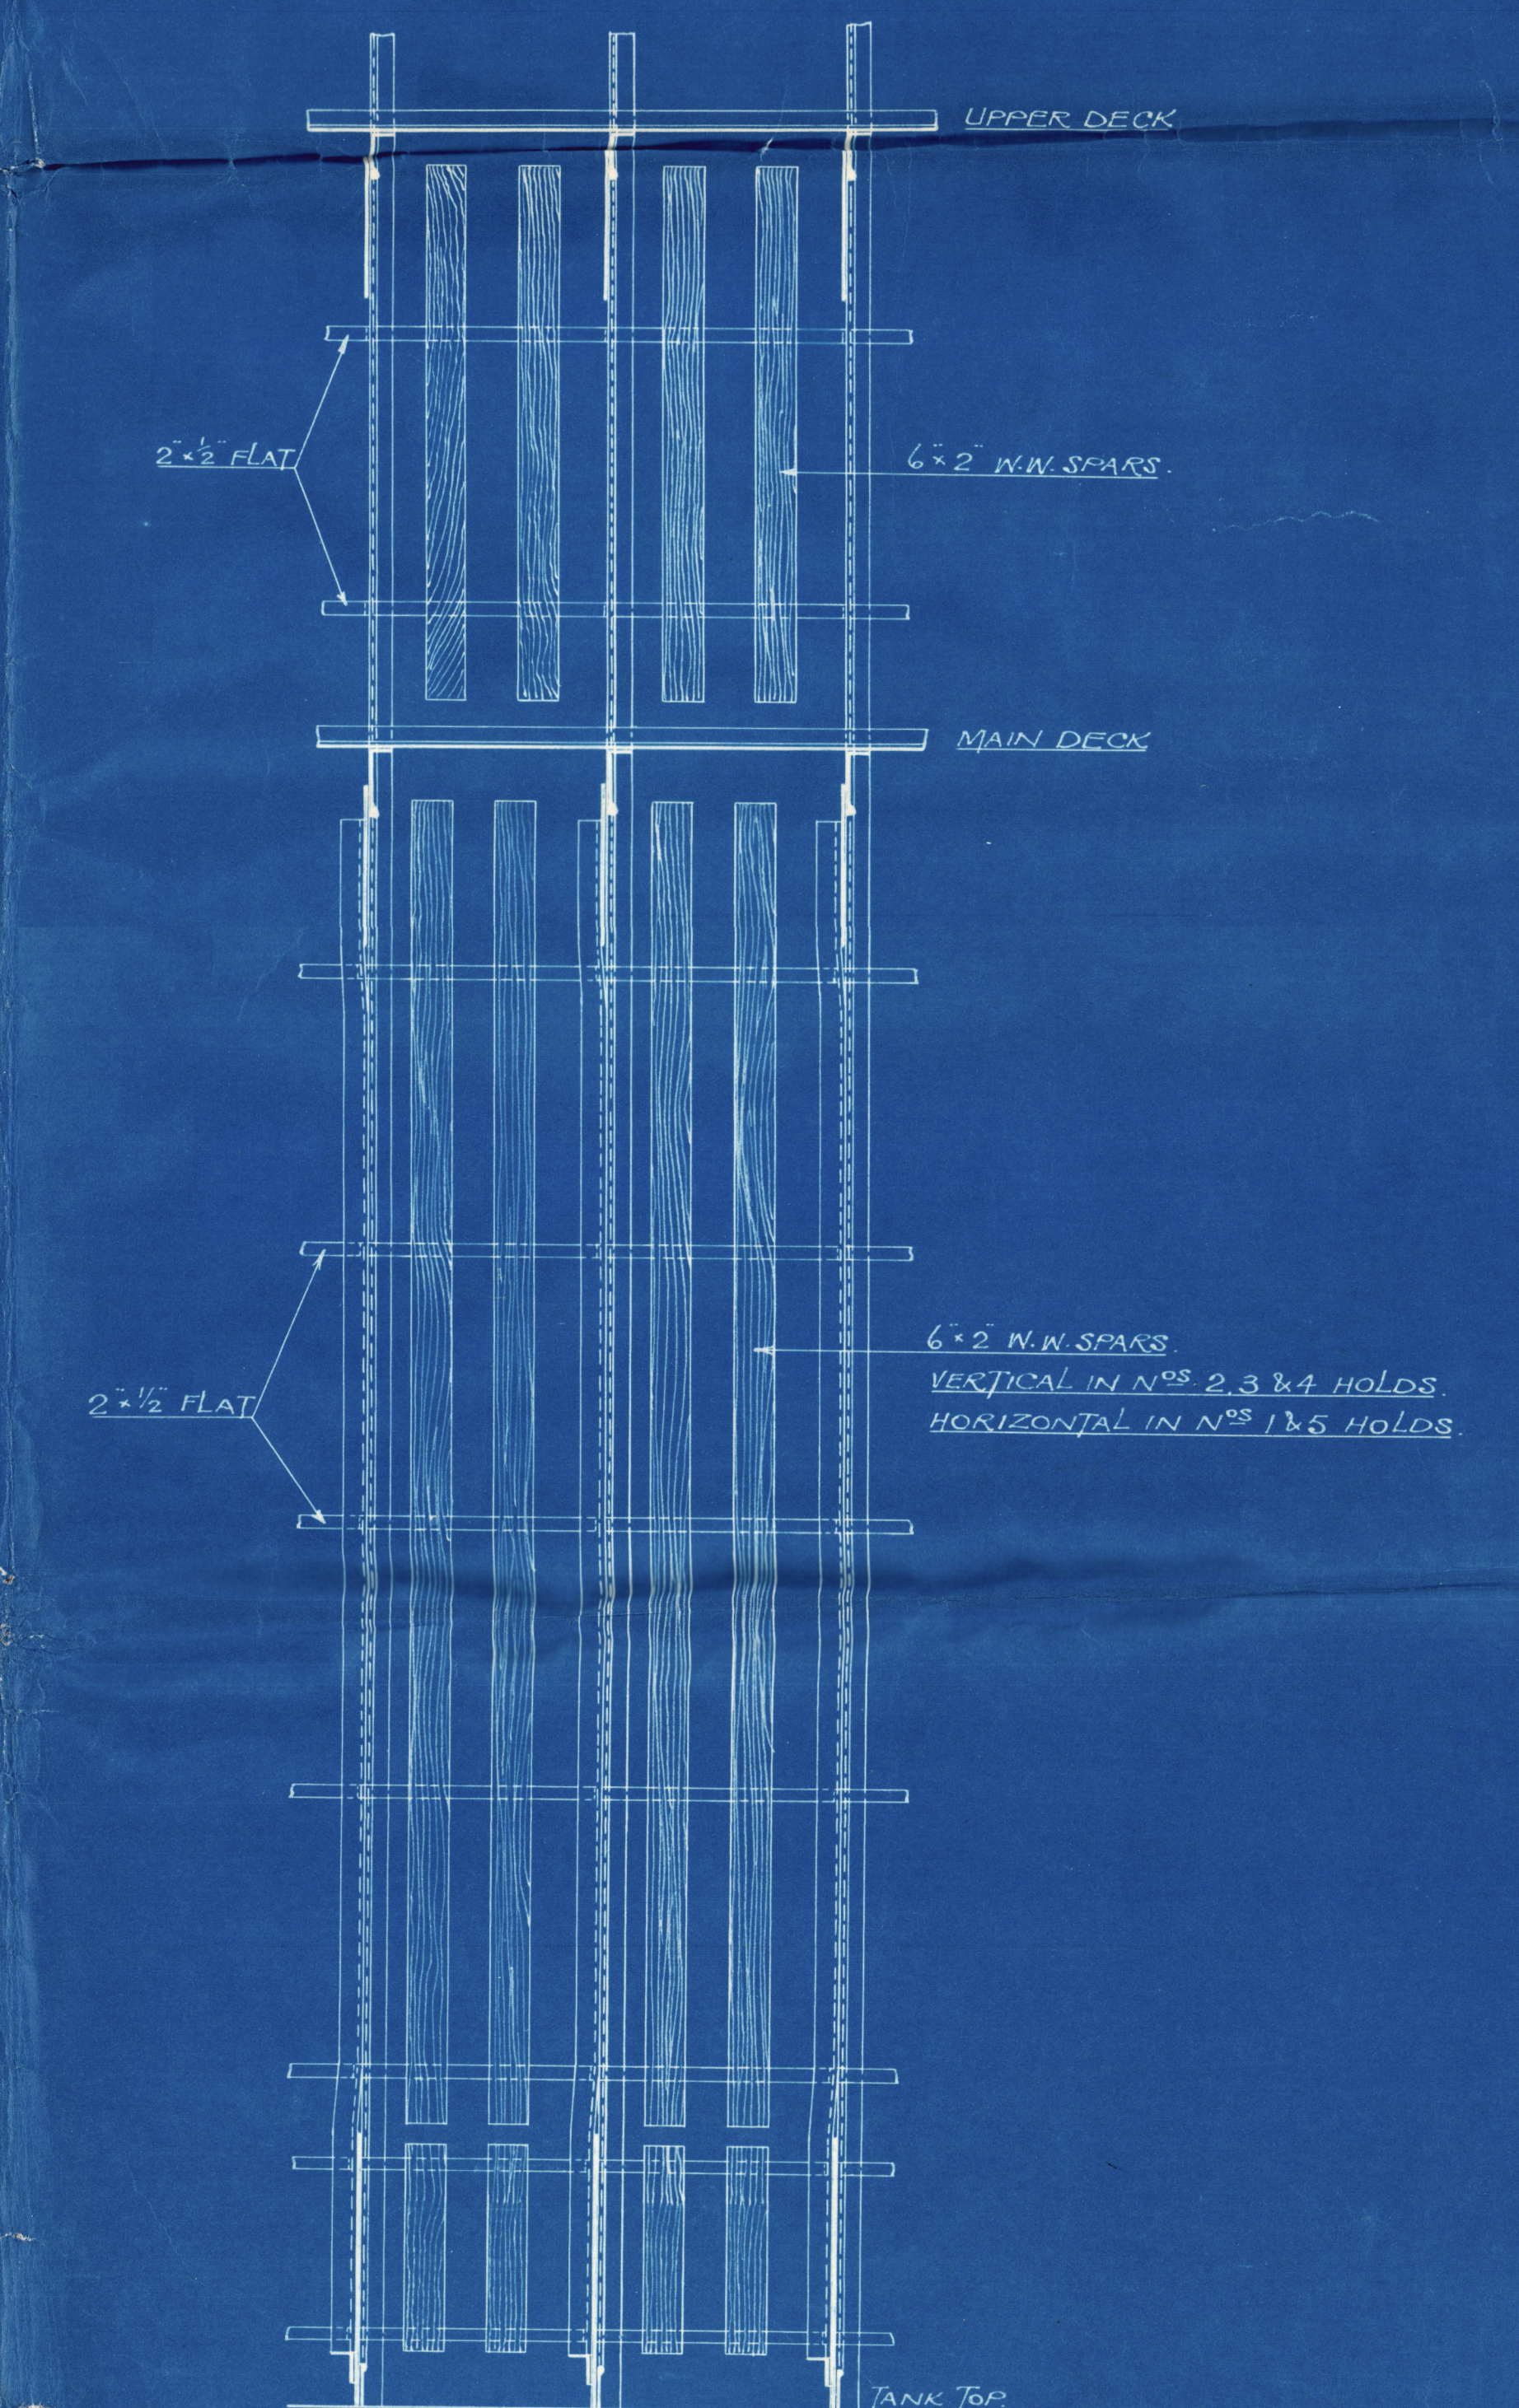


DECK PLATING - 25"

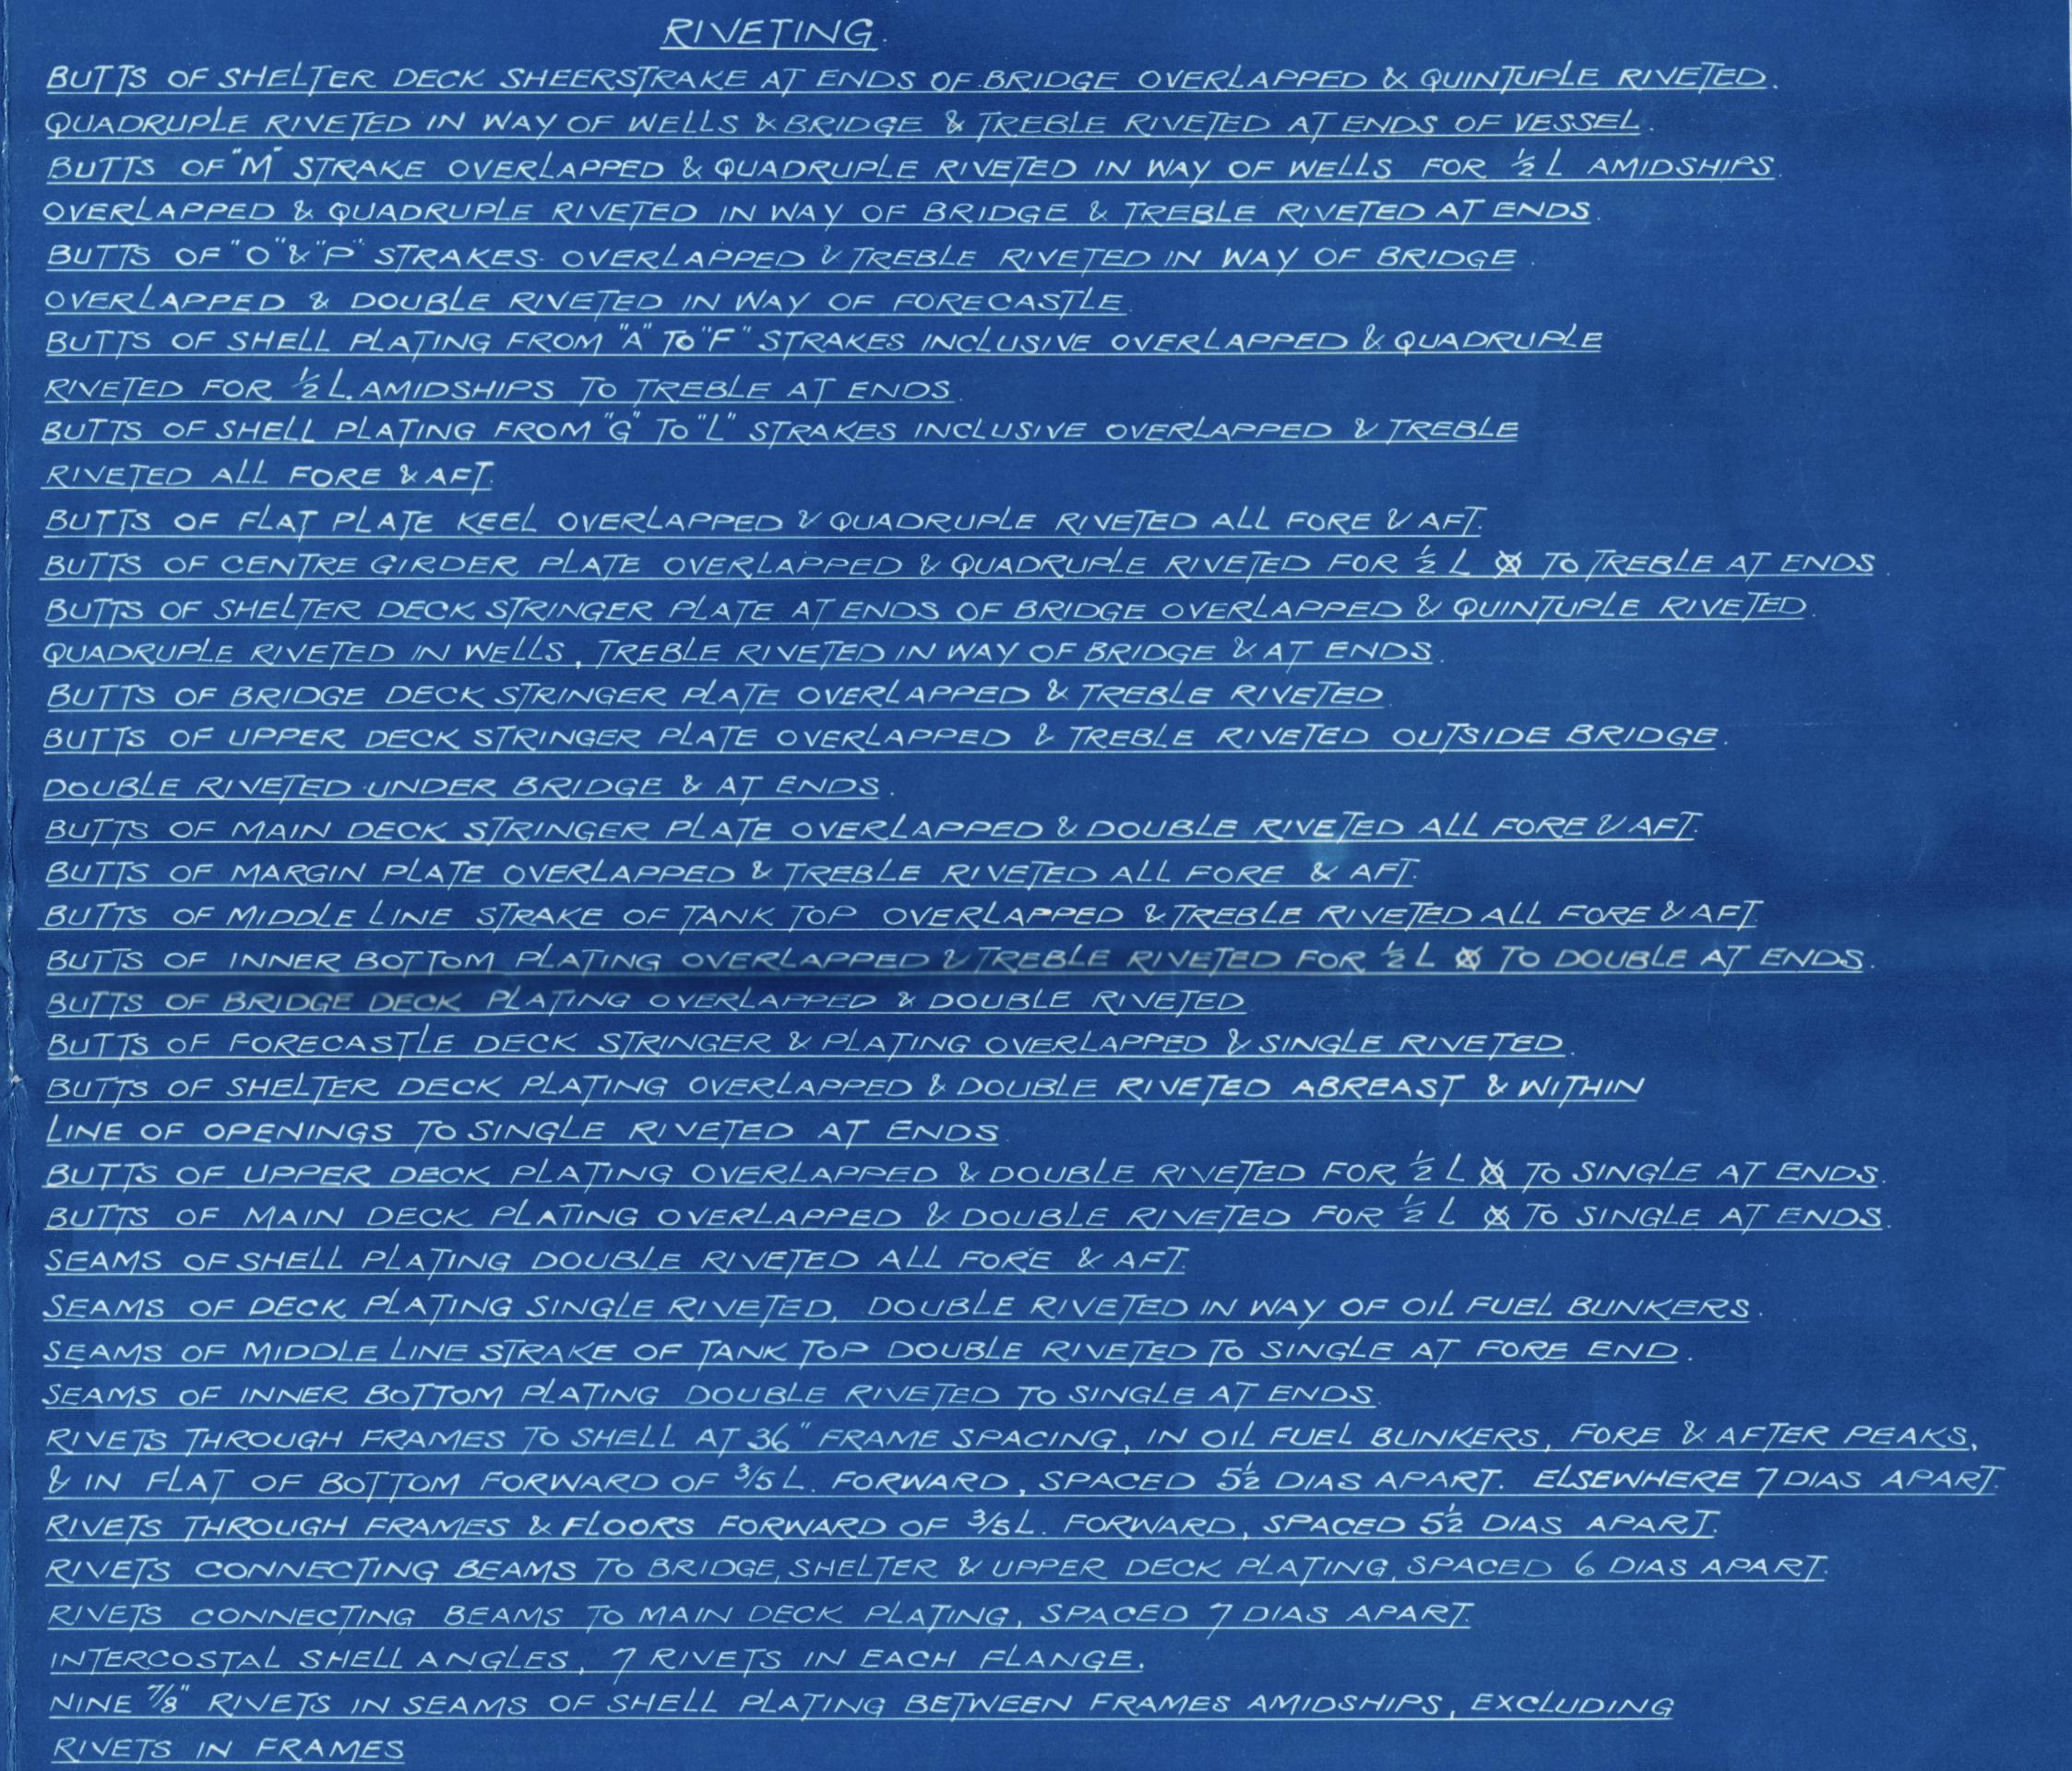

Hawthorn Leslie

No. 533

Mid. Section of vessel as built

S.S. TAKAMBA.

NEWCASTLE ON TYNE.

Report No. 78430.

W264-0234



© 2019

Lloyd's Register
Foundation