


S 1357.

Deckblatt
zur Hauptspantzeichnung.

Lade-Raum

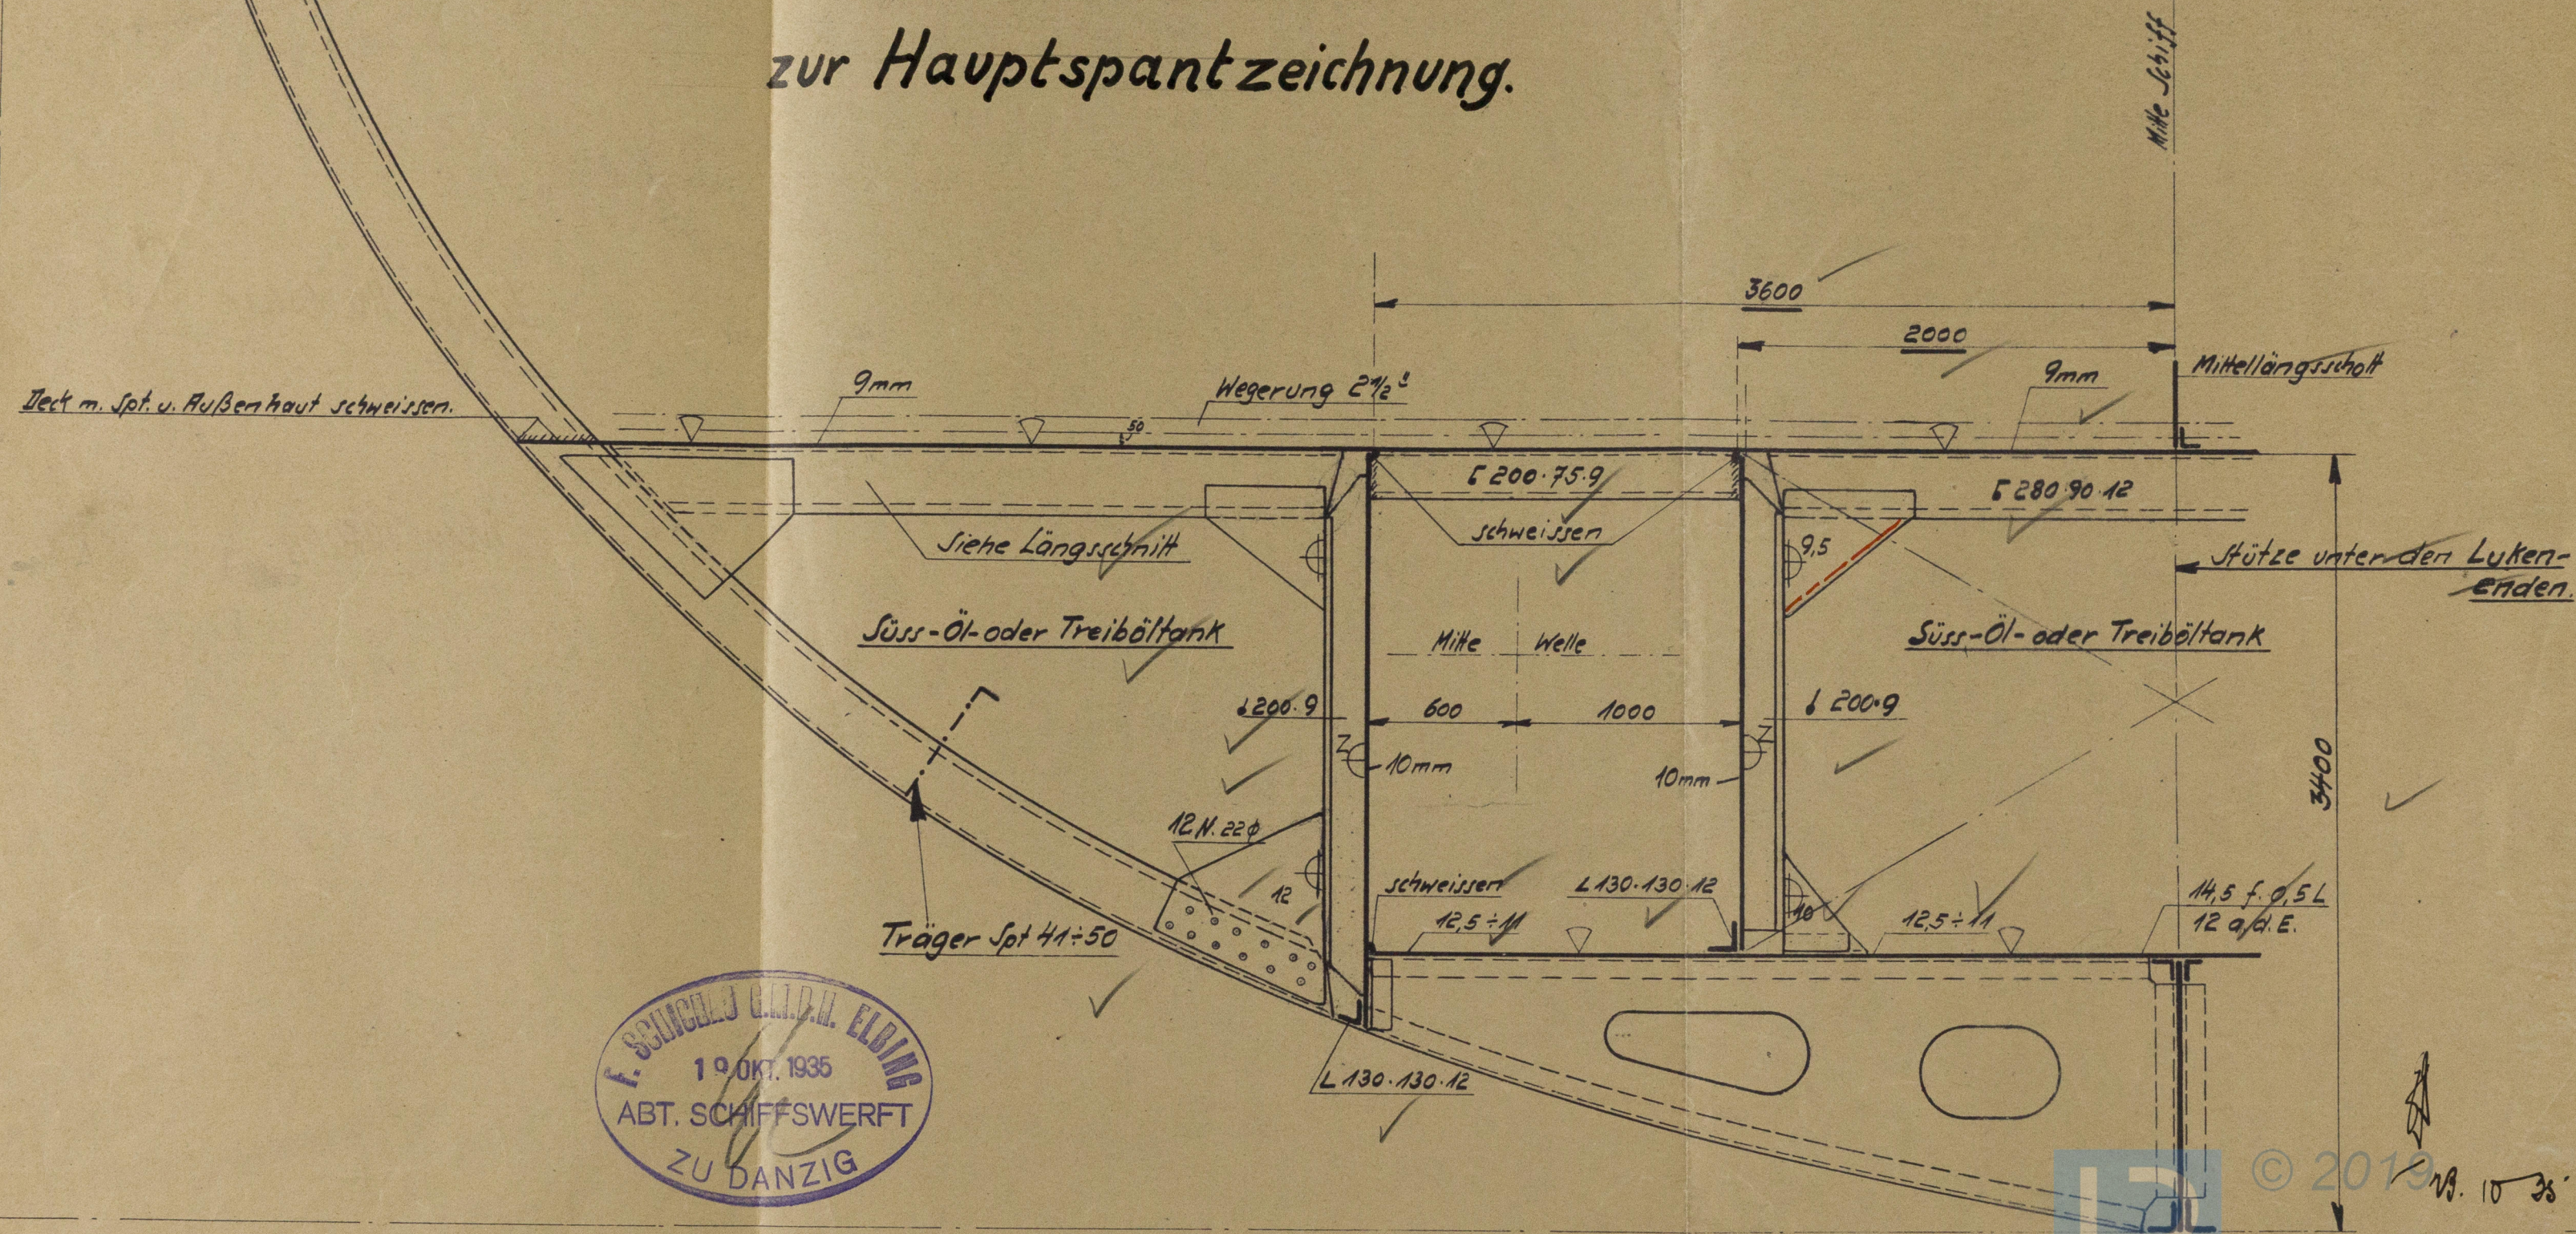

W264-0291

19. 10 28
H3509^a

GEN BOX NO 128

Schuman 135

Fly to Midship Sect

fly to mid. Sect.

Wm. TARIFF

TARIFF

DNE 12

18



© 2019

Lloyd's Register
Foundation

W264-029