


DONKEY BOILER.

TEST " 180 lbs

TO PASS LLOYDS SURVEY

The necessary lifters
to be fitted

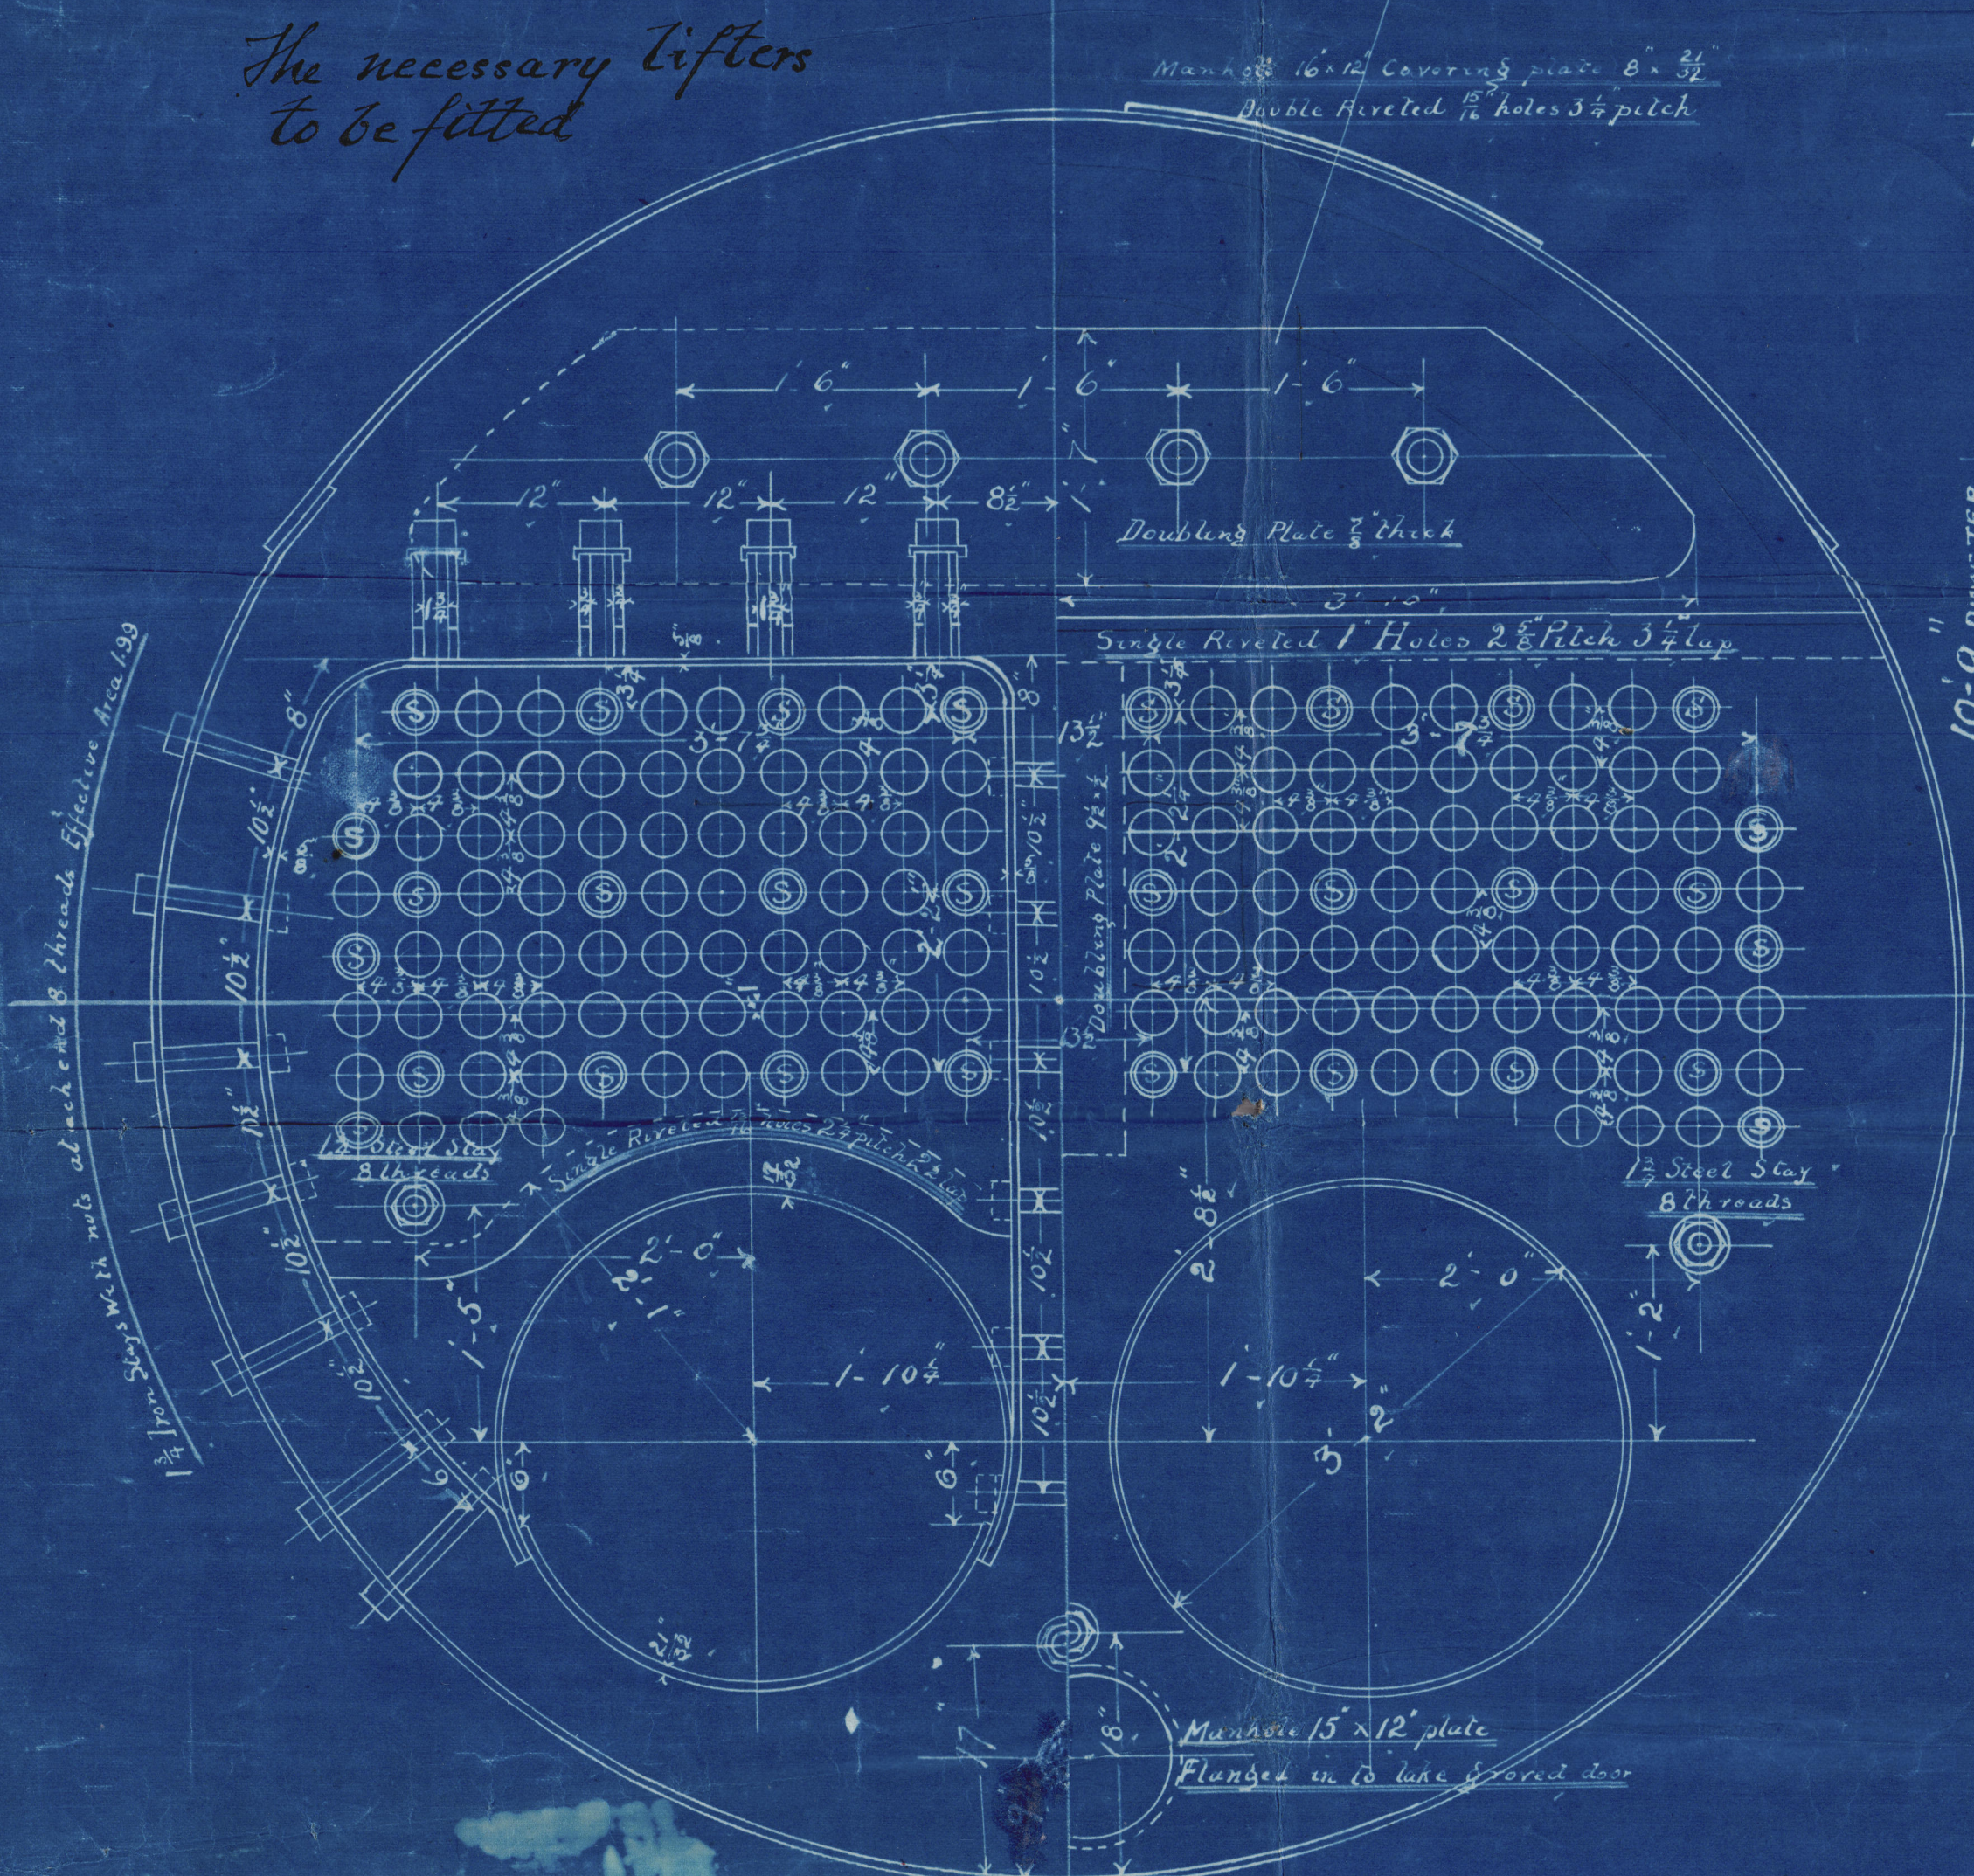


S. S. N^{OS} 4 62-463-464

HEATING SURFACE,

Tubes	1030.64 sq feet
Furnaces	96.50 "
Combustion Chambers	105.75 "
Tide Plates	33.28 "
Total	1266.17 "
Graze Surface	33. " "

SHELL RIVETING.
Plate $\frac{21}{32}$ " thick. Rivet Holes $\frac{1}{4}$ "

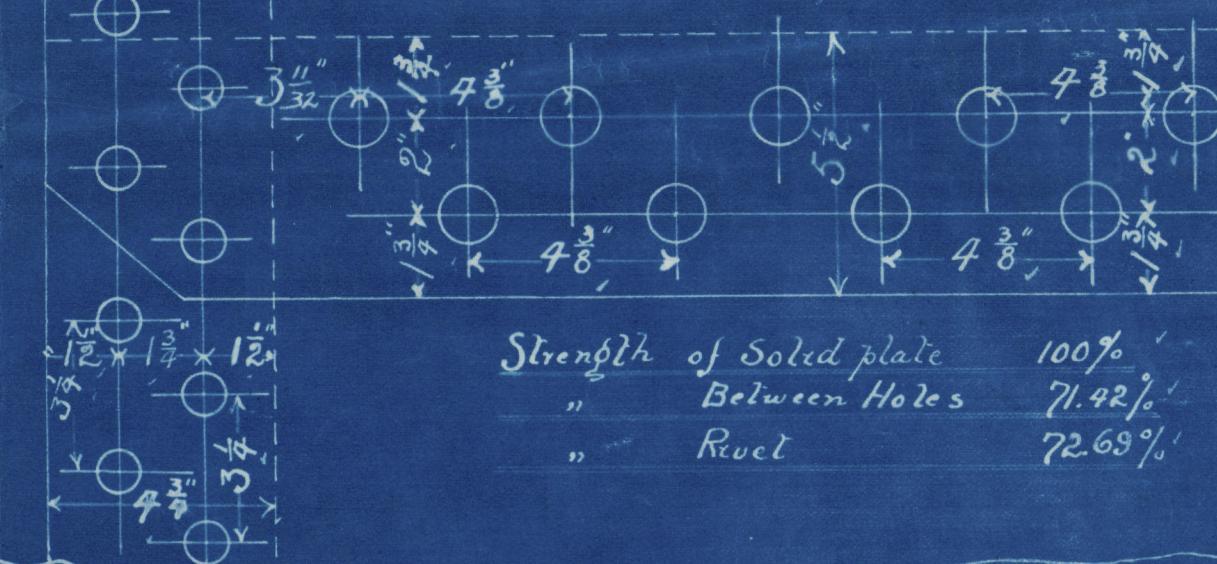

Strength of Solid plate	100%
" Between Holes	71.42%
" Rivet	72.69%

L.H.F. 4.
20/8/19. 4

DRG №3333

J. Readhead, & Sons

Nos 462, ~~463~~ & 464

Donkey Boilers

S.S. "TREVORIAN"

NEWCASTLE ON TYNE.

Report No. 43688.

W265-0120



© 2020

Lloyd's Register

Navigation