

NEDERLANDSCHE
SCHEEPSBOUW-MAATSCHAPPIJ
AMSTERDAM.

PLANTING DIMENSIONS	

LLOYD'S NUMBER 101 CLASS $+100 \text{ A I}$
 BREADTH $B = 54'$
 DEPTH $D = 30'$
 $(B+D) = 84' \checkmark$
 TRANSVERSE NUMBER $L = 420'$
 LENGTH BETWEEN BP
 LONGITUDINAL NUMBER
 $L \times (B+D) = 35280 \checkmark$


<u>BA DECK</u>		<u>EQUIPMENT NUMBER</u>	
2 x (B + D) =		35230	
FORE CASTLE BRIDGE AND POOP		2090	
REMAINING DECKHOUSES		434	
		<u>37004</u>	
 <u>EQUIPMENT</u>			
2 BOWERS, STOCKLESS		815 CWTs EACH	✓
1 BOWER,		70.2 "	700-3 FLO ✓
STR 44M GNCHOR EXCL: ST CR		19 "	✓
KEDGE "		"	
270 FATHOMS 2 5/8" STUD CHAIN CABLE MIN WEIGHT		720-3-4	✓
90		CIRC 4" 5 STEEL WIRE FOR STEERING BLOCK	
120		" " " " TOWLINE	✓
HAWSEYS & WHARFS			
2 x 90 FATHOMS		8" CIRC PENNYL ✓	
2 x 90		4" " "	

[illegible]

STEM	$10\frac{1}{2}'' \times 2\frac{3}{4}''$	✓
PROPELLER POST	$10\frac{1}{2}'' \times 8''$	✓
RUDDER	$9 \times 8''$	✓

BRACKETFLOOR IF JETFLOOR'S
ARE FITTED ON EVERY SECOND FRAME


30.3.14

3rd floor to be fixed under Equest. only beams, 10 I-beams & braced brackets
formed of $\frac{3}{8}$ " and braced floor under church.

W.H.: all had measured in in floor space as required by footnote (a) Table 8

shocks


→ Note:- If soil found one foot to every 25 ft. reduction to be made in thickness of bottom plating in way of double bottom.

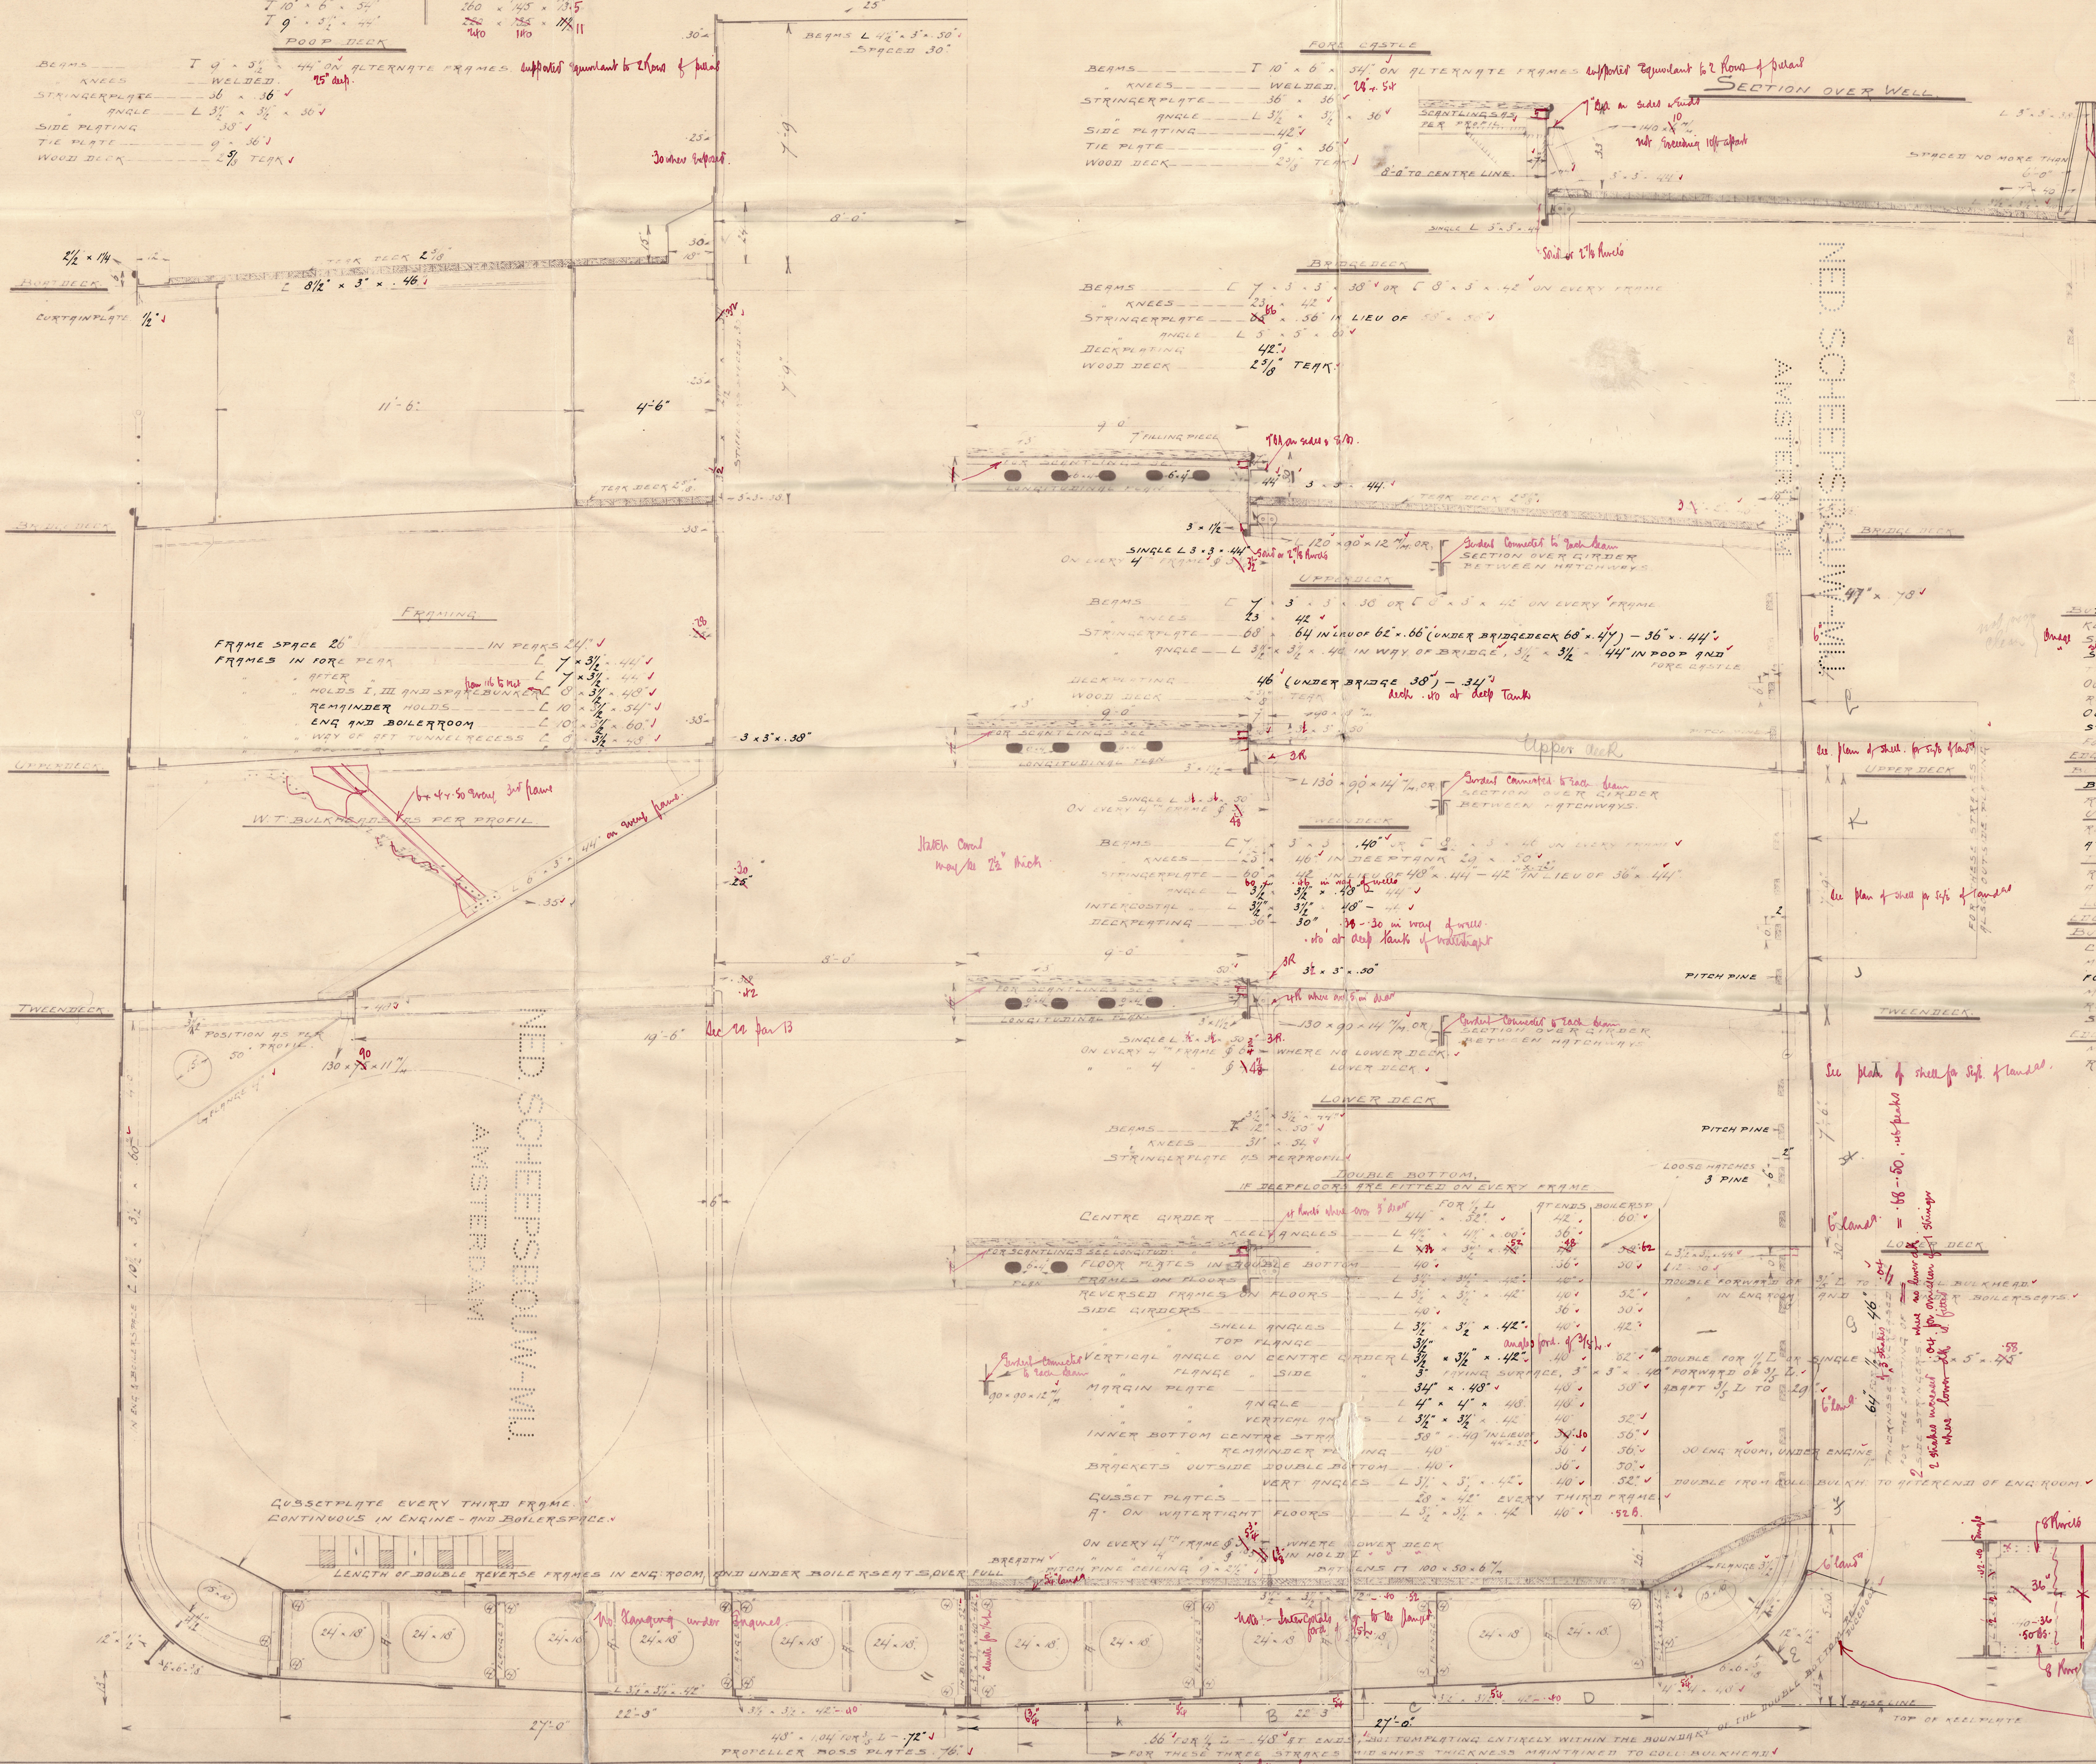


Ked Tjisalak

Java China Japan line



Midship Section

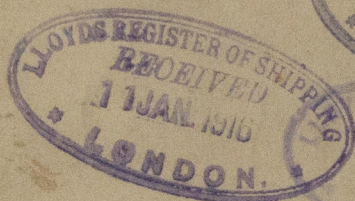

Tjisalak

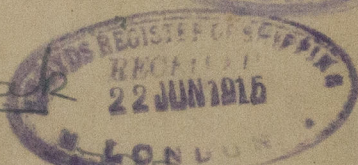

Stms. 1205

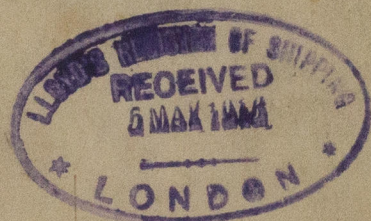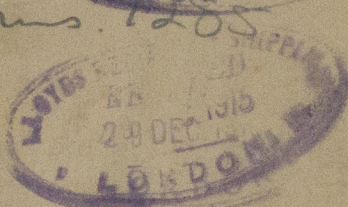

W265-0139



© 2020

Lloyd's Register
Foundation