

9.3.14
1.6.14
3.7.14

PROPORTIONS
DEPTHS IN LENGTH TO UPPER DECK 11.36
BRIDGE 9.54

NUMERALS

TRANSVERSE NO	B+D 79.50
LONGITUDINAL	L(B+D) 28.990
36.66 (79.50)	

EQUIPMENT

3 BOWERS	160 STOCKLESS
1 STREAM	15 EX STOCK
1 KEDGE	6 1/2
270 FATHOMS	2 1/2 STUD CHAIN
30	1 1/2 STREAM OR 4 1/2 WIRE
120	4 1/2 WIRE
90	7 MANILLA OR 3 STEEL WIRE
90	7
180	7



PER SPECIFICATION

S.S. N° 650
MIDSHIP SECTION
SCALE 1/2" = 1 FOOT
CLASS 100 A.I. LLOYDS

365'-0" x 49'-0" M.P. x 30'-6" M.P.
364'-66 Rule length as per Builders letter 9/3/14.

EQUIPMENT NO

LONGITUDINAL NO	28990.47
POOP & FORECASTLE	73' x 7' 25' x 75 396.94
BRIDGE	131' 7 1/2' x 7' 75' 765.02
DECKHOUSES	113' 00' x 7' 50' x 50 446.25
	30598.68

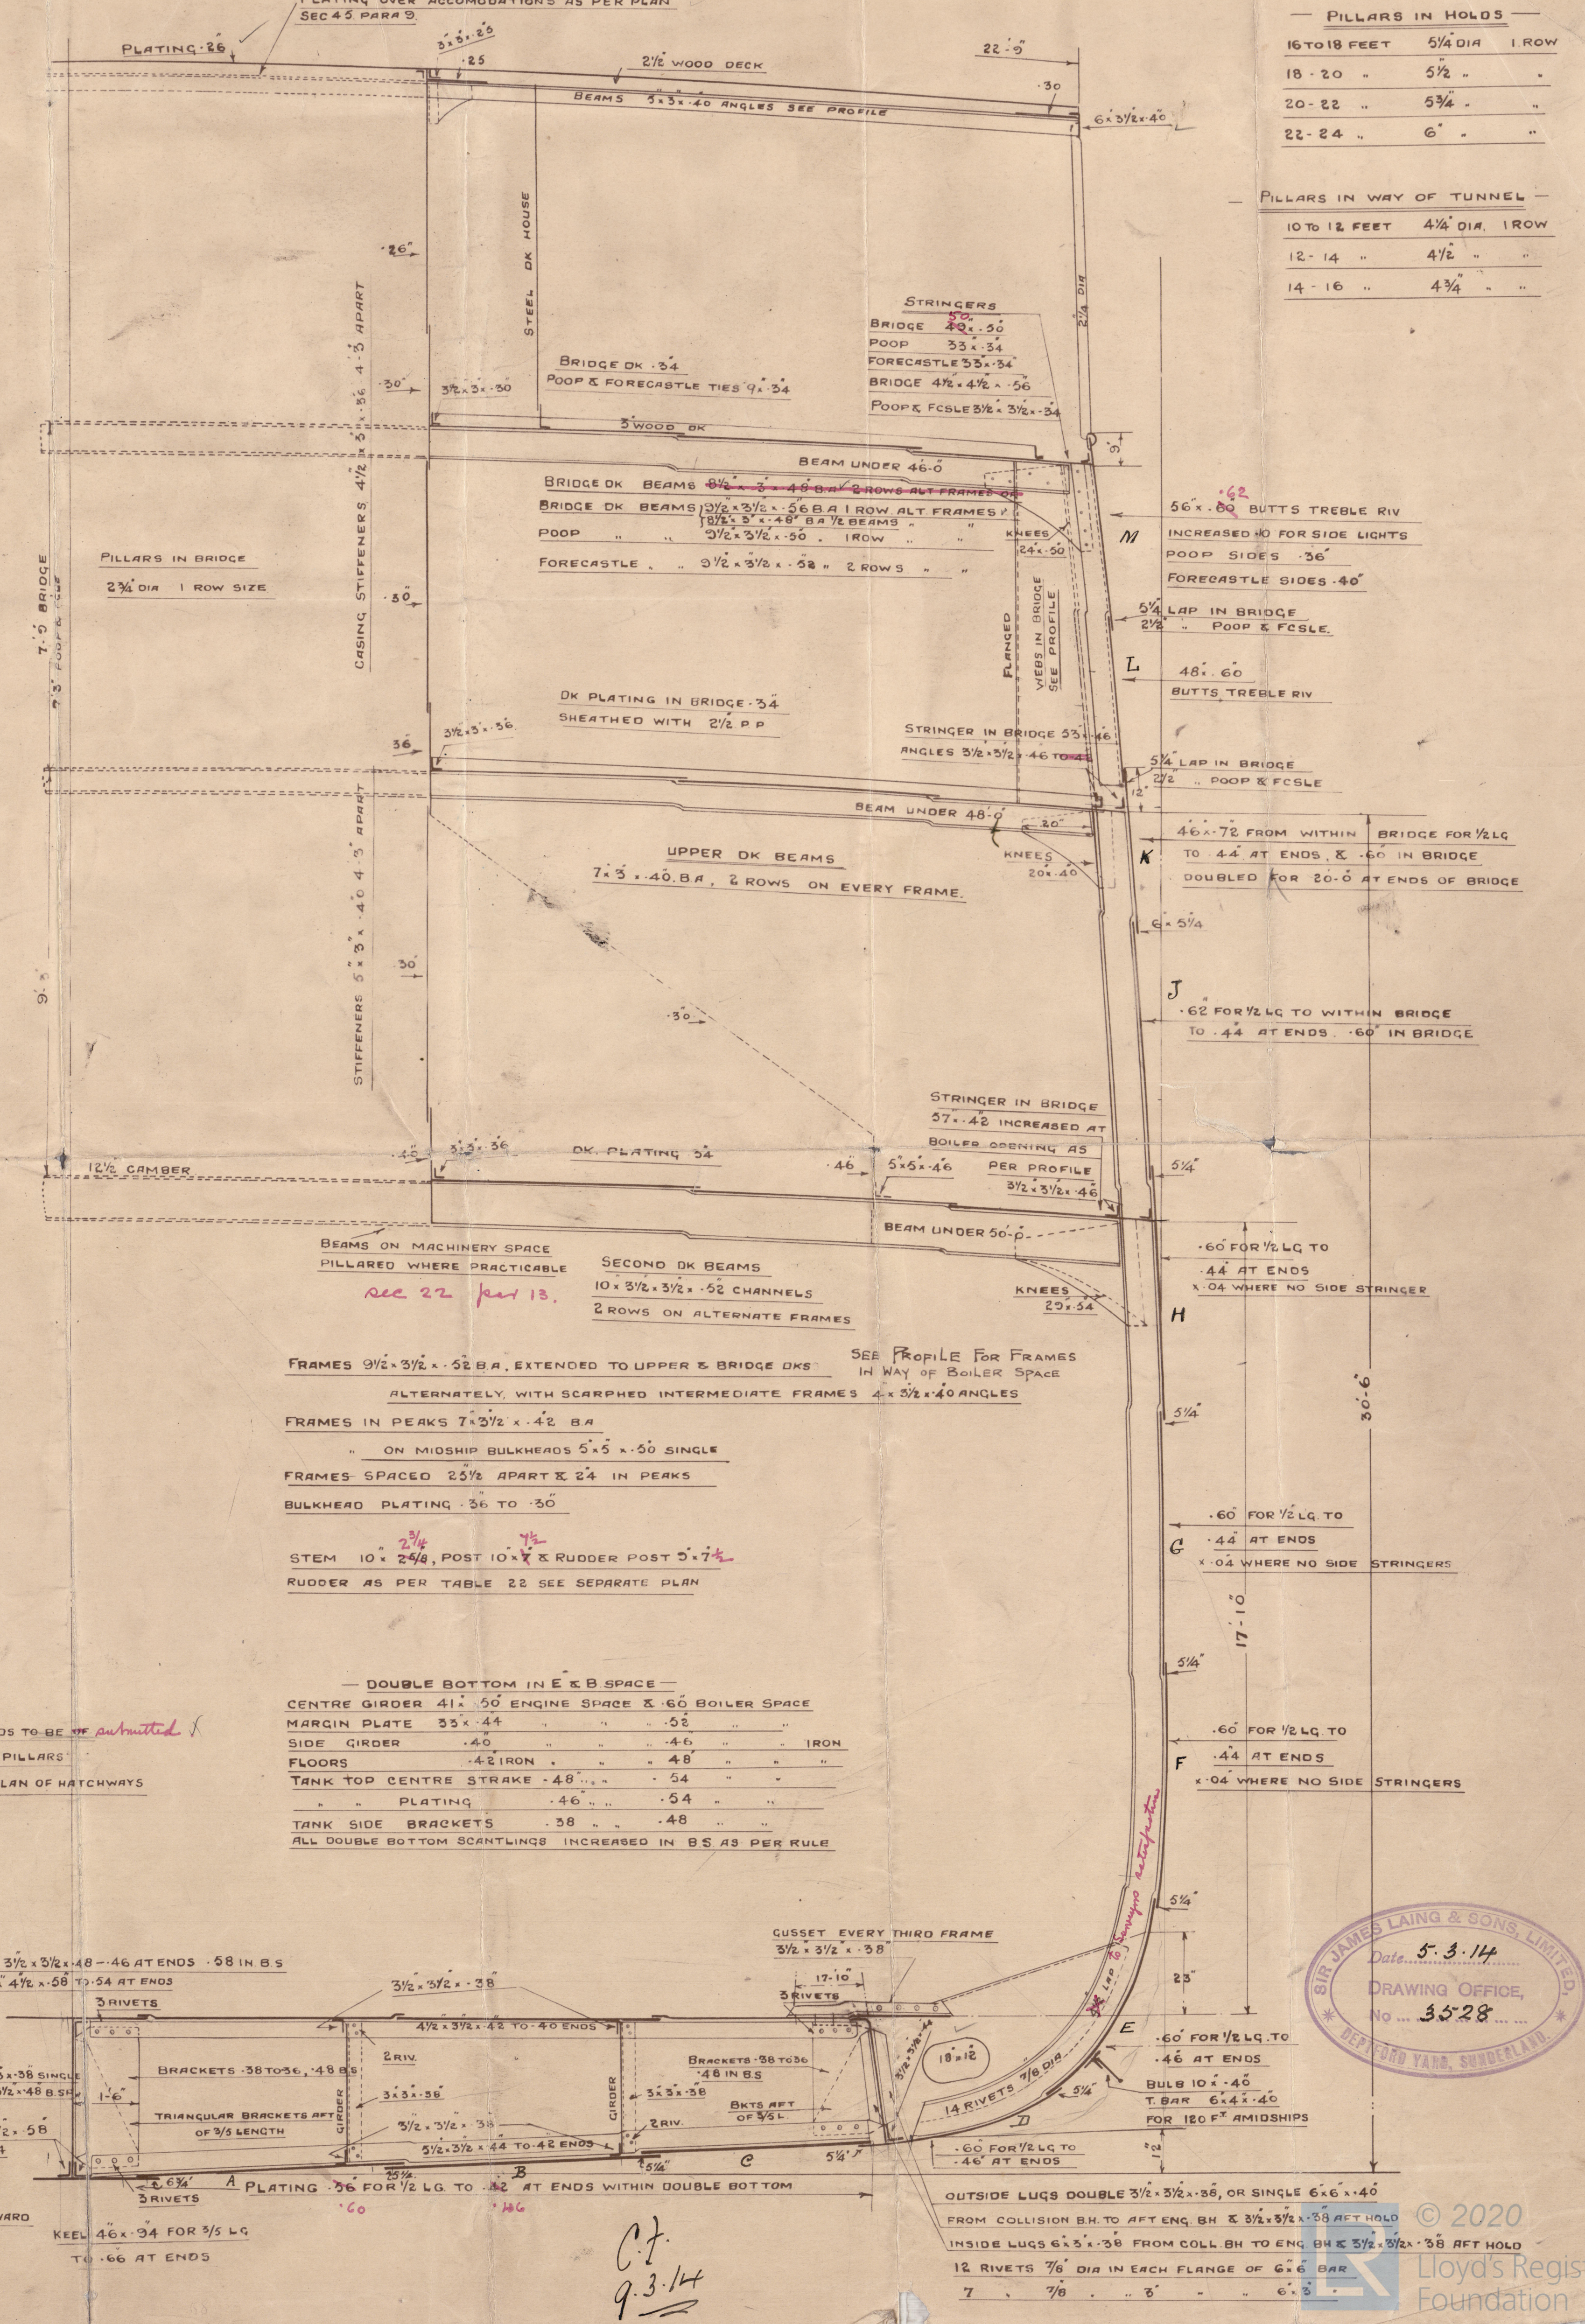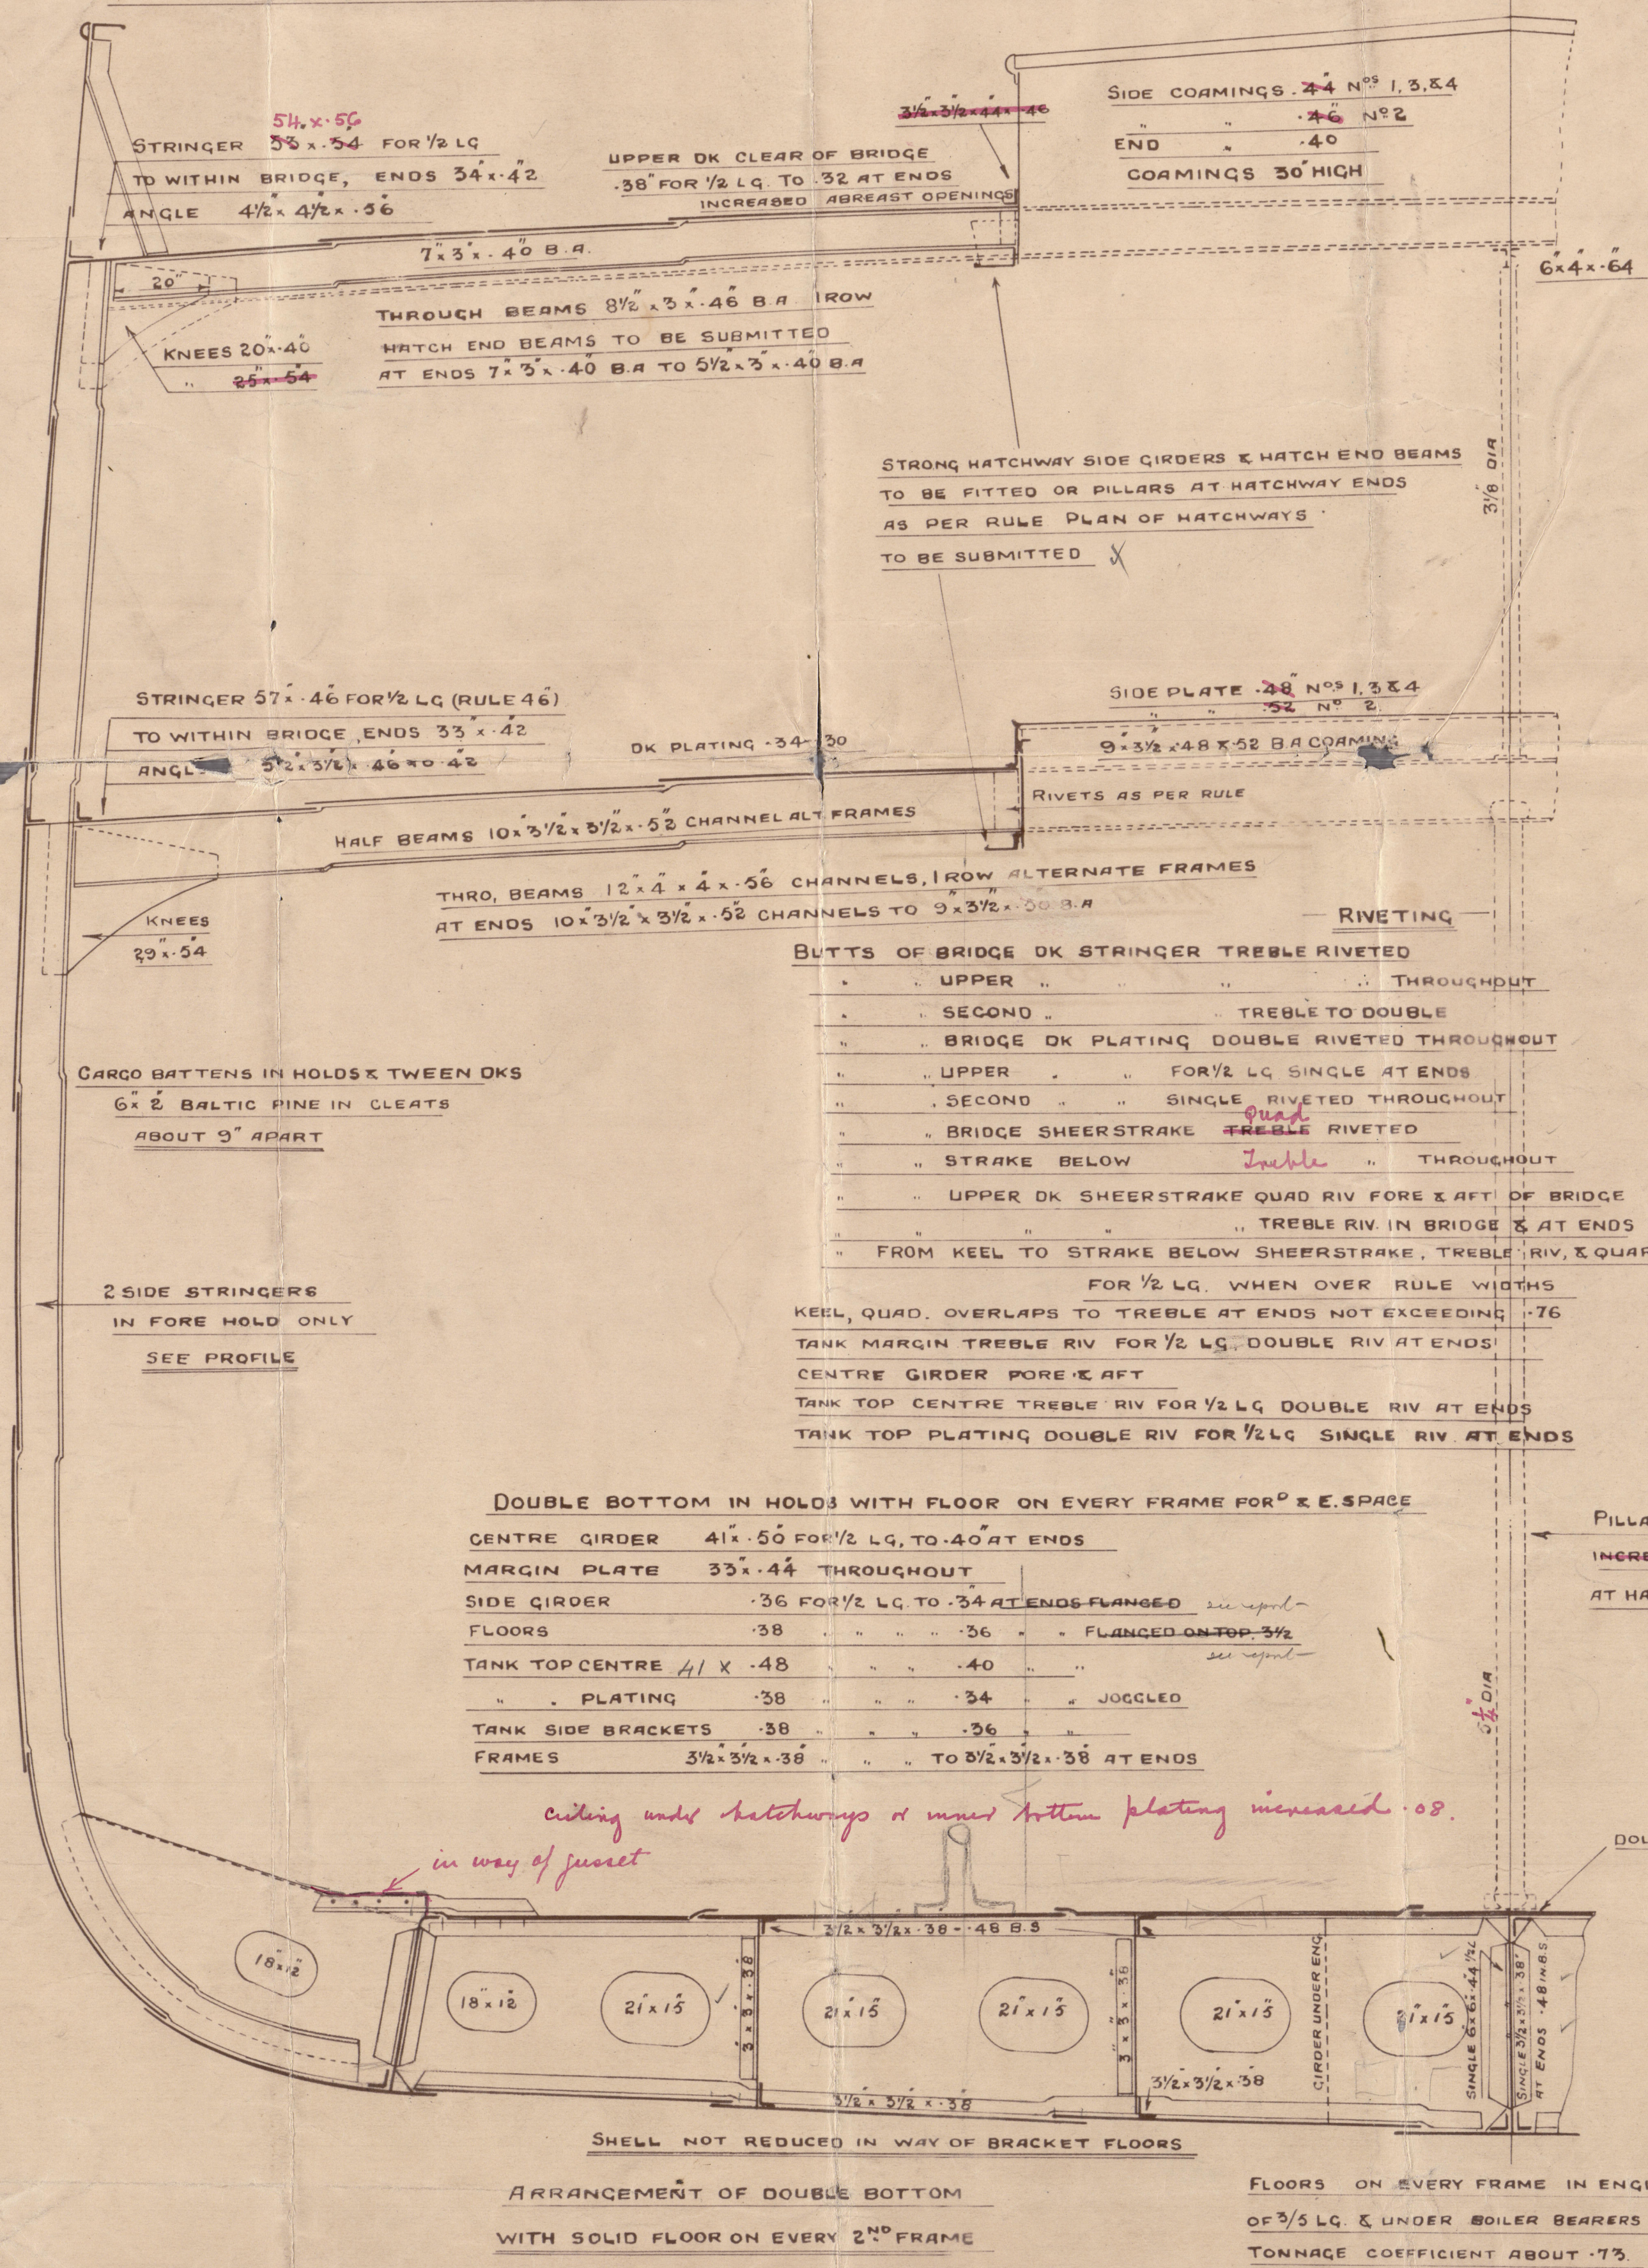


PILLARS IN HOLDS

16 TO 18 FEET	5 1/4 DIA	1 ROW
18 - 20	5 1/2	
20 - 22	5 3/4	
22 - 24	6	

PILLARS IN WAY OF TUNNEL

10 TO 12 FEET	4 1/4 DIA	1 ROW
12 - 14	4 1/2	
14 - 16	4 3/4	

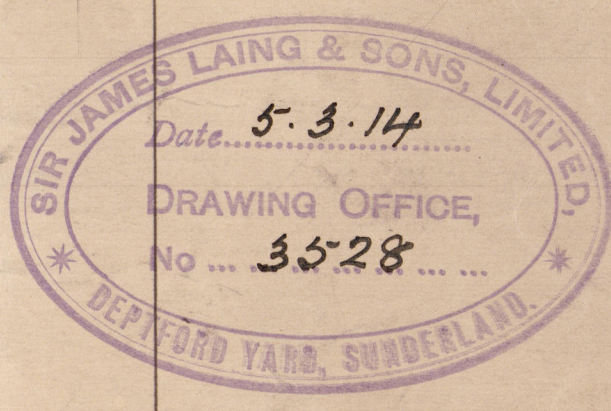

W266-0149






© 2020

Lloyd's Register
Foundation

Mr J. Lamy & Sons


MID. SECTION

N^o 650

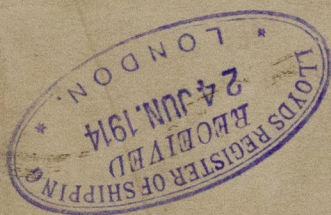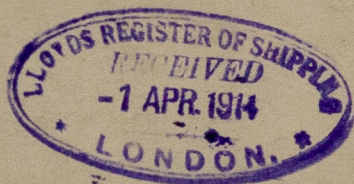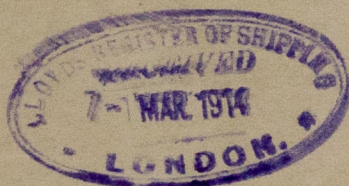

S/S Unwound

SUNDERLAND RPT. NO. 26299

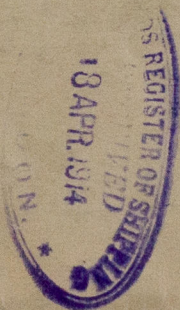

© 2020

W266-0149
Lloyd's Register
Foundation