
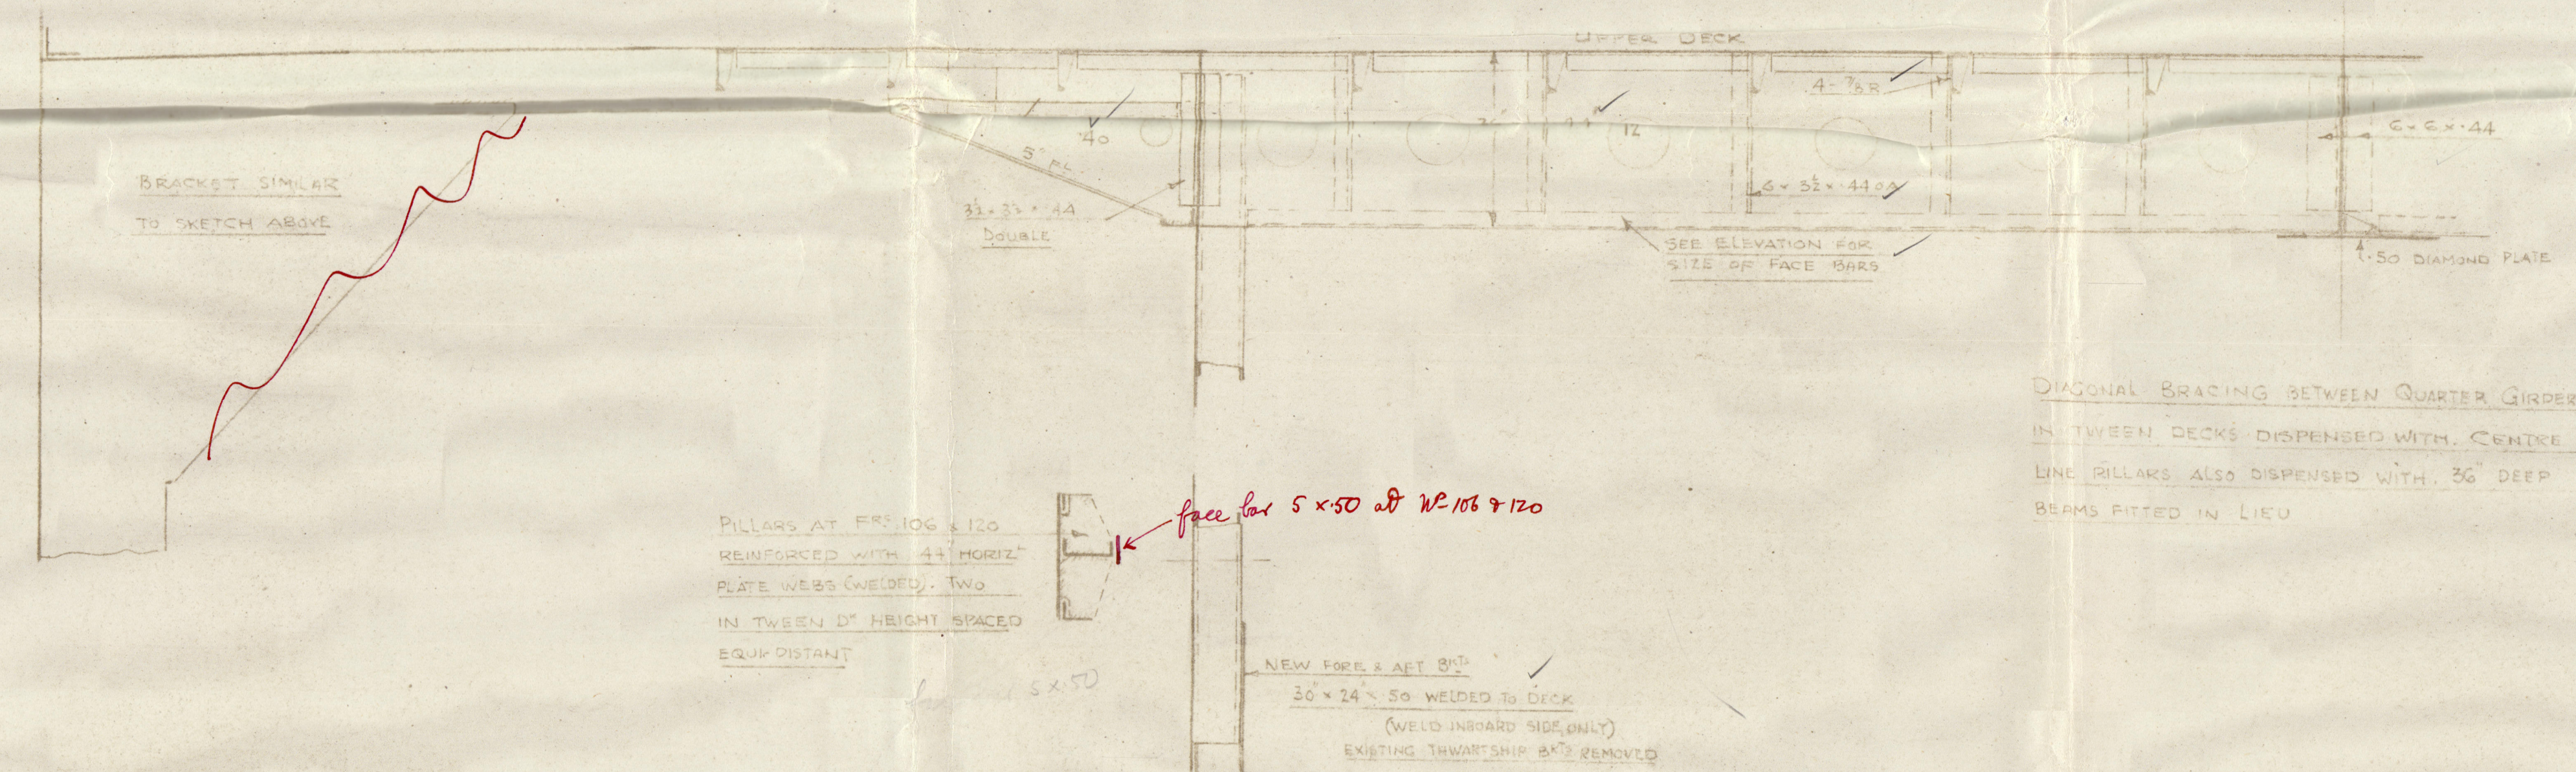


21 JUL 1942

SCALE :- $\frac{1}{8}$ " = 1 FOOT.

all existing openings in deck for entrance to blubber bunks
to be plated over to Surveyor's satisfaction

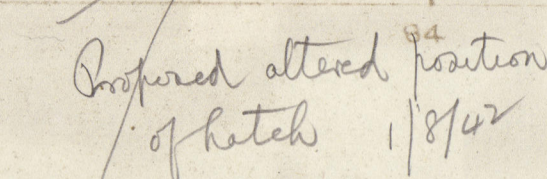


W.S.
21. Y. 42.

Vestfold

Alteration plan.

Nwc. 100713.

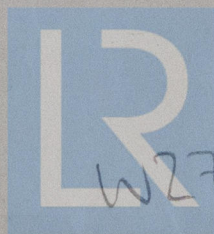

© 2019

Lloyd's Register
Foundation