


VESTFOLD

SCALE 3/8"

CARGO ON DECK - UNITS
 48' x 32' x 40T
 27' x 32' x 20T
 50' x 14' x 12' x 22T
 36' x 12' x 7 1/2 T
 44' x 32'-8" x 10'-8" x 6T

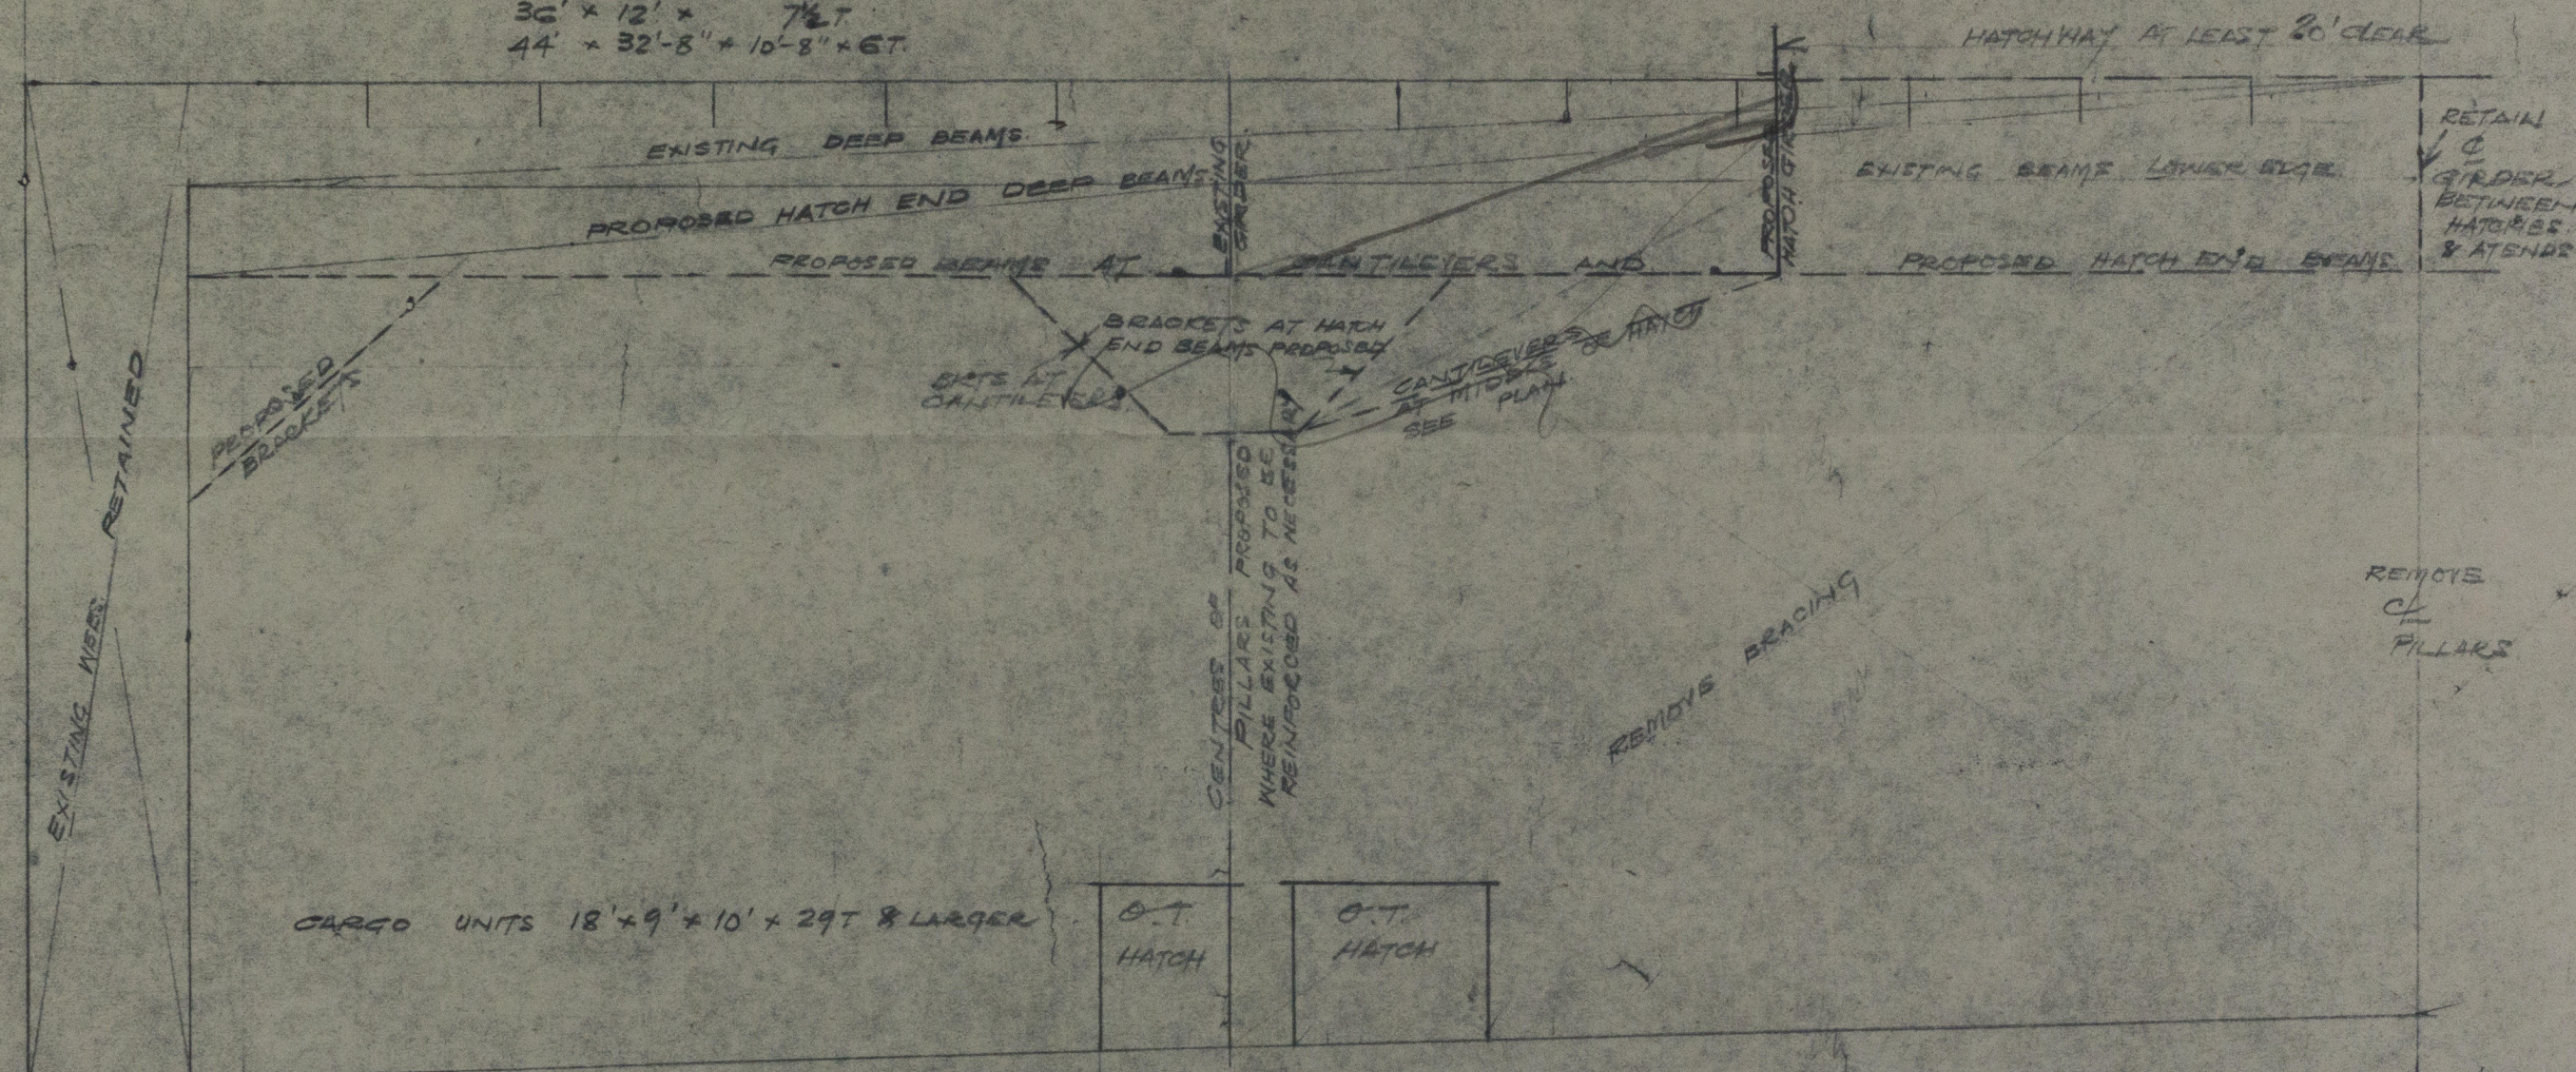

HATCHES IN "TAFELBERG" NO. 1. 27'-6" x 20'
 2. 46'-3" x 20'
 3. 45'-3" x 20'

HATCHES IN "VESTFOLD" TO APPROXIMATE SIMILAR DIMENSIONS IF EXISTING STRUCTURE PERMITS.

"Vestfold"

Alteration plan.

Nwc. 100413.



© 2019

Lloyd's Register
Foundation

W270-0032