
 
 
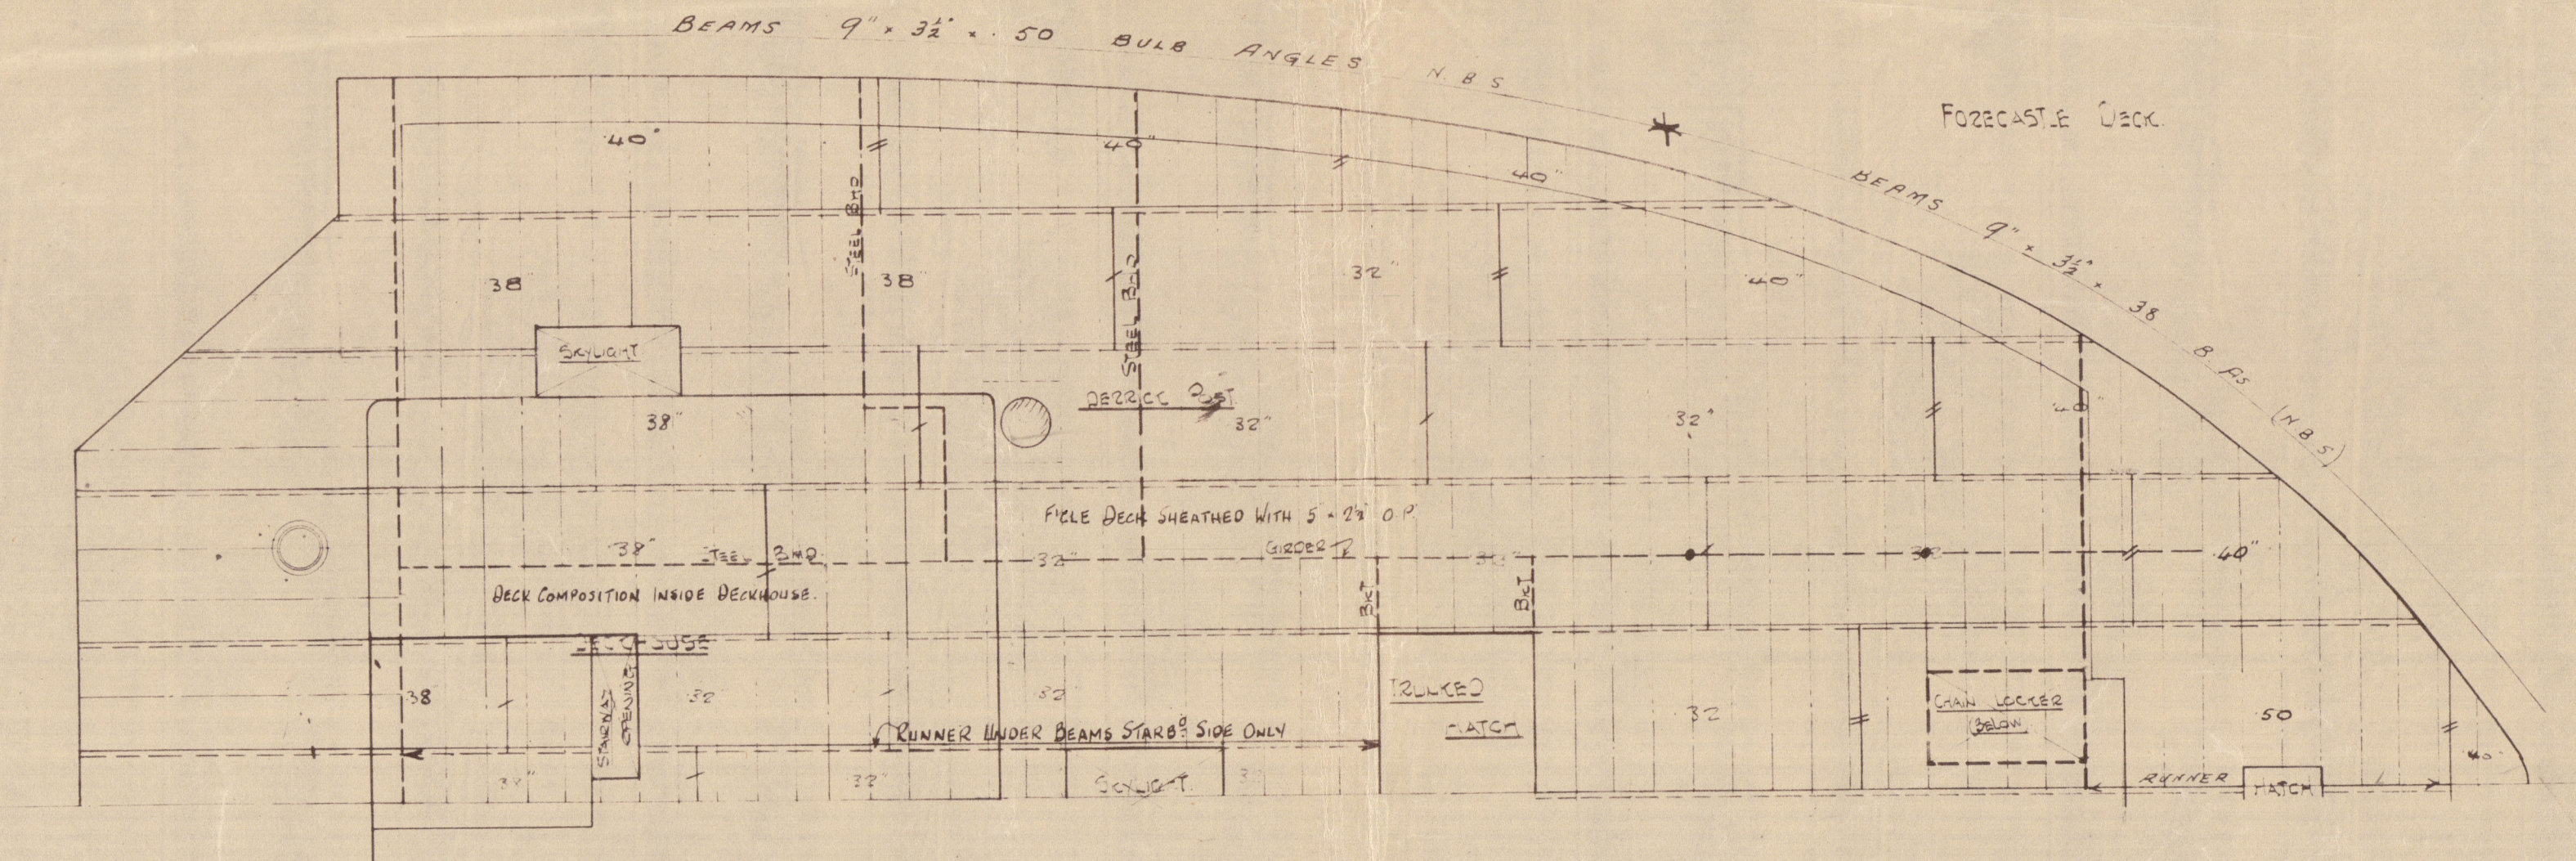


183
PROFILE AND DECK PLANS.

DIMENSION 220' 0" 23' 74' 0" 10' 40' 0"

SCALE 1" = 10'

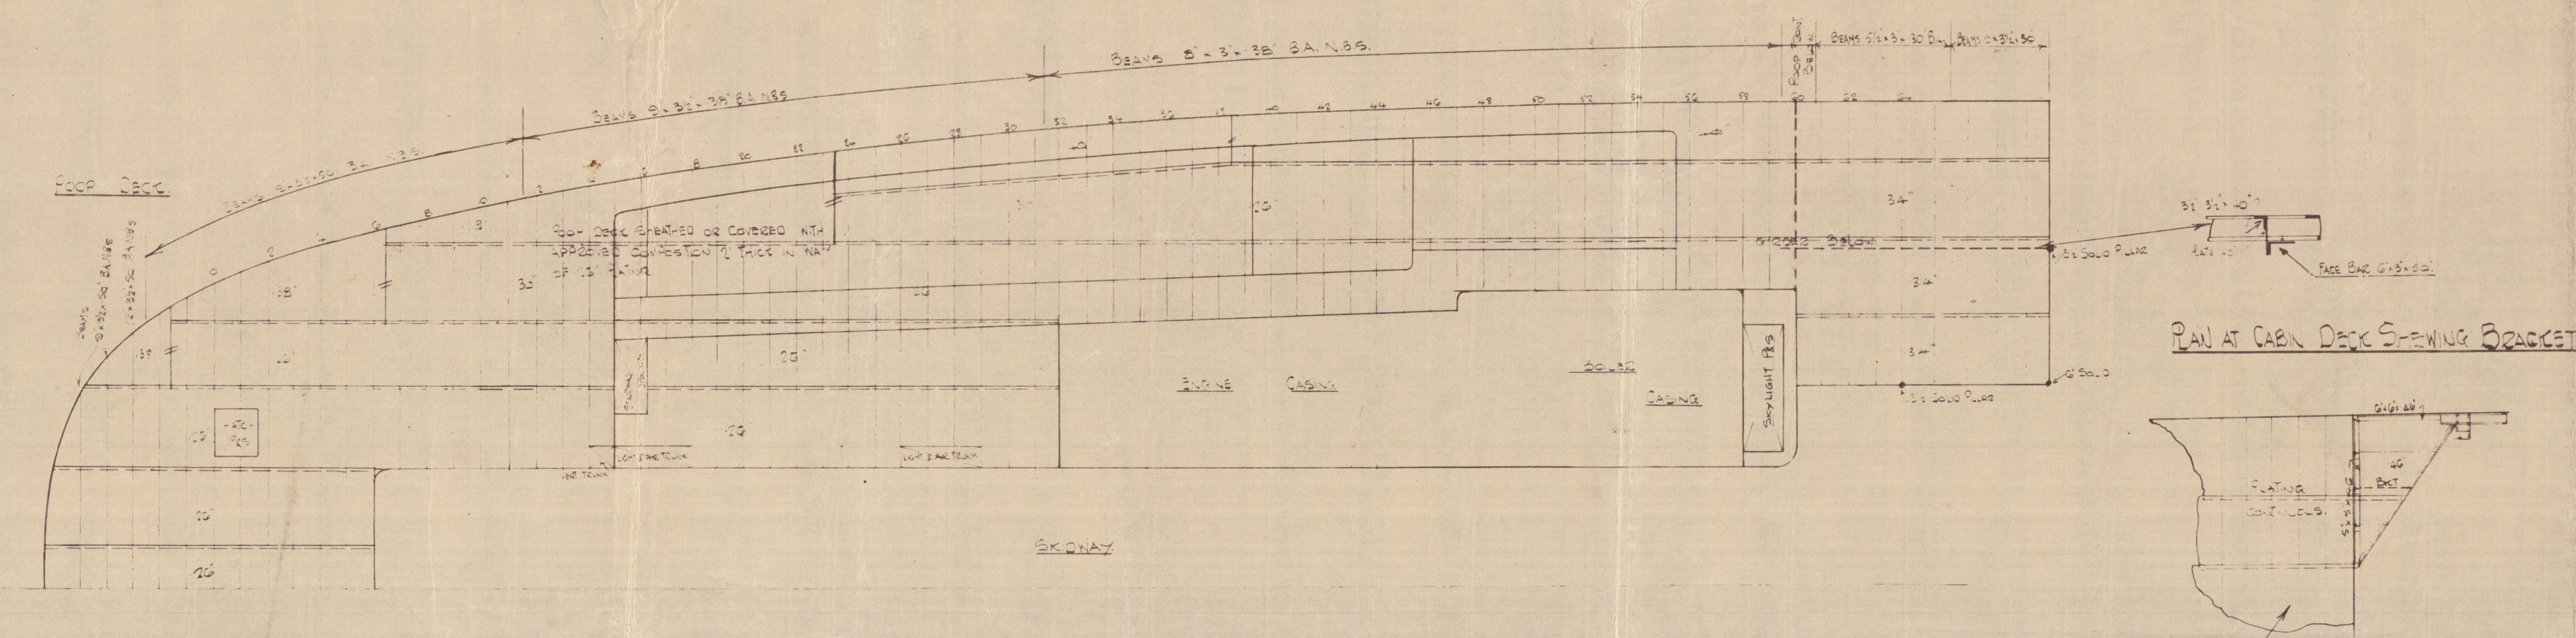

FURNESS S.B. CO


No 189 - ~~190~~

"VESTFOLD"

PROFILE & DECK PLANS

AS BUILT.

S.S. Vestfold
MDB. RPT. No. 14446

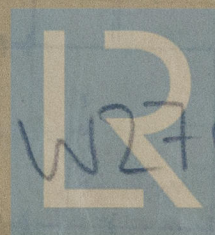

© 2019

W270-0055

Lloyd's Register
Foundation