

 


— 188-30 —
 — PROFILE AND DECK PLAN —
 DIMENSION 235' 0" 3" x 74' 0" 12" x 45' 3"
 SCALE 1" = 10'

 

Profile deck plan
as built
Turner & B Co
189/190

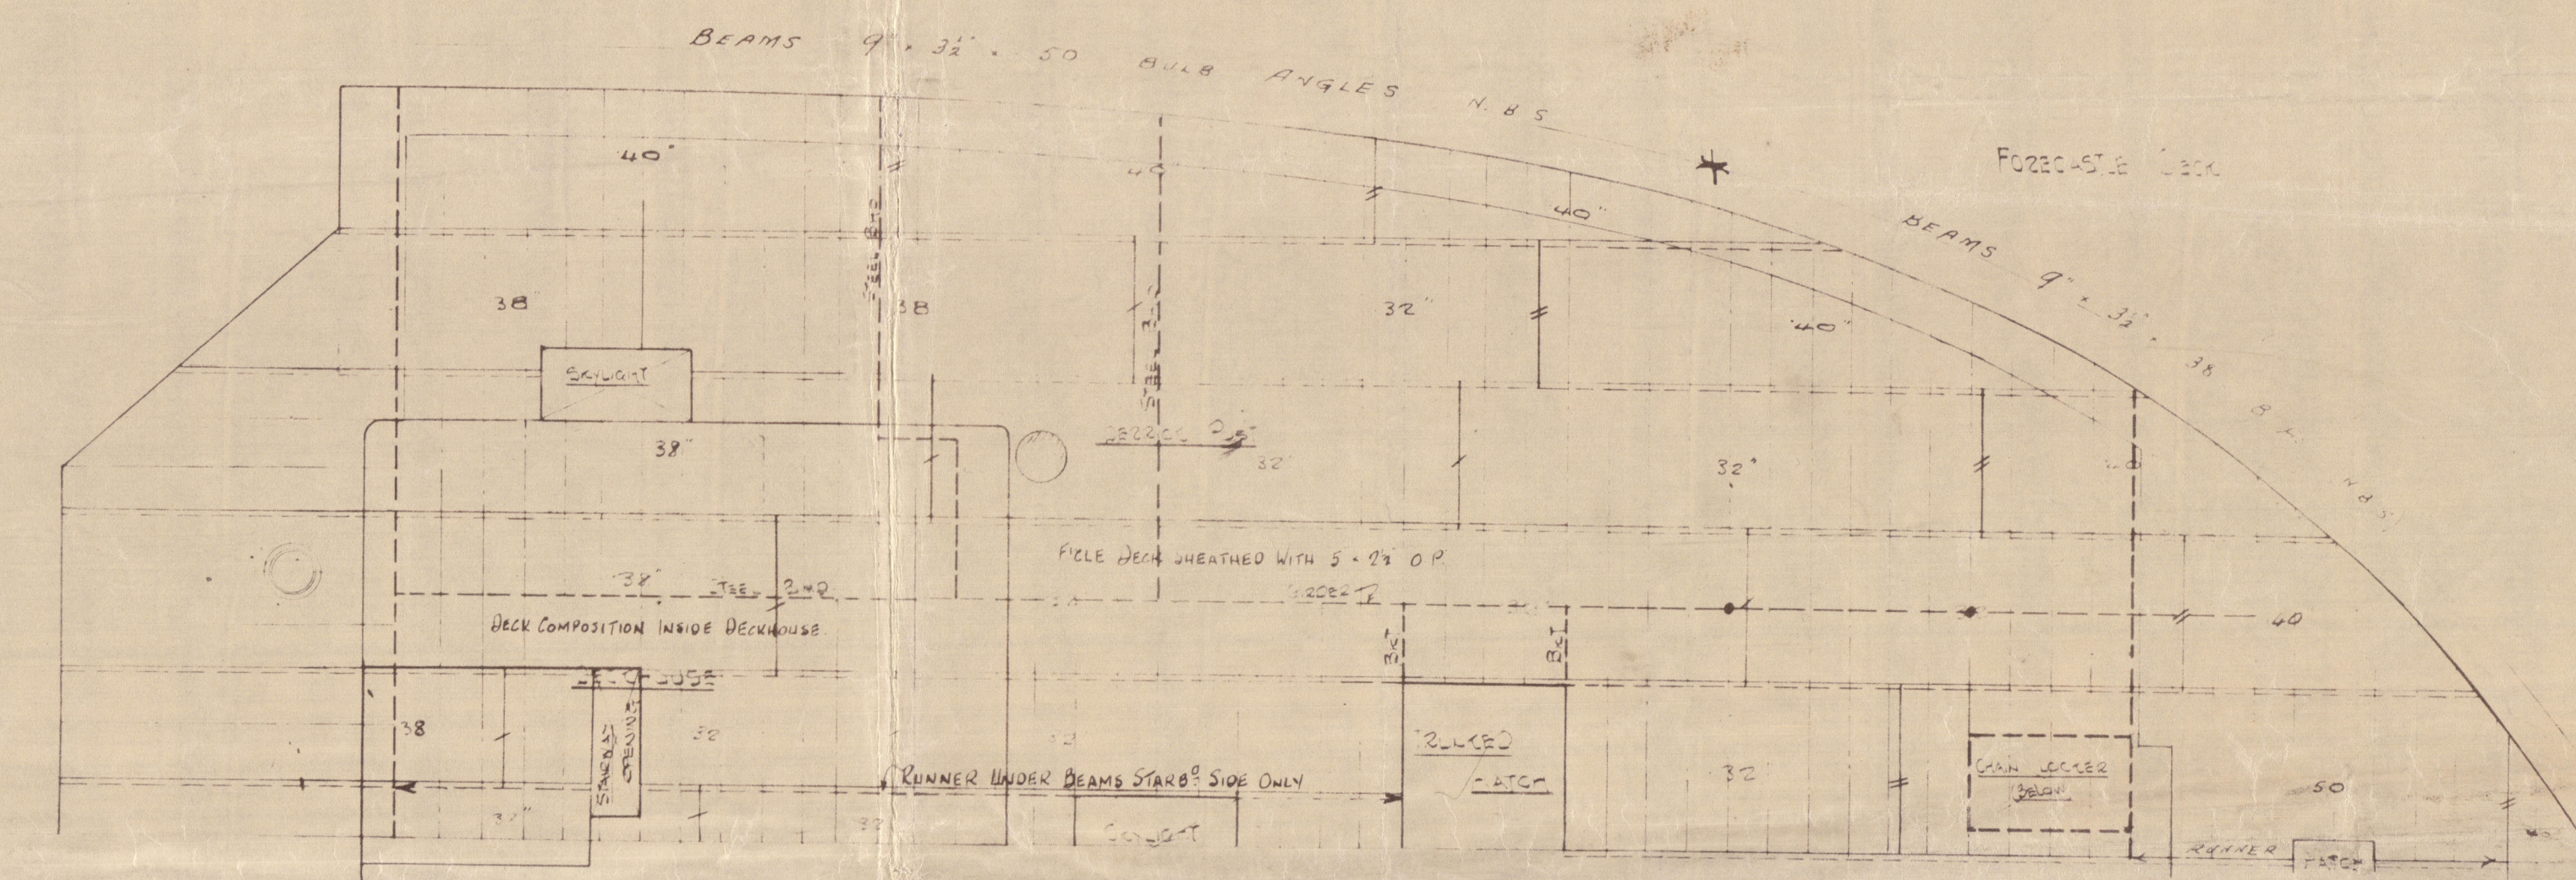

Westfold
189/190 11446

Stend House

189/190 11446

W 270-0056^{© 2019}



Lloyd's Register
Foundation