
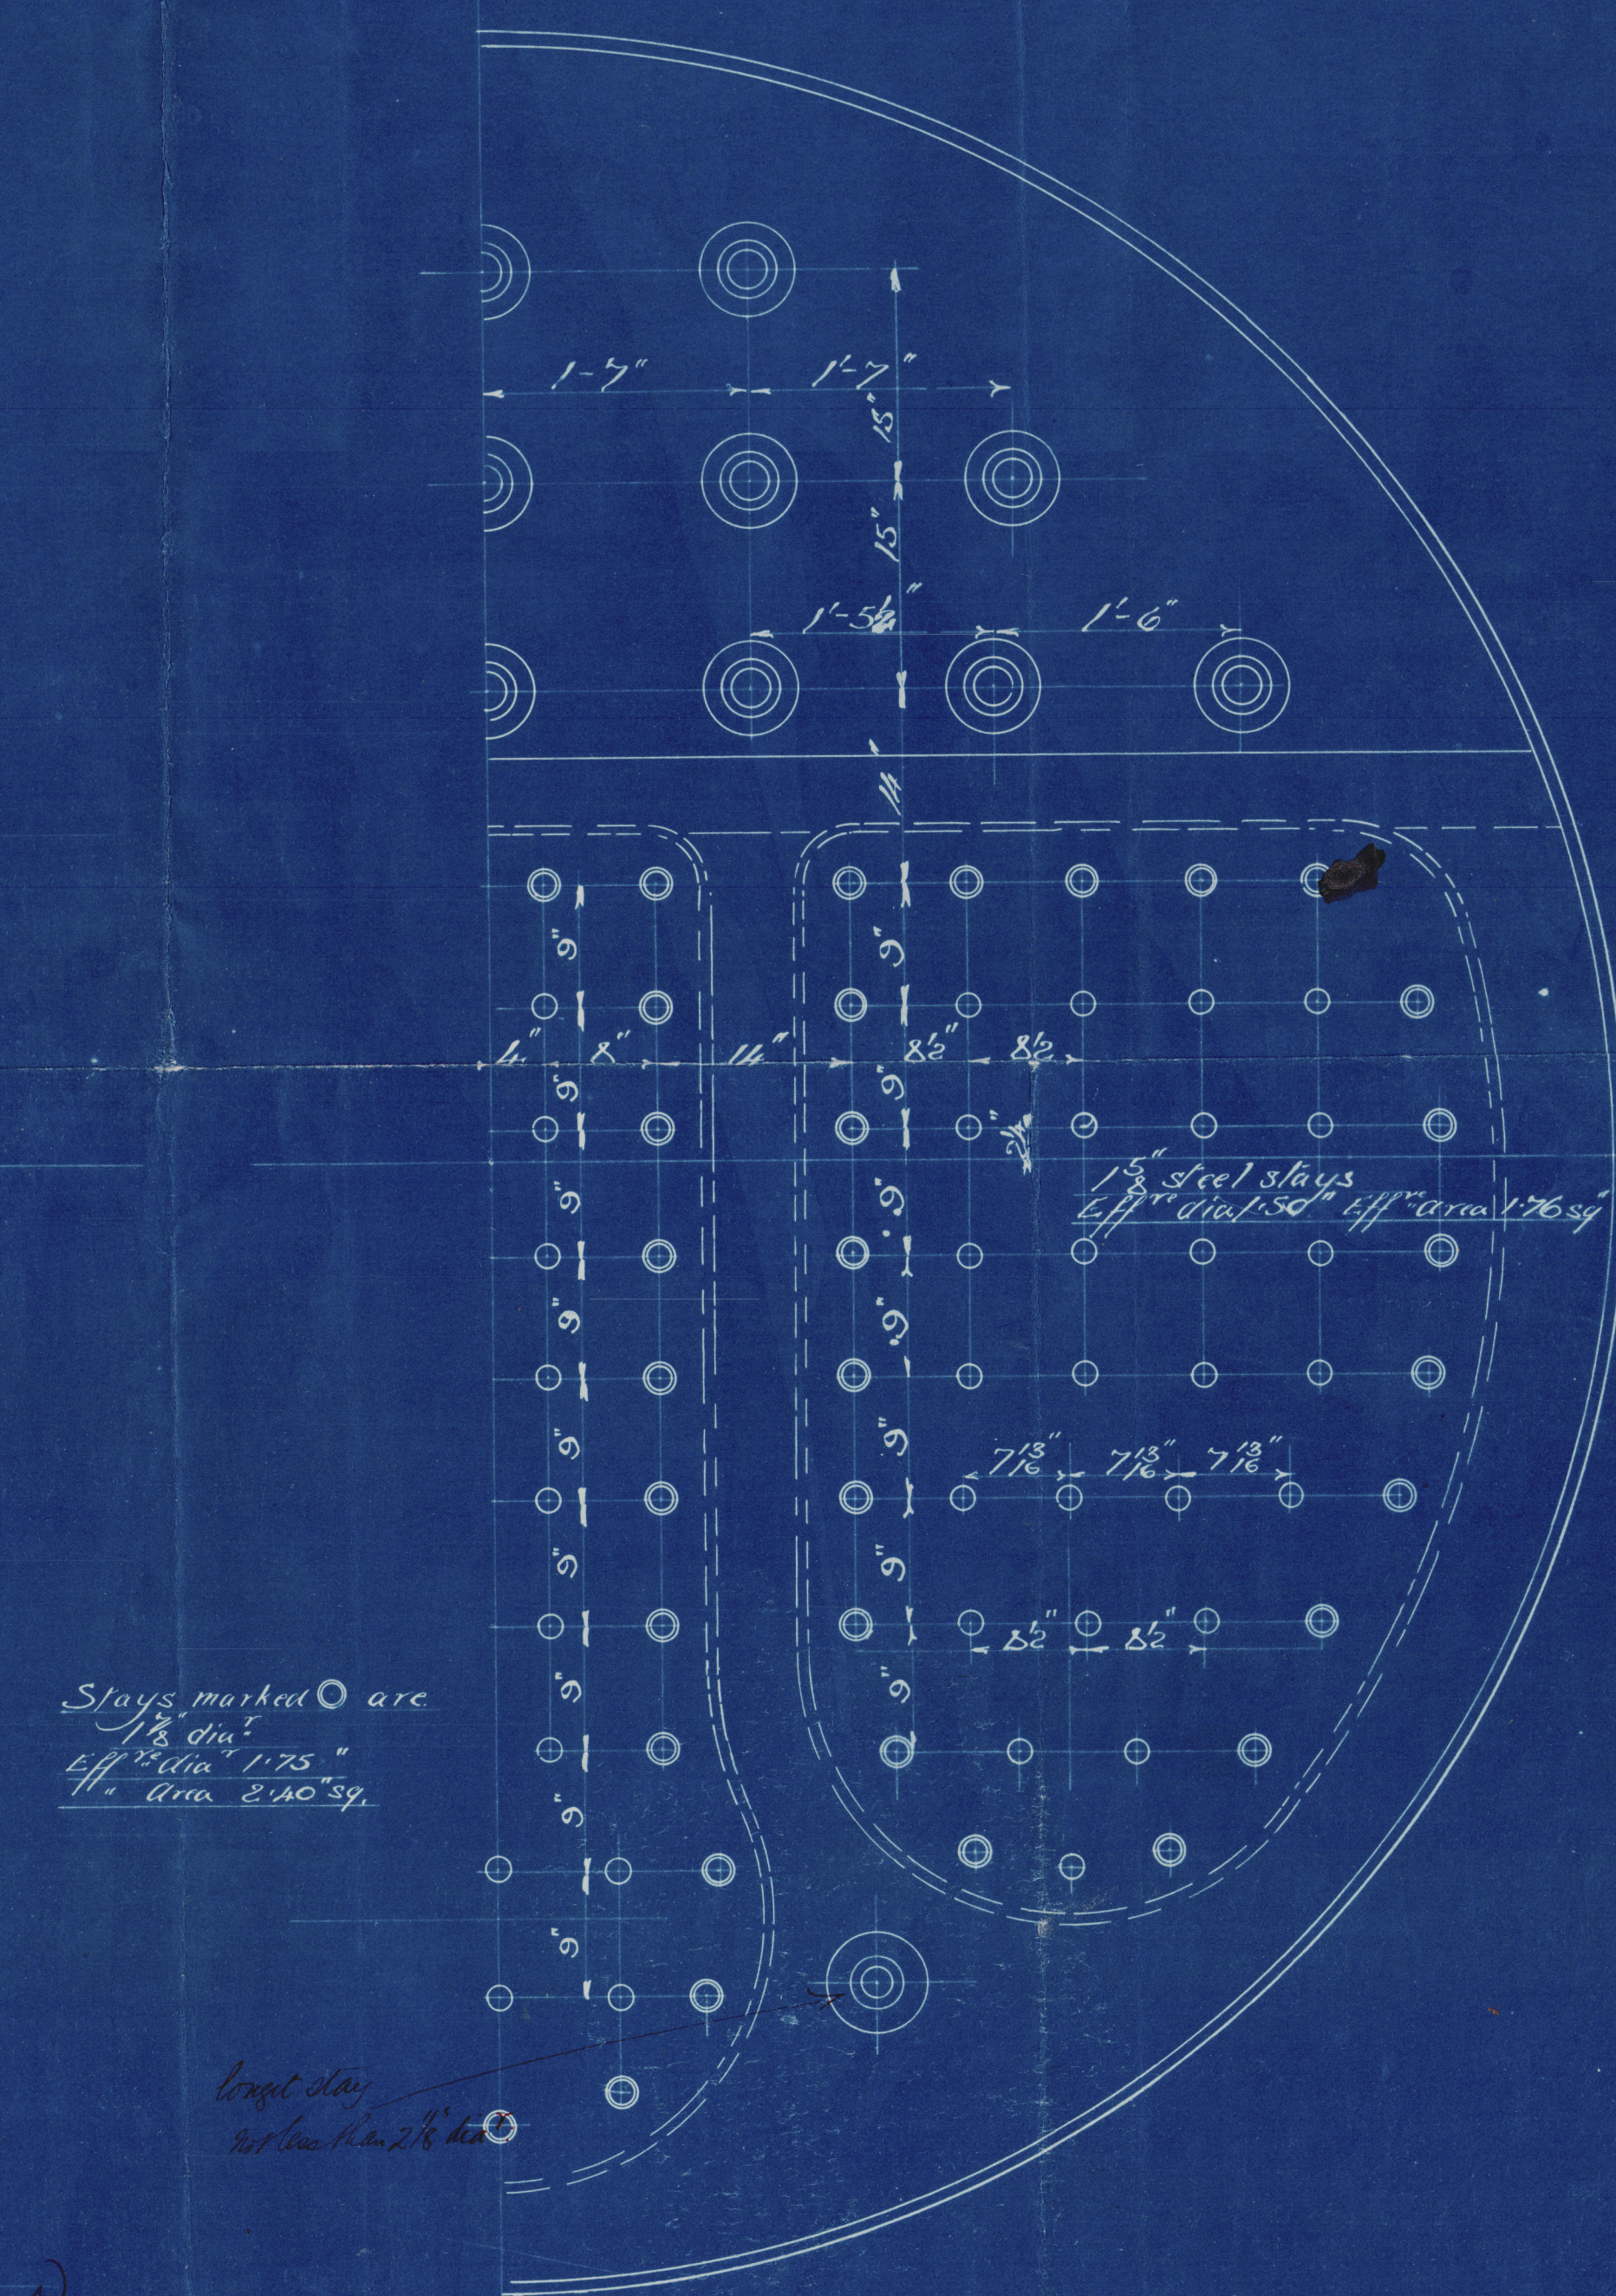
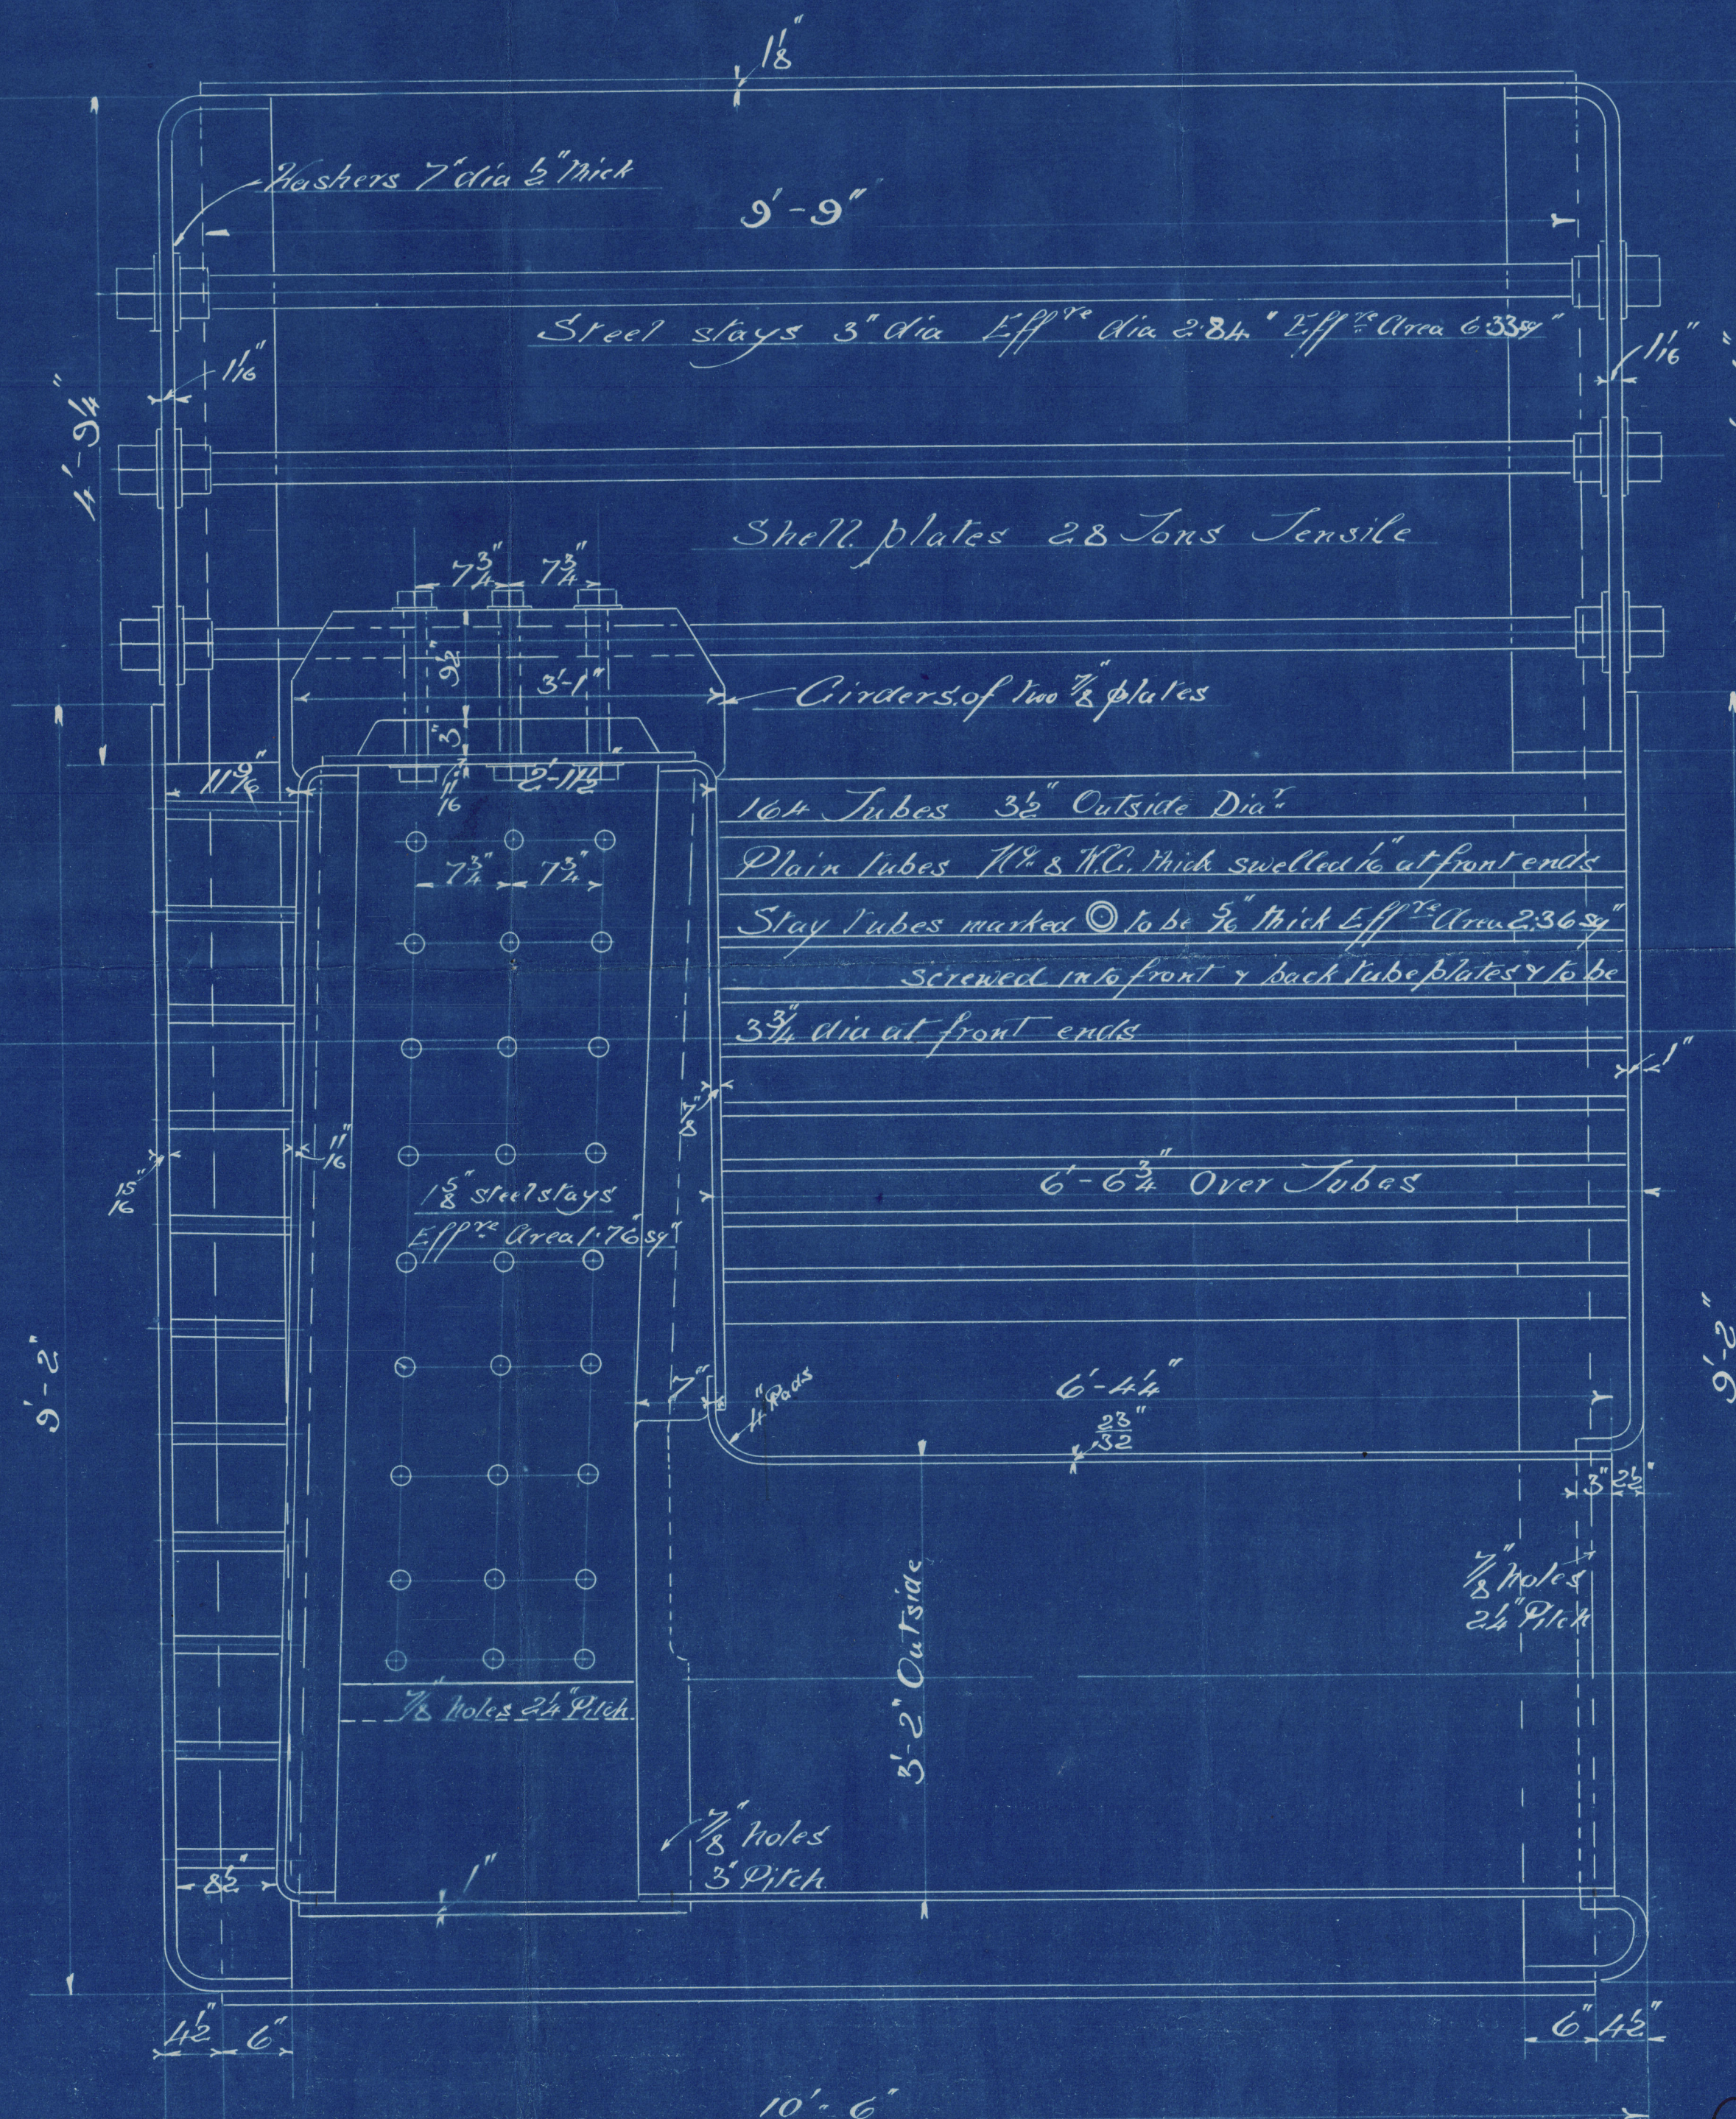
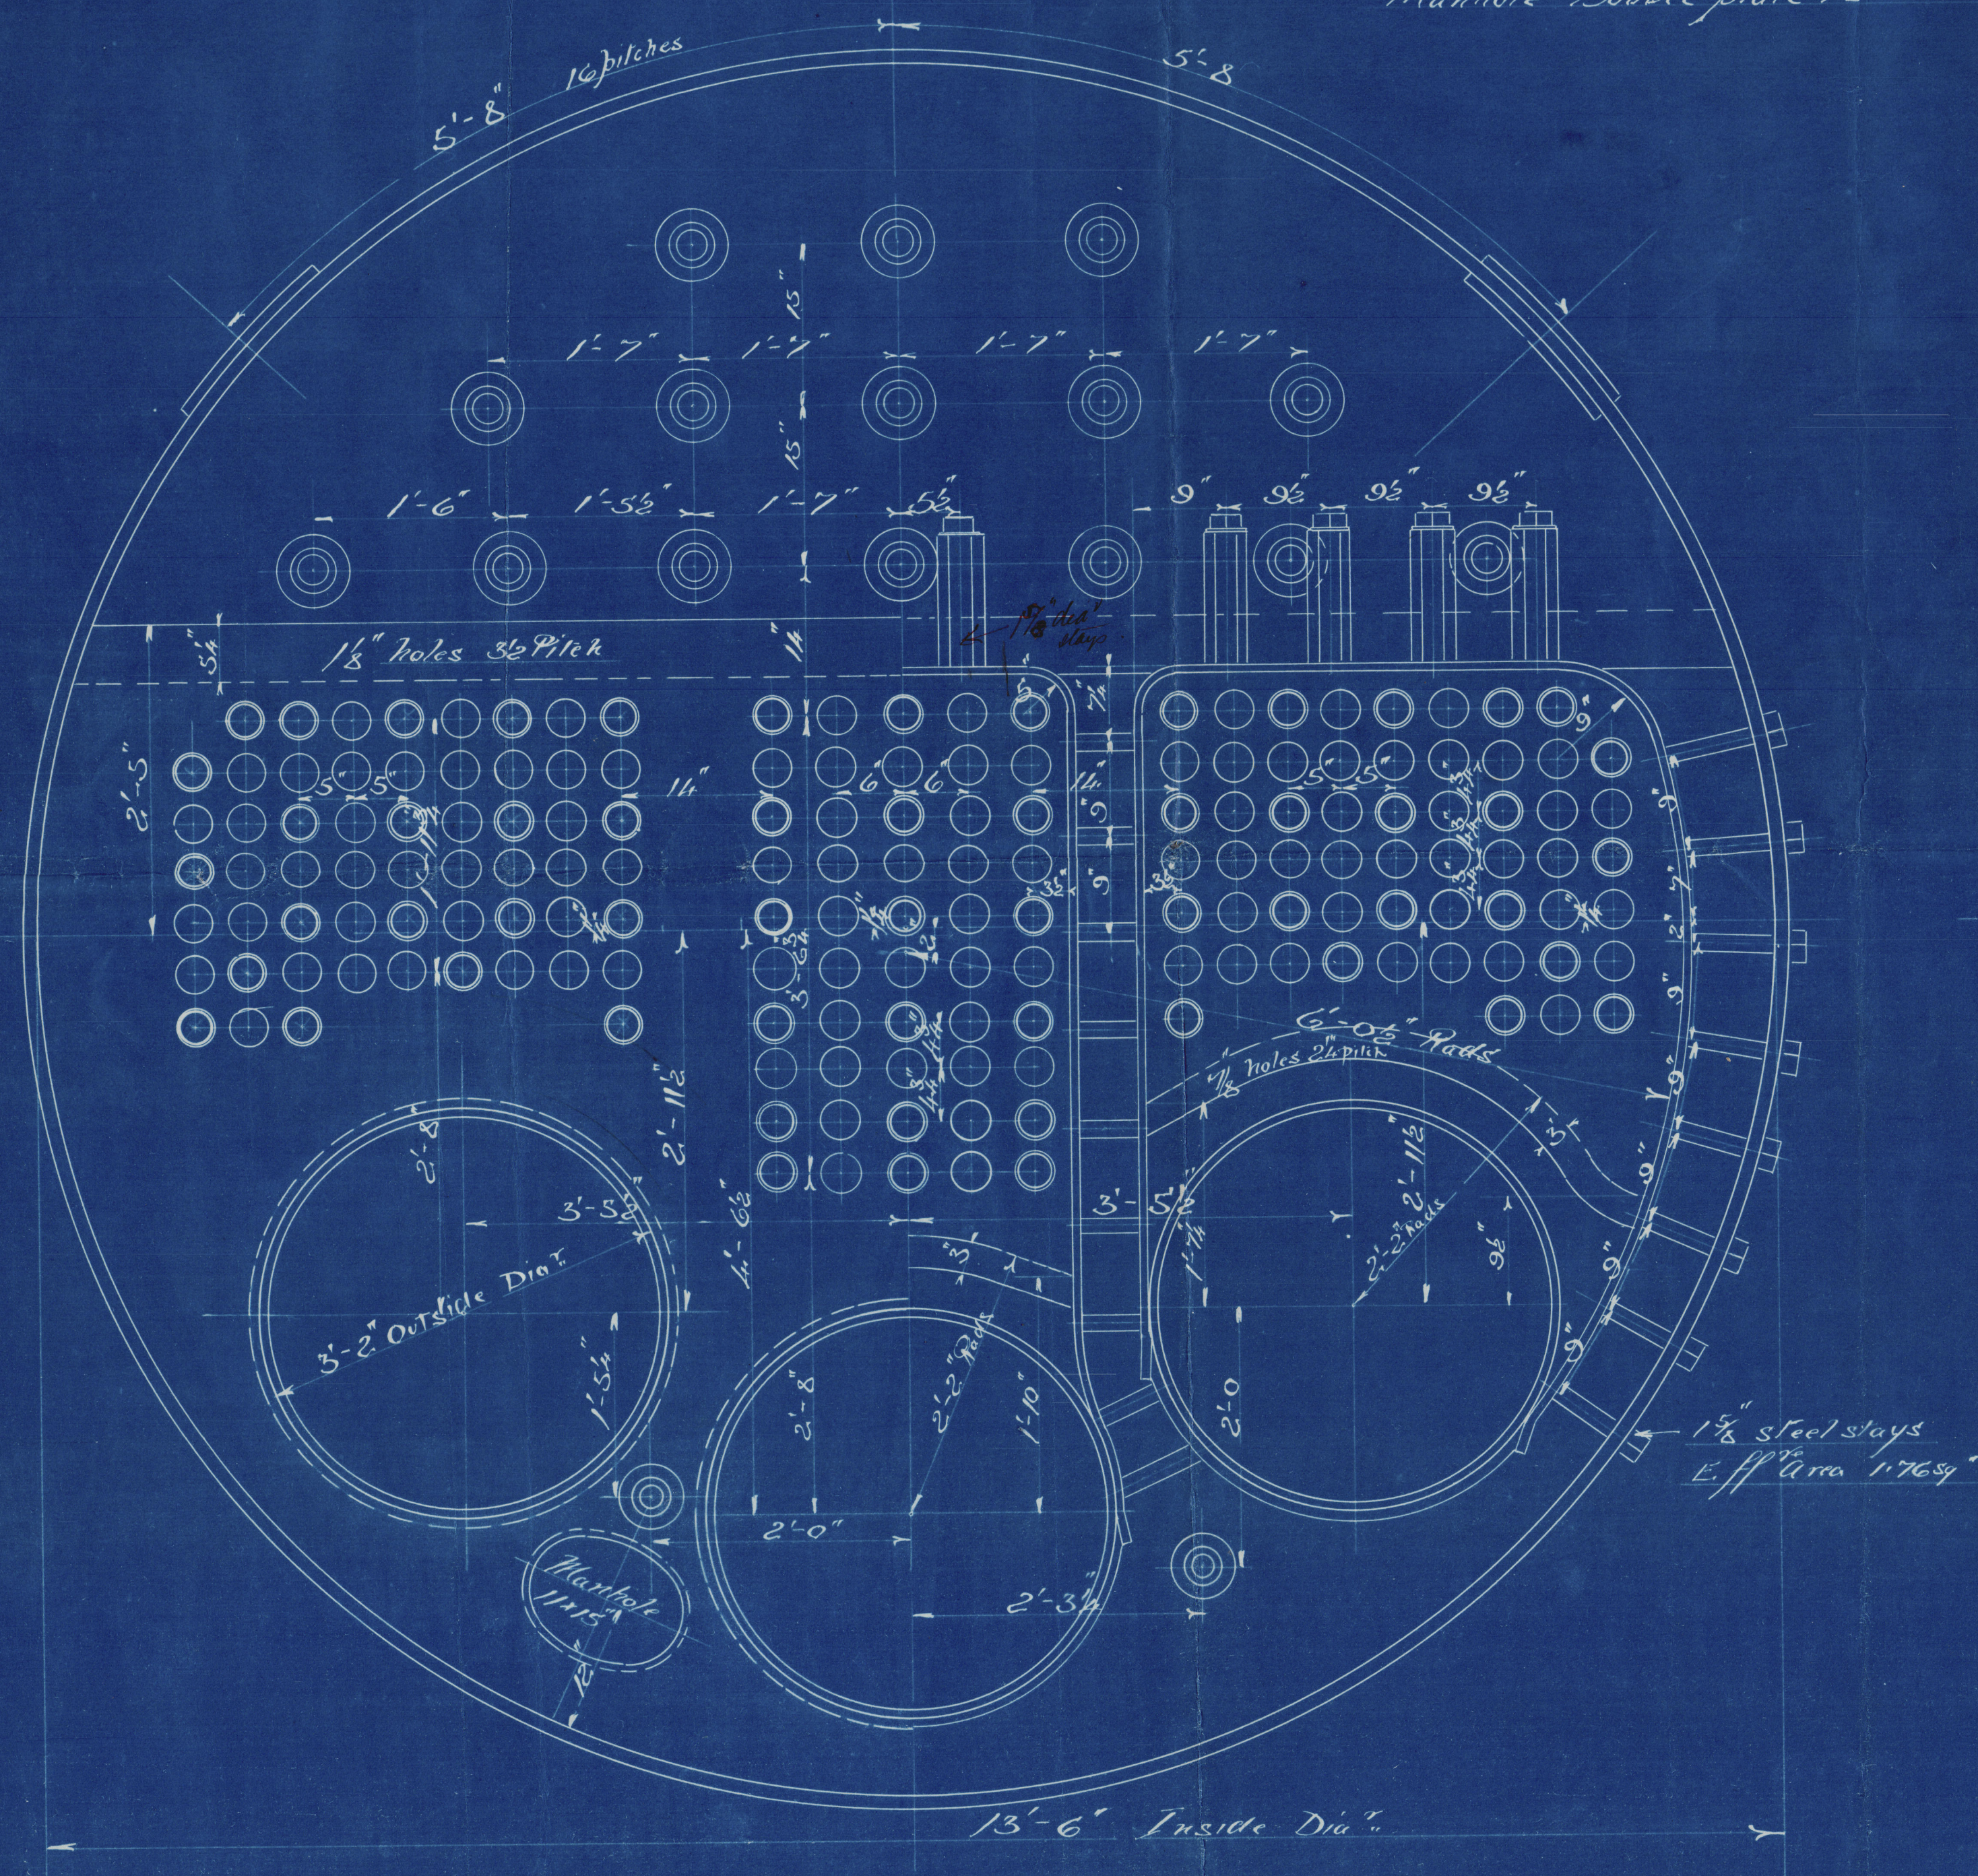
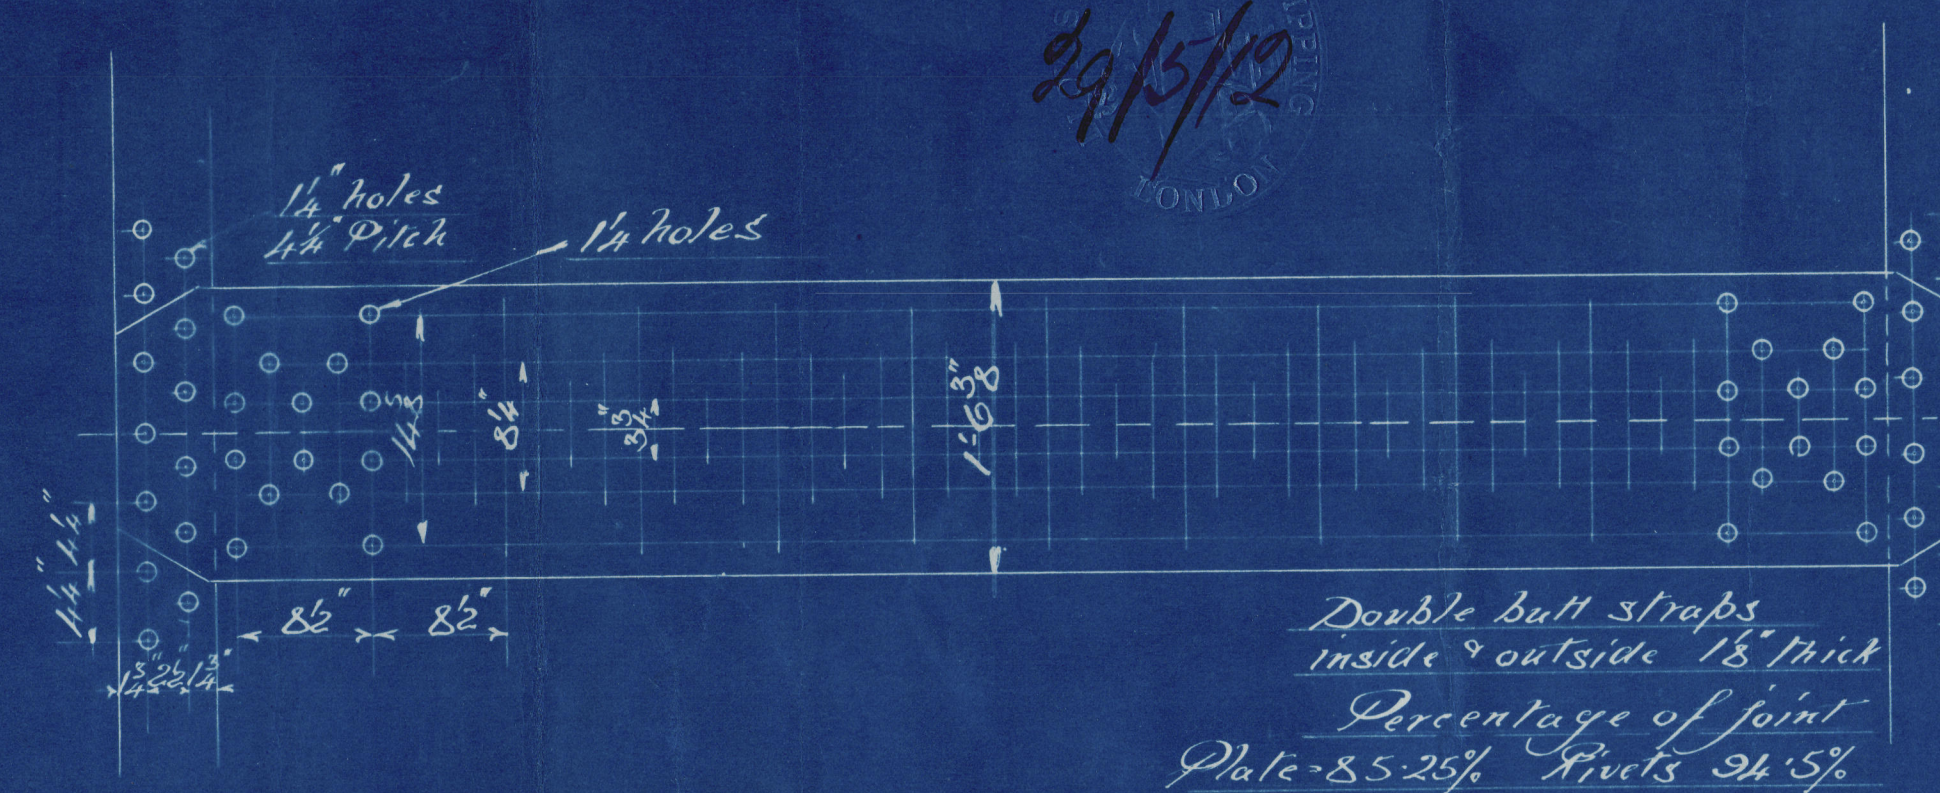


DIMENSIONS.	
LENGTH OF FIRE BARS	4'-6"
AREA OF FIRE GRATE	12.75 sq ft
DIAM OF TUBES OUTSIDE	3 1/2"
LENGTH OF TUBES	over plates 6'-6 3/4"
NO OF TUBES	164
SURFACE OF TUBES	977 sq ft
TOTAL HEATING SURFACE	1332 sq ft
WORKING PRESSURE	180 lbs
WGT OF SAFETY VALVE	

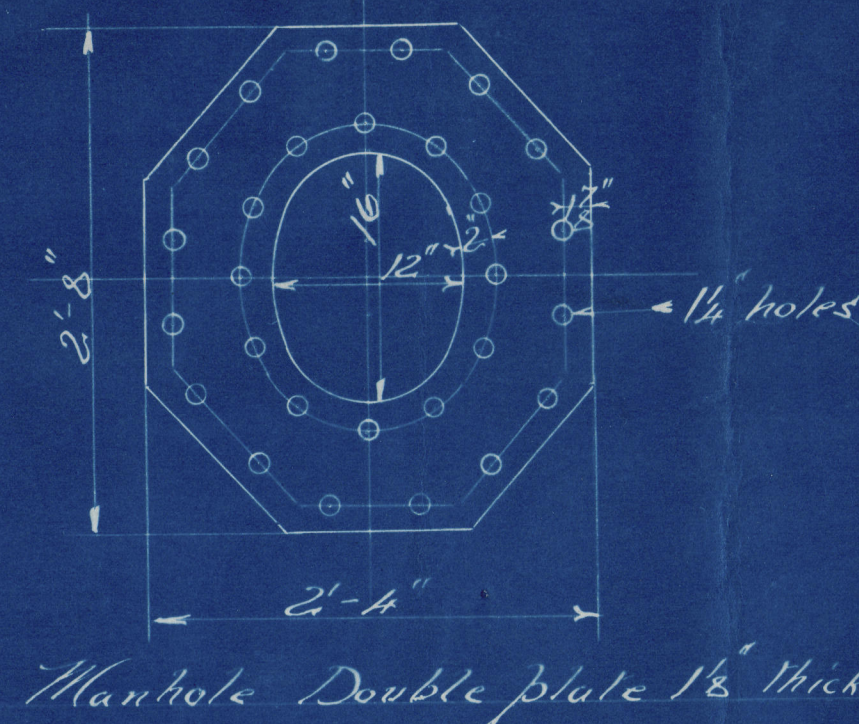


PLAN N^o2530

STEEL BOILER N^o985-6

CHARLES D HOLMES & CO LTD
ENGINEERS & BOILER MAKERS
HULL. 2/15/12

97

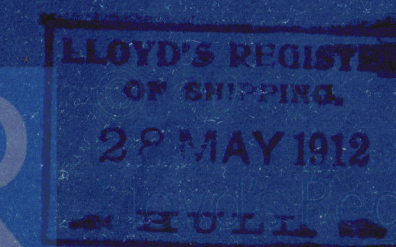

FOR ENCLOSURE TO

Lloyd's

FROM
CHARLES D. HOLMES & CO., Ltd.,
HULL.



W270-C114(2/2)

MESSRS. CHARLES D. HOLMES & CO. LD.

Nº 985-6

WORKING PRESSURE 180 LBS.
1/2 Caulonia Hull Rpt No. 25758
St. Leonard " " "

LOYDS TEST
Nº
360 LBS.

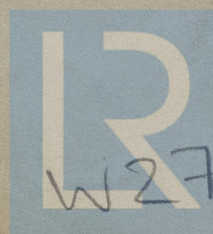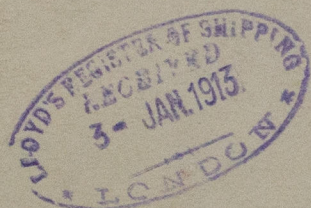

© 2019

Lloyd's Register
Foundation