

and P. 100000
 150.00
 water 2 1/2

29.7.12

PLAN No. 1795
 FOR ENCLOSURE TO
 Messrs Lloyd's Surveyors
 Hull FROM
 COCHRANE & SONS,
 SHIPBUILDERS, SELBY.
 DATE 25/7/12. RR

MIDSHIP SECTION.


N^o 546.

STEEL SCREW TRAWLER

DIMS 136'-8" x 23'-0" Ex x 13'-0" DEPTH M^{LD}

SCALE 1/2" = ONE FOOT.

TO CLASS 100 A1 AT LLOYDS ^{Steam Trawler.} ~~FOR FISHING PURPOSES~~
 ENGINE & BOILER CASING AS PREVIOUSLY APPROVED

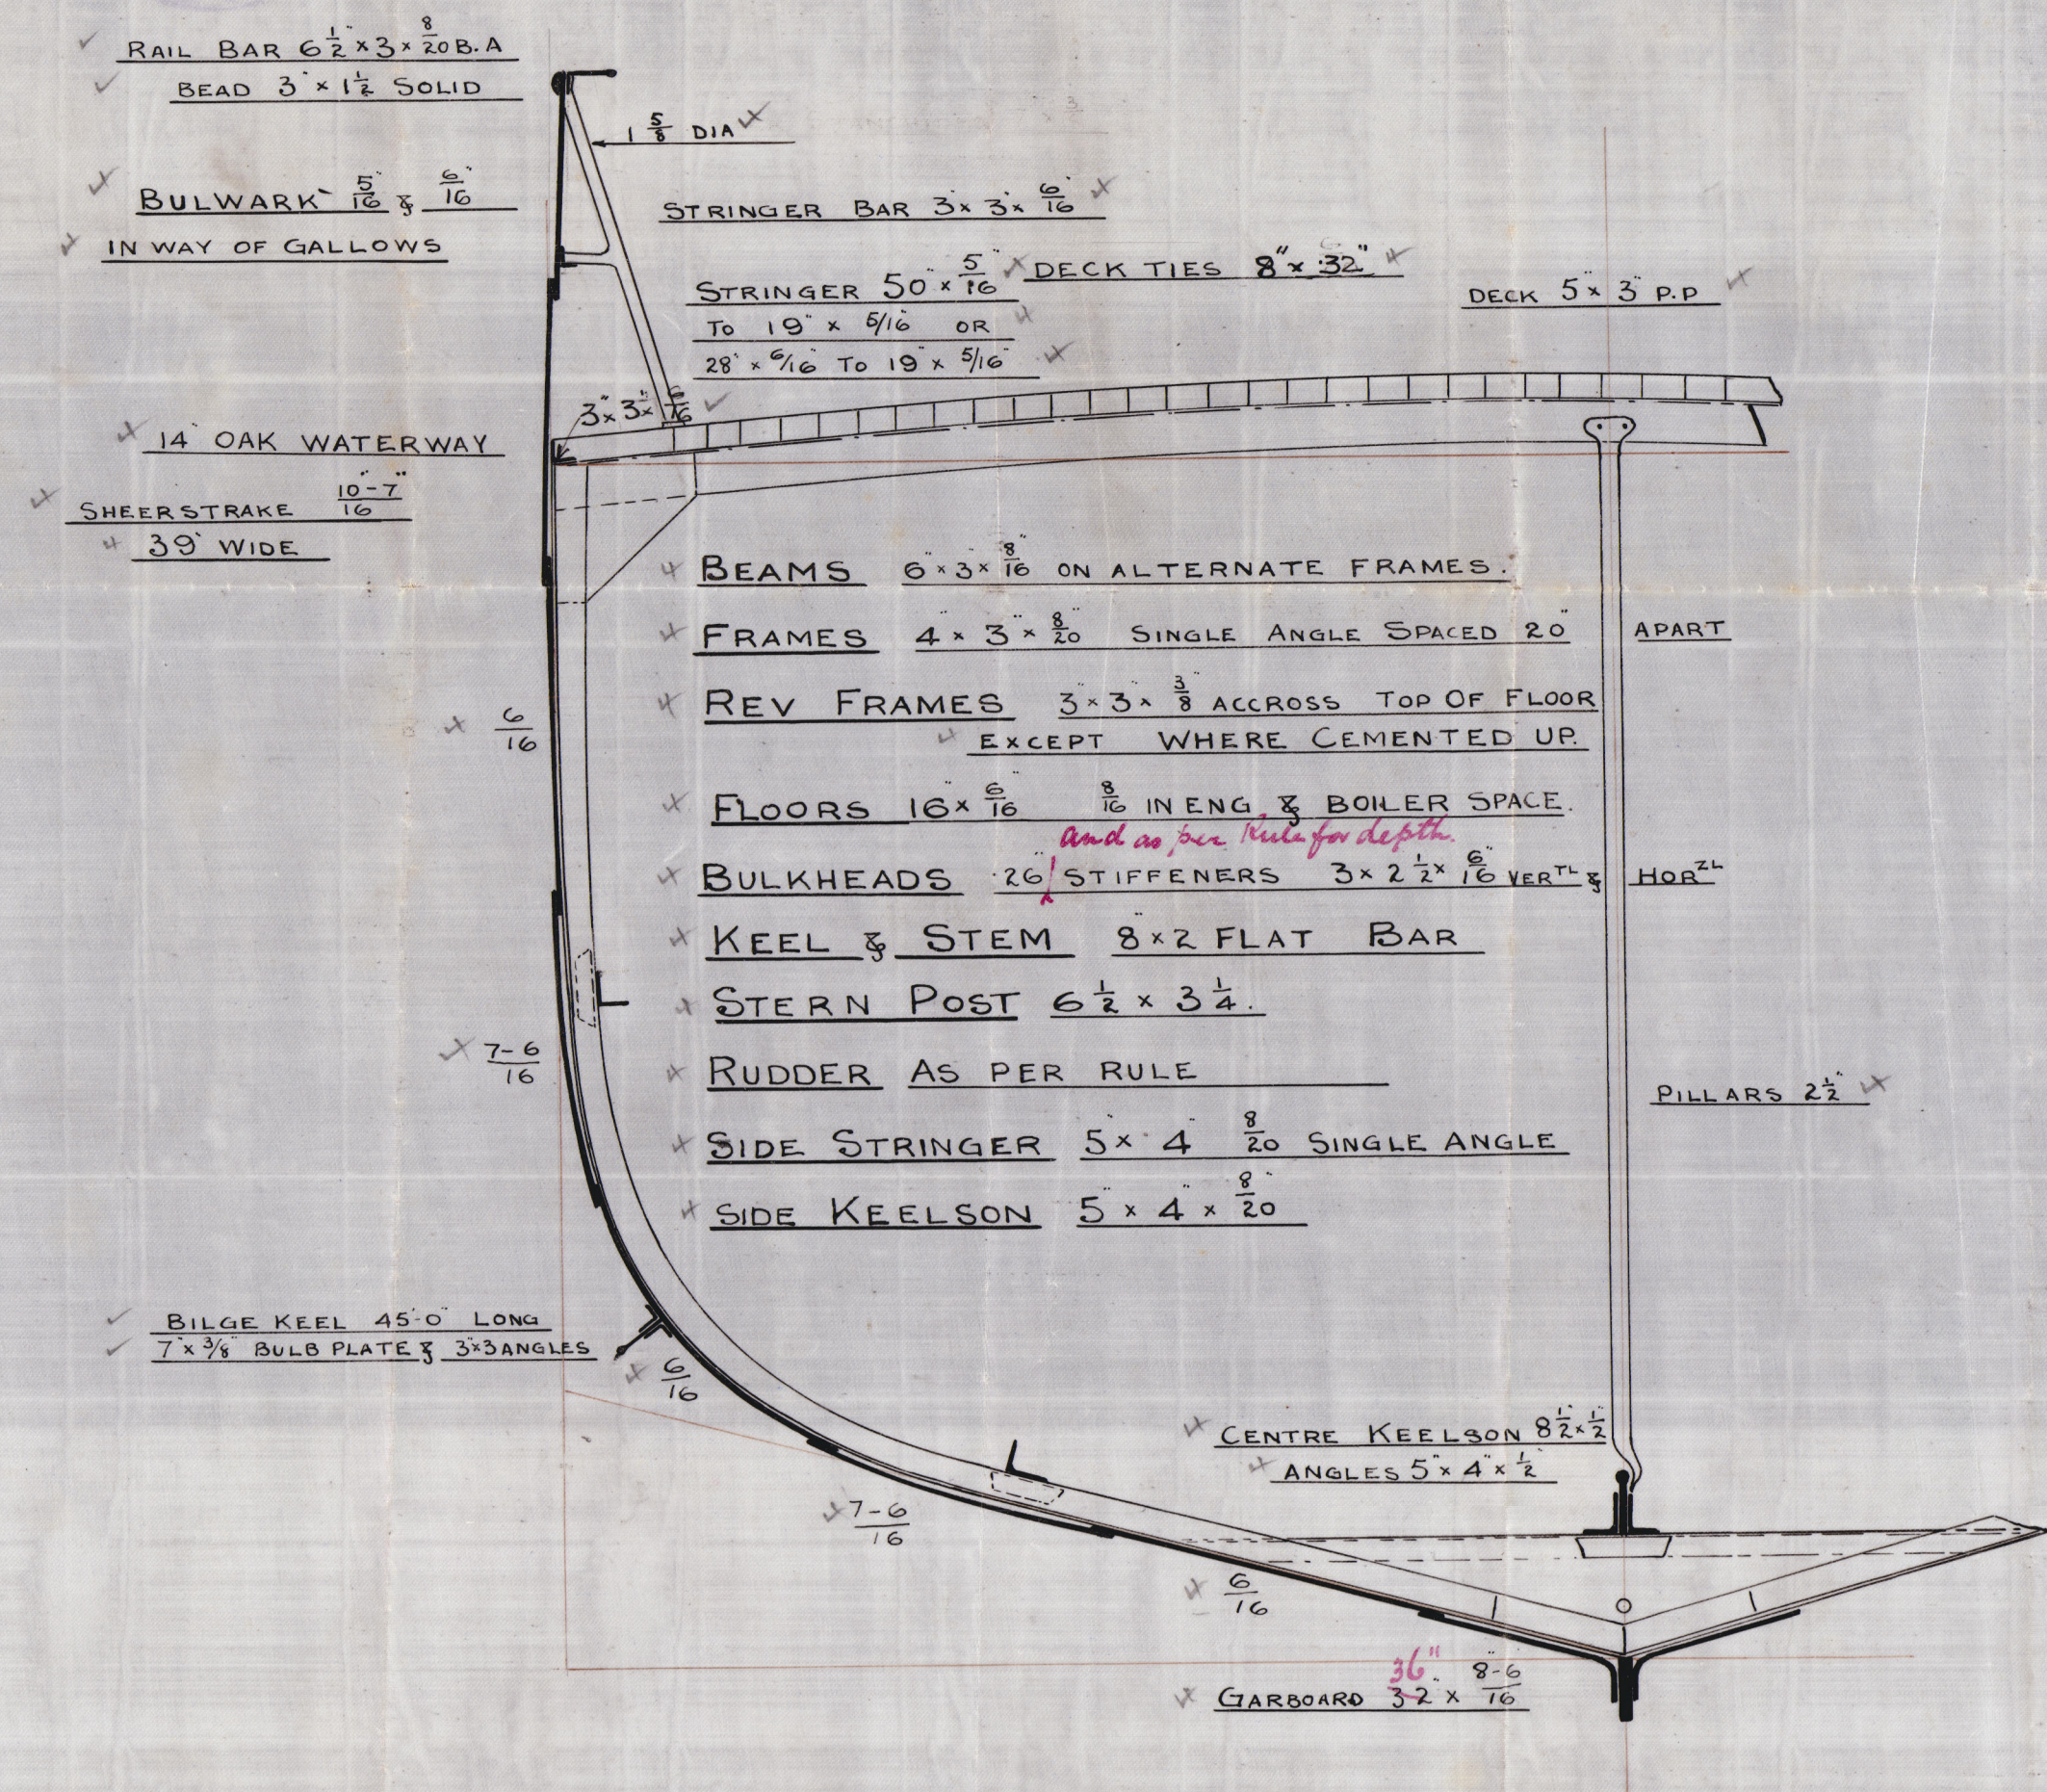

NUMERALS

B + D = 35.87
 L x (B + D) = 4901.99

PROPORTIONS

DEPTH TO LENGTH 10.51
 BREADTH " " 5.97

EQUIPMENT

1ST BOWER 6 CWTs EX STOCK OR 1 1/2 CWT. STOCKLESS
 2ND " 5 1/2 " " " 7 " "
 3RD " 3 " " " "
 120 FATHOMS 1 1/2 CABLE
 60 6 HAWSER
 60 5 WARP

RIVETING

BUTTS OF SHELL PLATING LAPPED
 & DOUBLE RIVETED EXCEPT GARBOARD
 & SHEER STRAKE WHICH ARE TO BE STRAPPED.
 LANDINGS DOUBLE RIVETED EXCEPT BULWARK
 WHICH IS SINGLE RIVETED. BUTTS OF STRINGER
 & TIES OVERLAPPED & DOUBLE RIVETED.

C.B.
 29.7.12.

Cochrane & Sons


No. 546

Midship Section

L. Caulonia

Wheel Rpt No: 15768

51-7-92

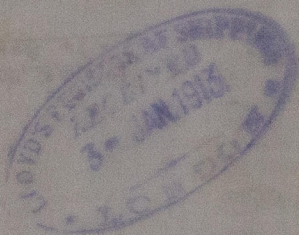

RAIL BAR 6 1/2 x 3
BEAD 5 x 1 1/2

BULWARK 10

IN WAY OF GALLO

14 OAK WATER

SHEER STRAKE 10

30 WIDE



© 2019

Lloyd's Register
Foundation