

For the information of Surveyors and the Committee only.

Received at

11 AUG 15

Office,

10

Lloyd's Register of Shipping.

(Report on Vessel No. 29138 Port Hull)

St. Donna Nook

No.

SHIP FORGINGS OR CASTINGS.

I have to report that the undermentioned Iron or Steel Forgings or Castings, manufactured by Messrs L. S. Forster & Sons Ltd of Sunderland for the Vessel No. 646, being built by Cochrane & Sons of Selby have been inspected by me as set forth below and found to be, so far as can be seen, Sound

Mark on Forgings or Castings.

Lloyd's


No. 6901

D. D. Williamson.

Sunderland.

	STERN FRAME.	RUDDER FRAME.	STEM.
Material*	Scrap Iron	Scrap Iron	
How made	Forged	Forged	
Dimensions	6½" x 3"	4½" dia	
Progress on Inspection	Forging & Finished	Forged & Finished	
Date when Inspected	20-4-15 to 30-4-15	24-5-15 to 9-8-15	
CASTINGS.			
Tests on Standard Test Pieces.			
Tensile Test—			
Tons per square inch			
Extension per cent.			
Cold Bending Test—			
Angle before fracture			
Drop Test—			
Height from ground			
Hammering Test—			
If made according to Rules and found satisfactory			

SKETCHES OF FRAMES SHOWING POSITION AND DESCRIPTION OF WELDS OF FORGINGS.

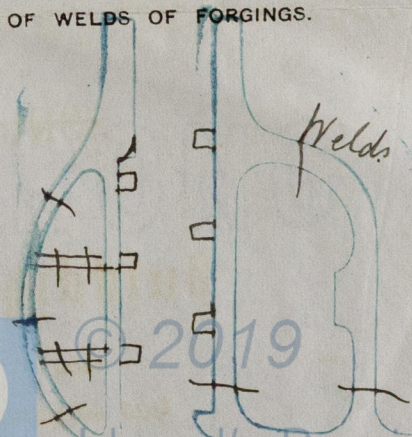

Fee (if any chargeable) £

To be paid at

* If of Iron, state whether scrap or puddled Iron. If of steel, state whether made on the Open Hearth process.