

DIMNS; 125'-0" B.P. x 22'-4 1/2" MLD x 12'-9" MLD.

SCALE 1/2 INCH.

✓ To CLASS 100 A.1. - LLOYDS STEAM TRAWLER.
✓ DECK PLATED OVER IN WAY OF MACHINERY.
✓ E & B. CASING AS PREVIOUSLY APPROVED.

NUMERALS.

$B + D$ 35.12
 $L \times (B + D)$ 4390.00

PROPORTIONS.

$$\begin{aligned} L/D & \dots\dots\dots 9.8 \\ L/B & \dots\dots\dots 5.6 \end{aligned}$$

EQUIPMENT.


✓ 1ST. BOWER 5½ CWTs EX STOCK OR 7 CWT. STOCKLESS.
✓ 2ND. " 5 " " " 6¼ " "
✓ KEDGE 2¾ " " " "
✓ 105 FATHOMS 1¼" STUD LINK CABLE.
✓ 60 " 6" HAWSER.
✓ 60 " 4½" WARP

— RIVETTING. —

✓ BUTTS OF SHELL PLATING TO BE LAPPED
AND DOUBLE RIVETTED, EXCEPT
GARBOARD AND SHEER STRAKE
WHICH ARE TO BE STRAPPED.

✓ SHELL SEAMS DOUBLE RIVETTED
BULWARK SEAM SINGLE RIVETTED.

✓ RIVETS IN KEEL, STEM & STERNPOST 1" DIA.
SHELL RIVETS $\frac{3}{4}$ " DIA.

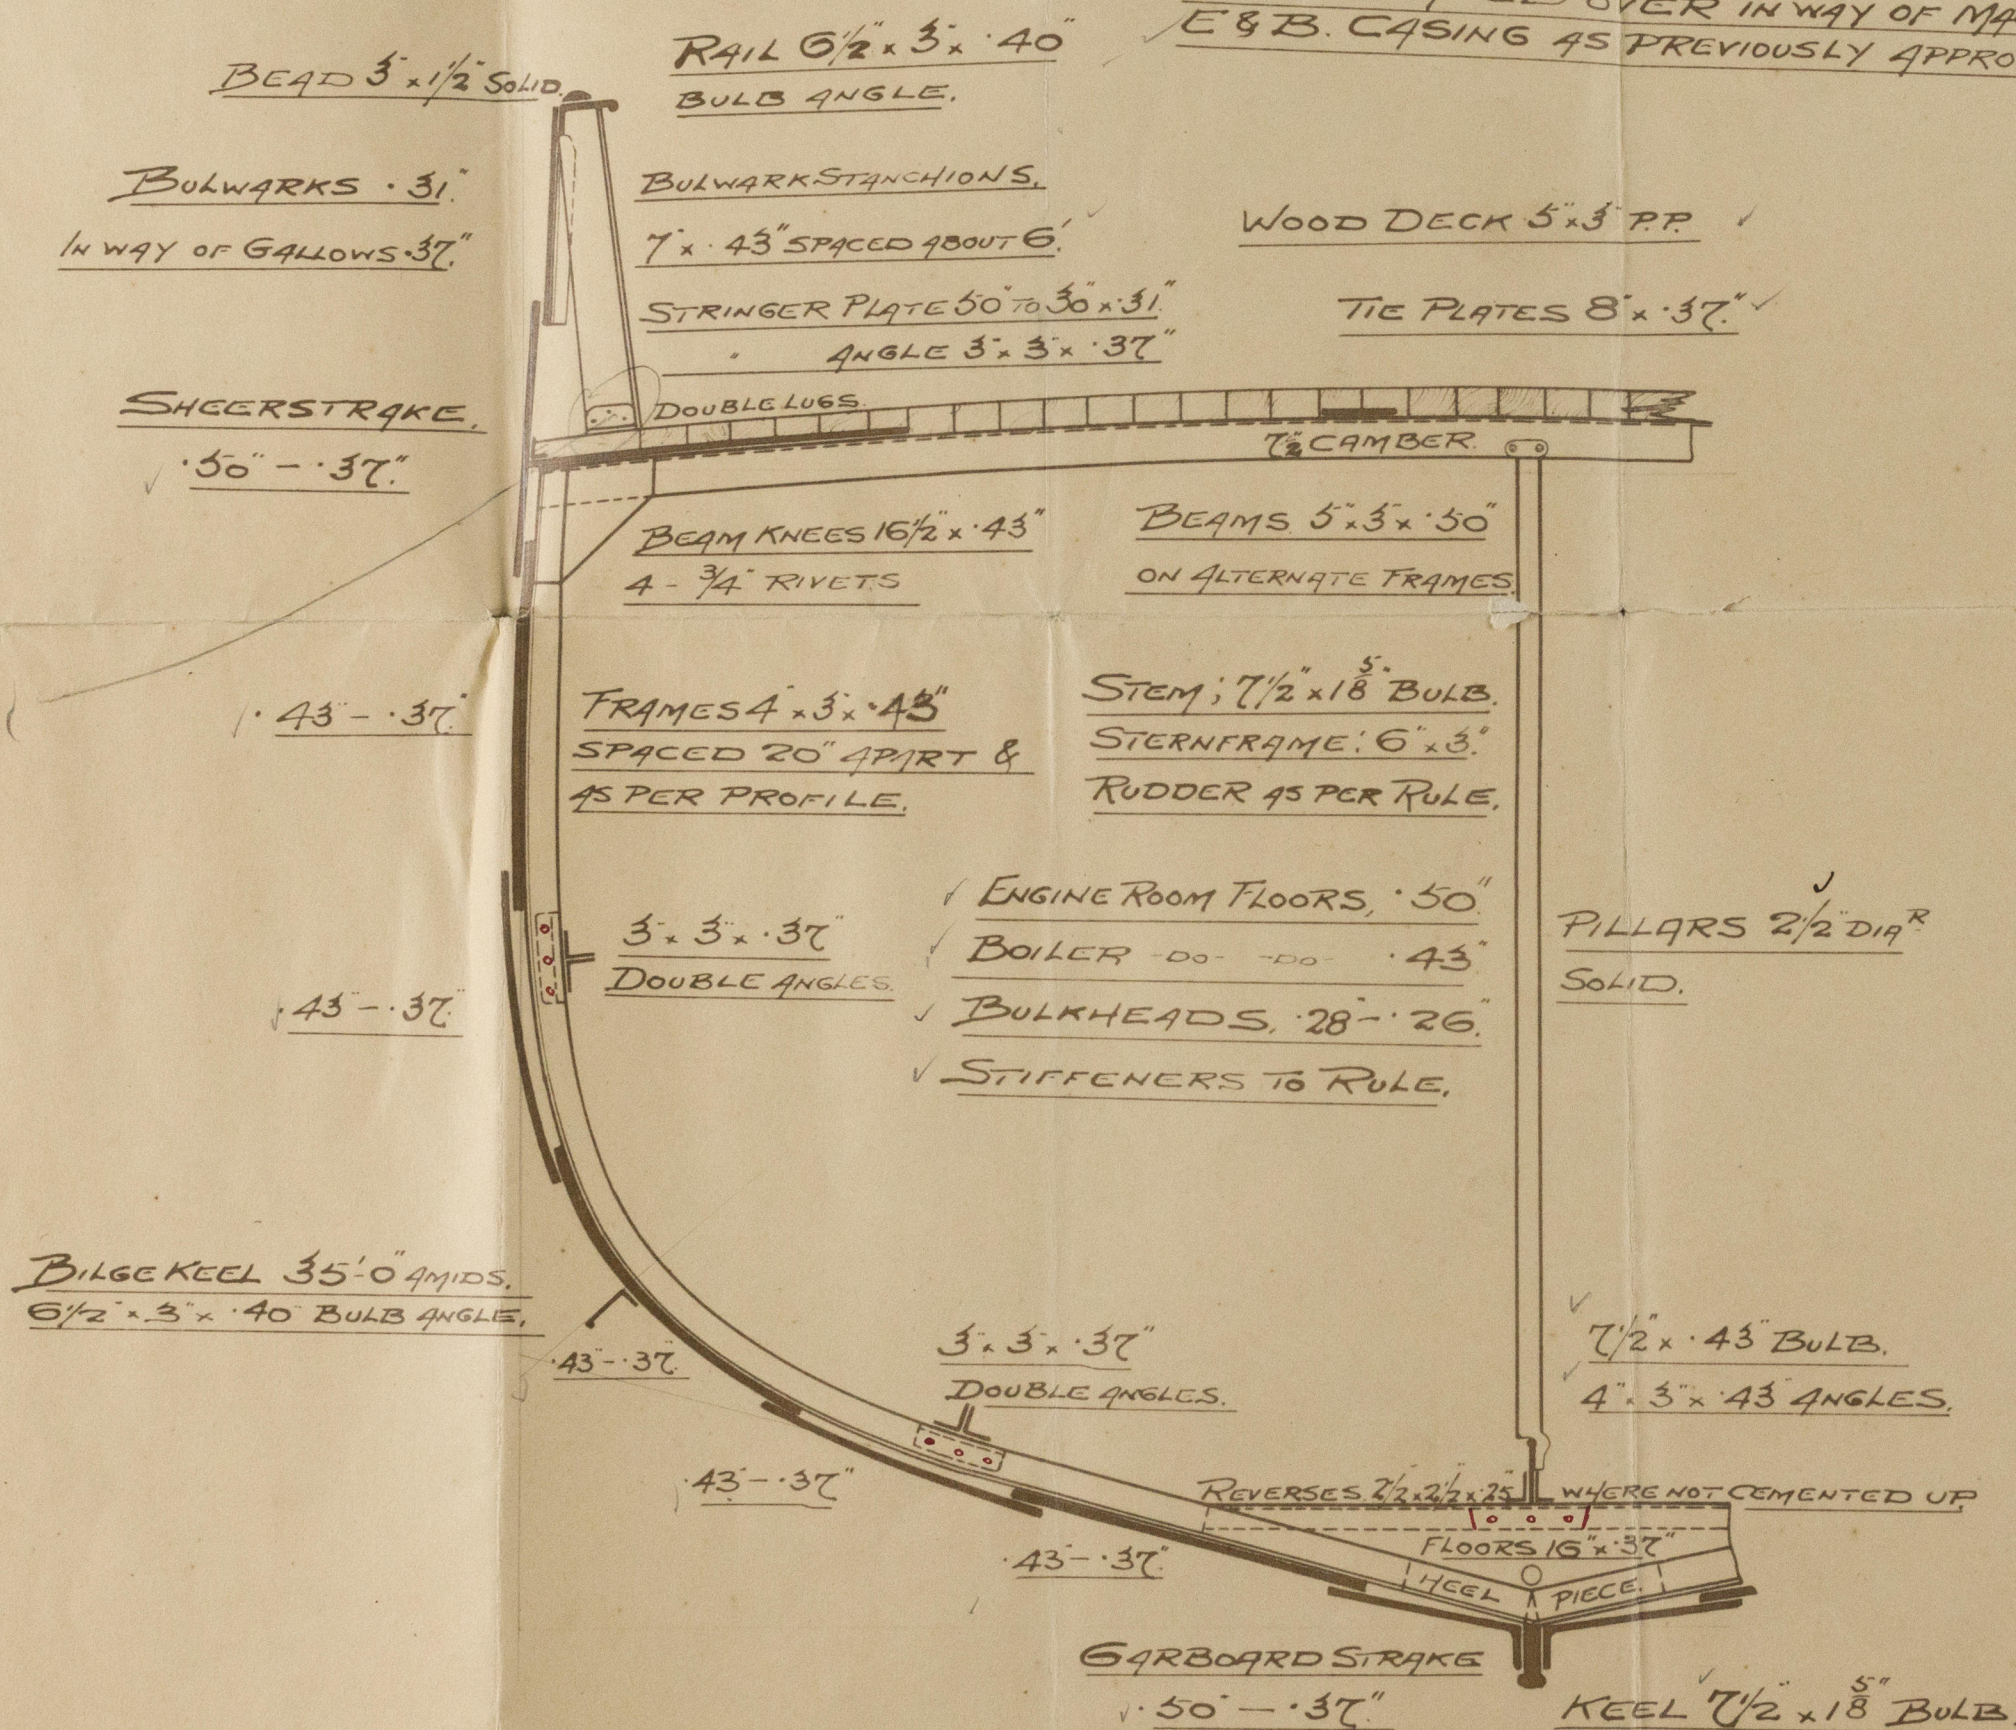

Jul
23.8.15

M273-0037

MIDSHIP SECTION

COCHRANE & SONS LTD


N^o 658



*s/s Transvaal
Hull Rpl No 29516*



W 273-0037

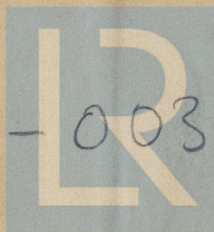

© 2020

Lloyd's Register
Foundation