

23.8.15

PLAN No. 5889.  
FOR ENCLOSURE TO  
Messrs Lloyd's  
Bull. FROM  
COCHRANE & SONS, LTD.  
SHIPBUILDERS, SELBY.  
DATE 19/8/15.

# PROFILE & DECK PLAN.


STEEL SCREW TRAWLER.

No 658.


DIMNS: 125'0" x 22'4 1/2" MLD x 12'9" MLD.

SCALE 1/4 INCH = ONE FOOT.

TO CLASS 100 A.1 STEAM TRAWLER.

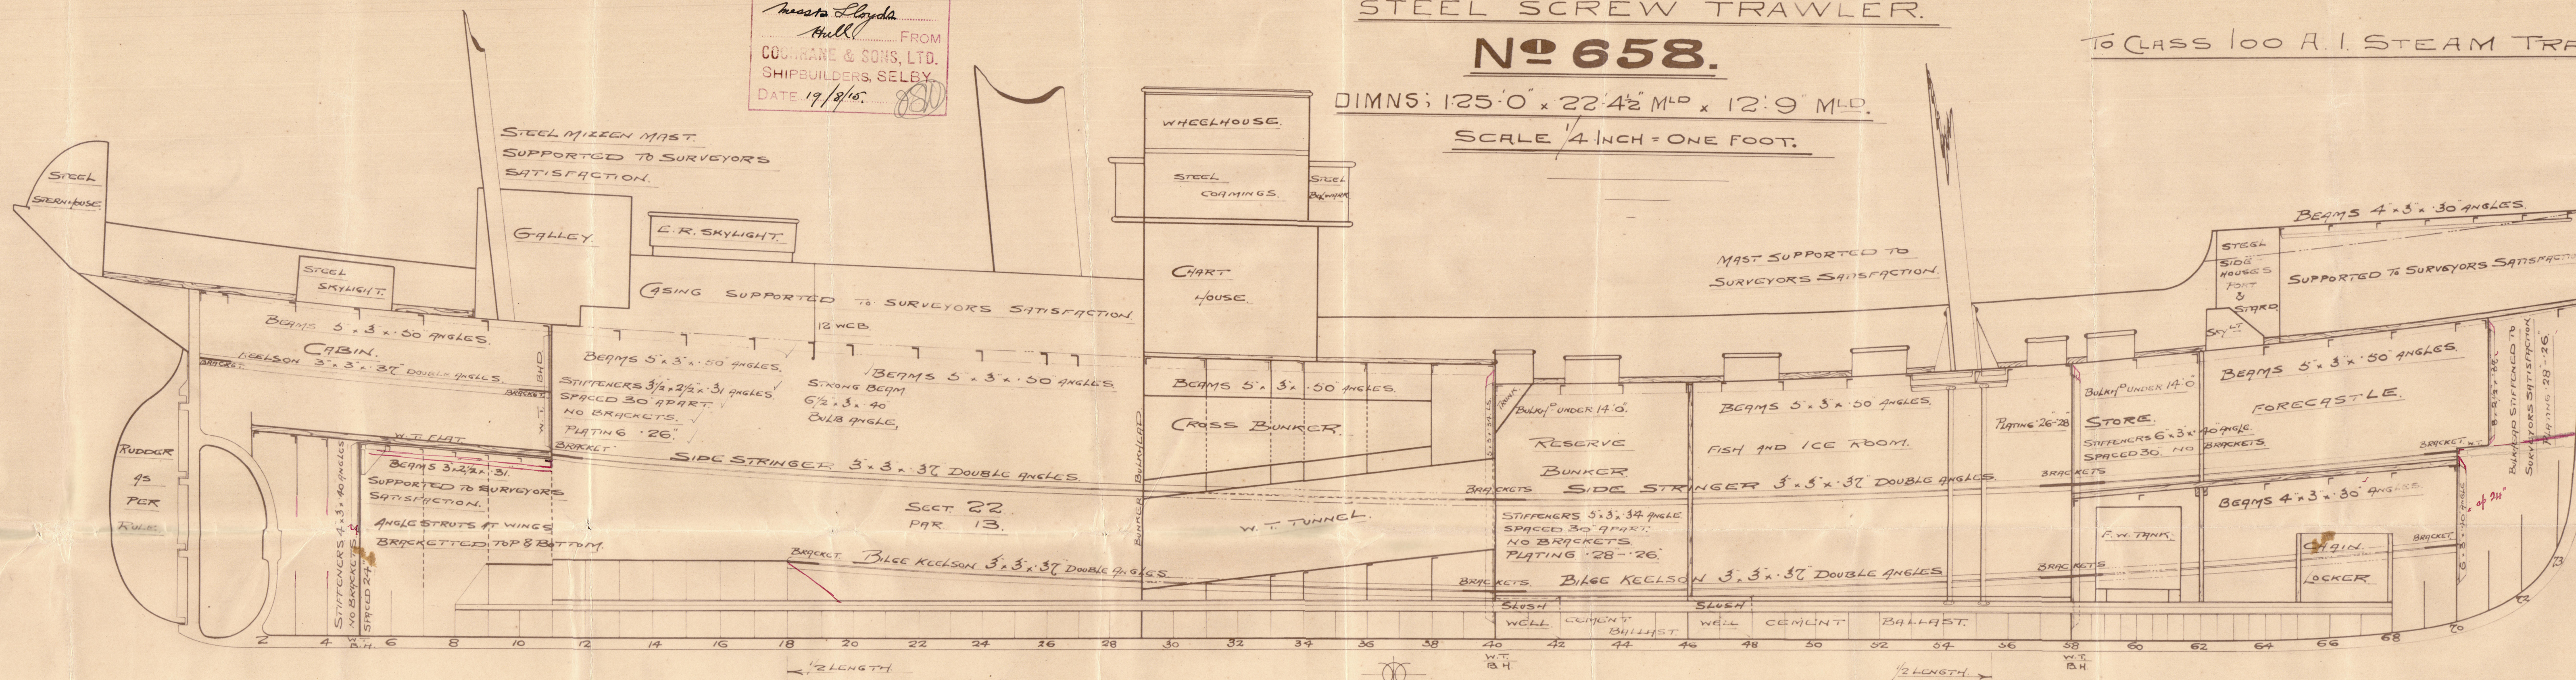

THE VESSEL TO BE PILLARED THROUGHOUT TO THE SURVEYORS SATISFACTION.

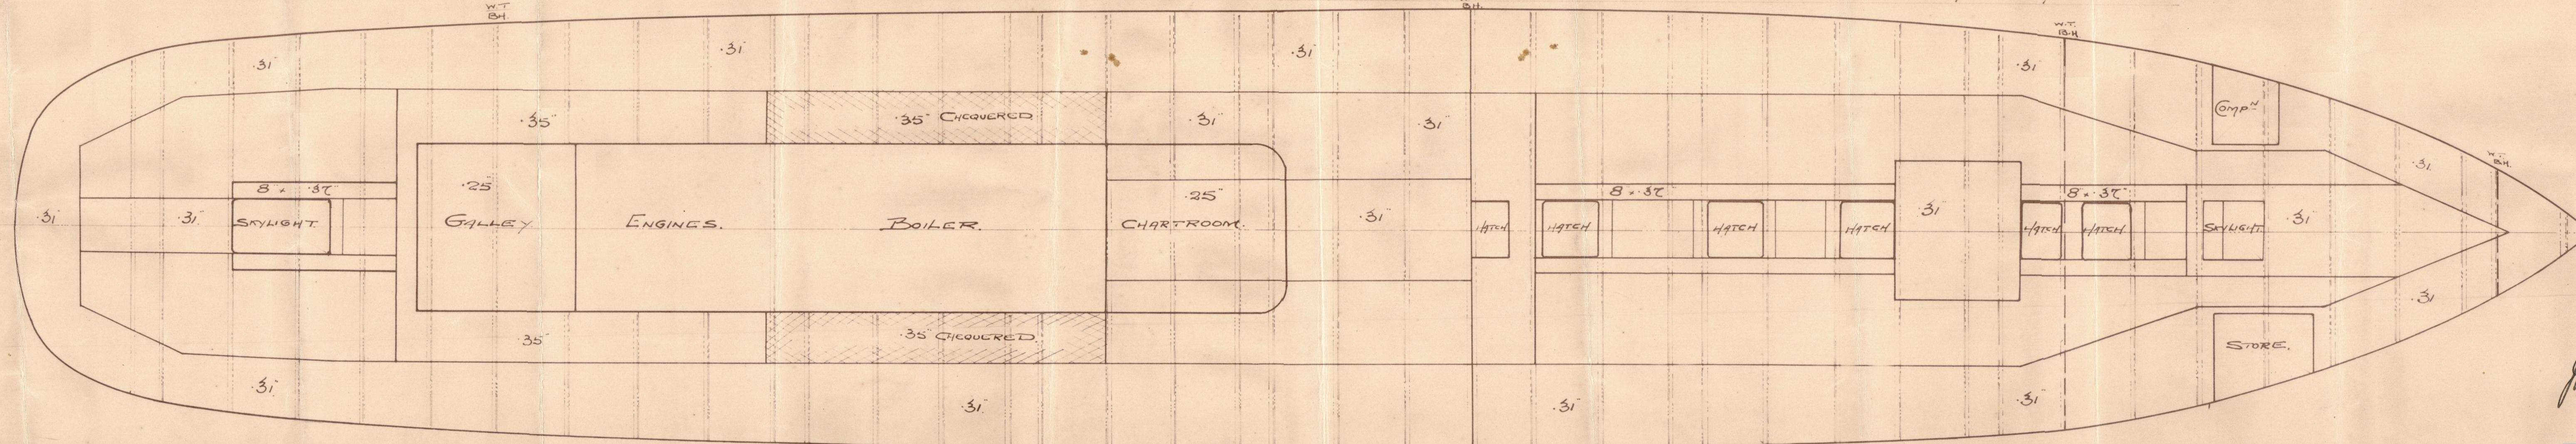

23.8.15




© 2020  
Lloyd's Register  
Foundation



PROFILE & DECK PLANS

COCHRANE & SONS LTD

Nº 658

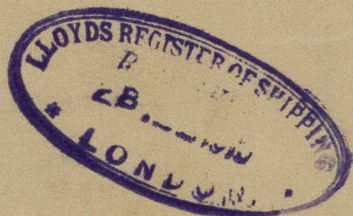

*5/5 Transvaal  
Hull Rpt No 29516*



© 2020

W273-0038  
Lloyd's Register  
Foundation