


Crank Shaft

for

Yard No. 266

by

M/s. Helsingør's Jernskibs-og Maskinfabrik  

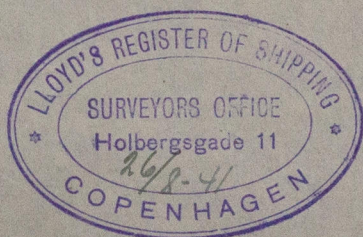

M/s. "Eros" af Helsingør  
Lp.m. Afd. No. M 348

Return



© 2020

Lloyd's Register  
Foundation

W278-0169



$$\frac{f}{f_s}$$

## MAIN ENGINE

signs  
from  
13/2  
fa.

Foundation