



Profile
(as built)

Sir Raylton Dixon & Co.

S.S. 584.

Emmery ex S.S. "Wolverton"

Trade Rpt. 8266.

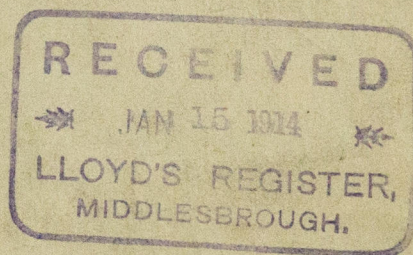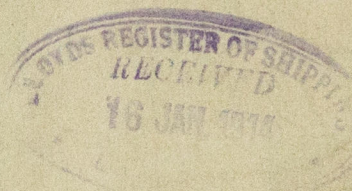

© 2021

Lloyd's Register
Foundation

W28-0194