



19.11.13

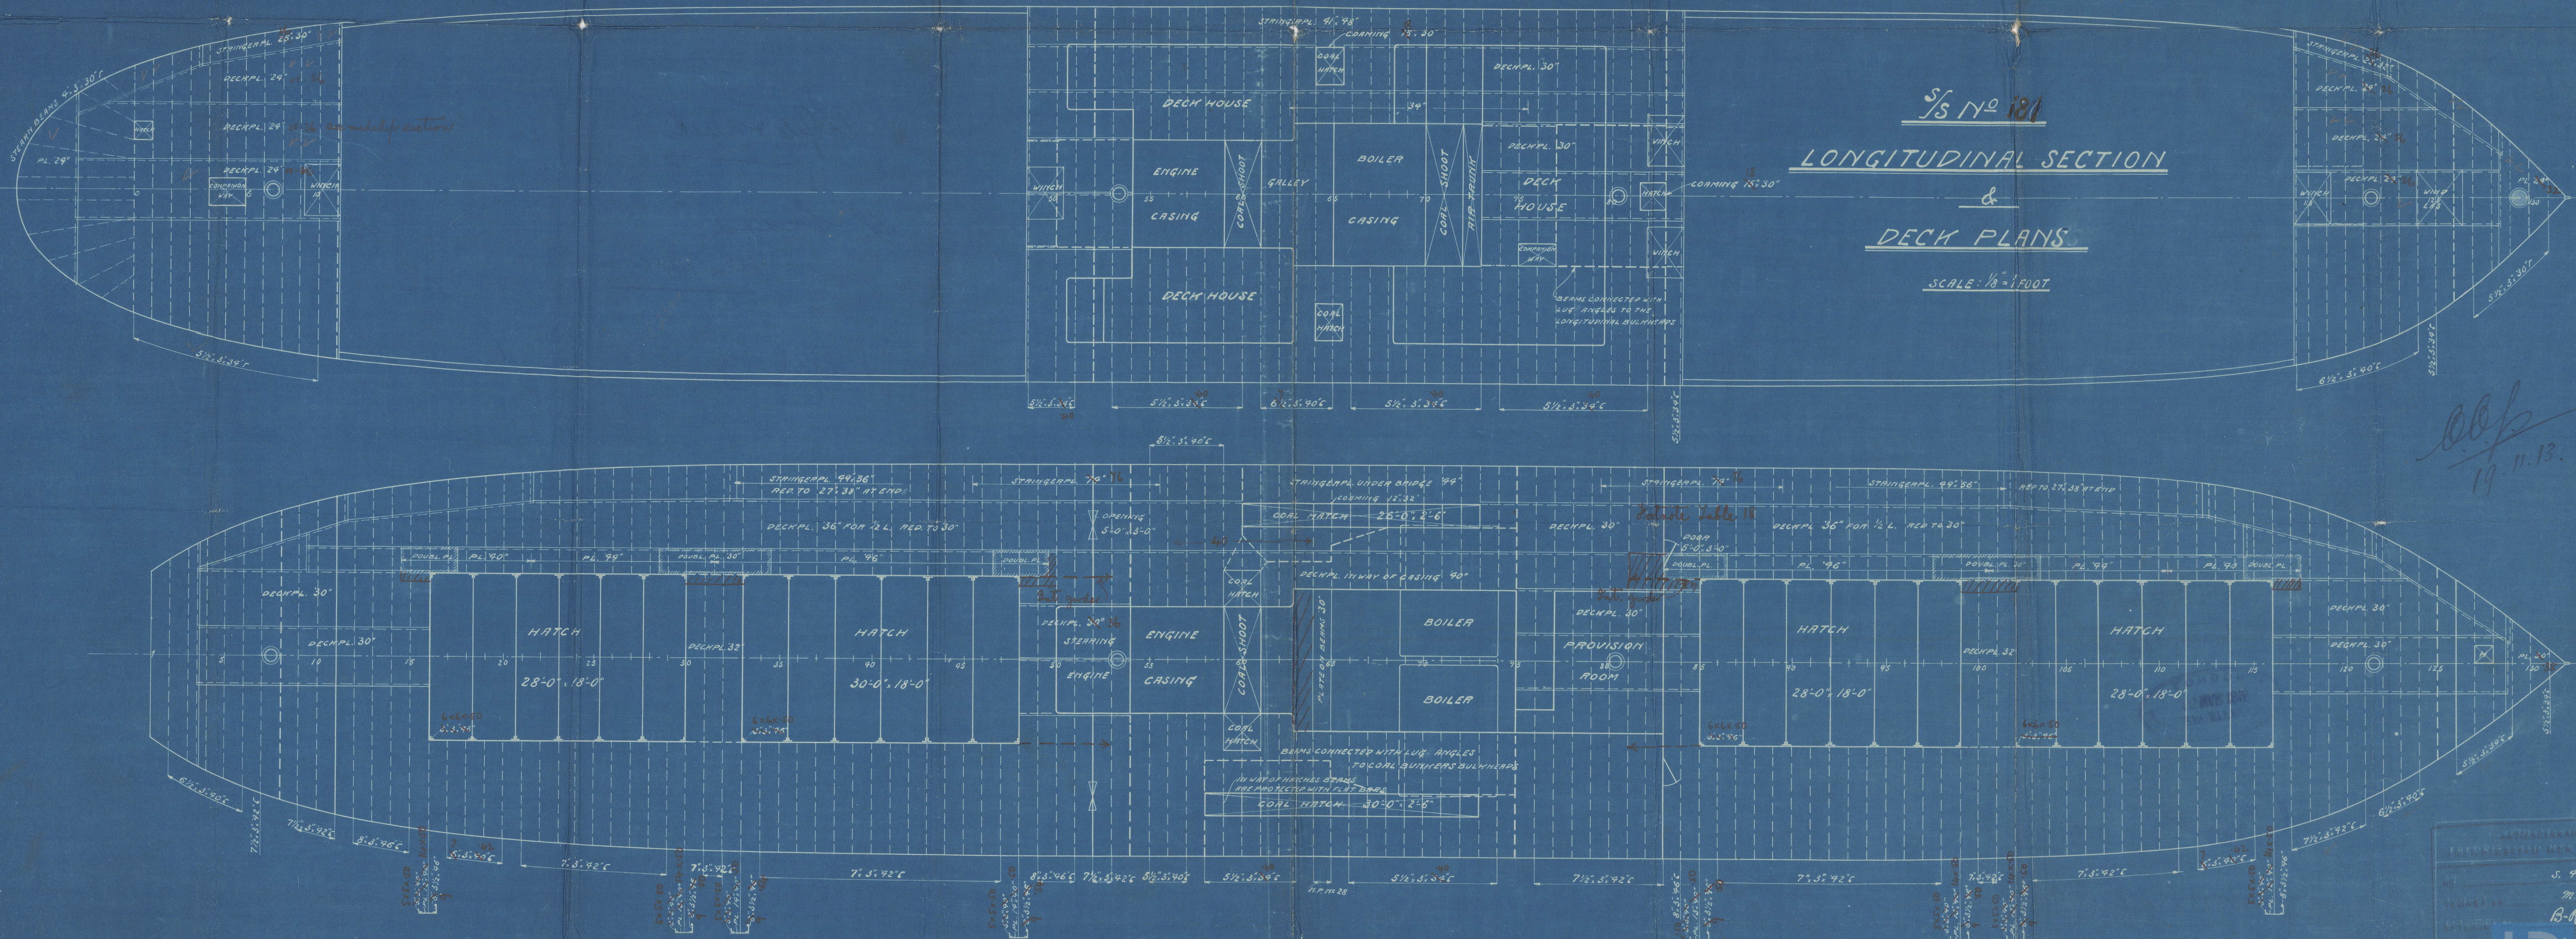

ccp
19.11.13.

DESIGNED BY	J. 9704
CHECKED BY	M. Holden
DATE	3-10-1914

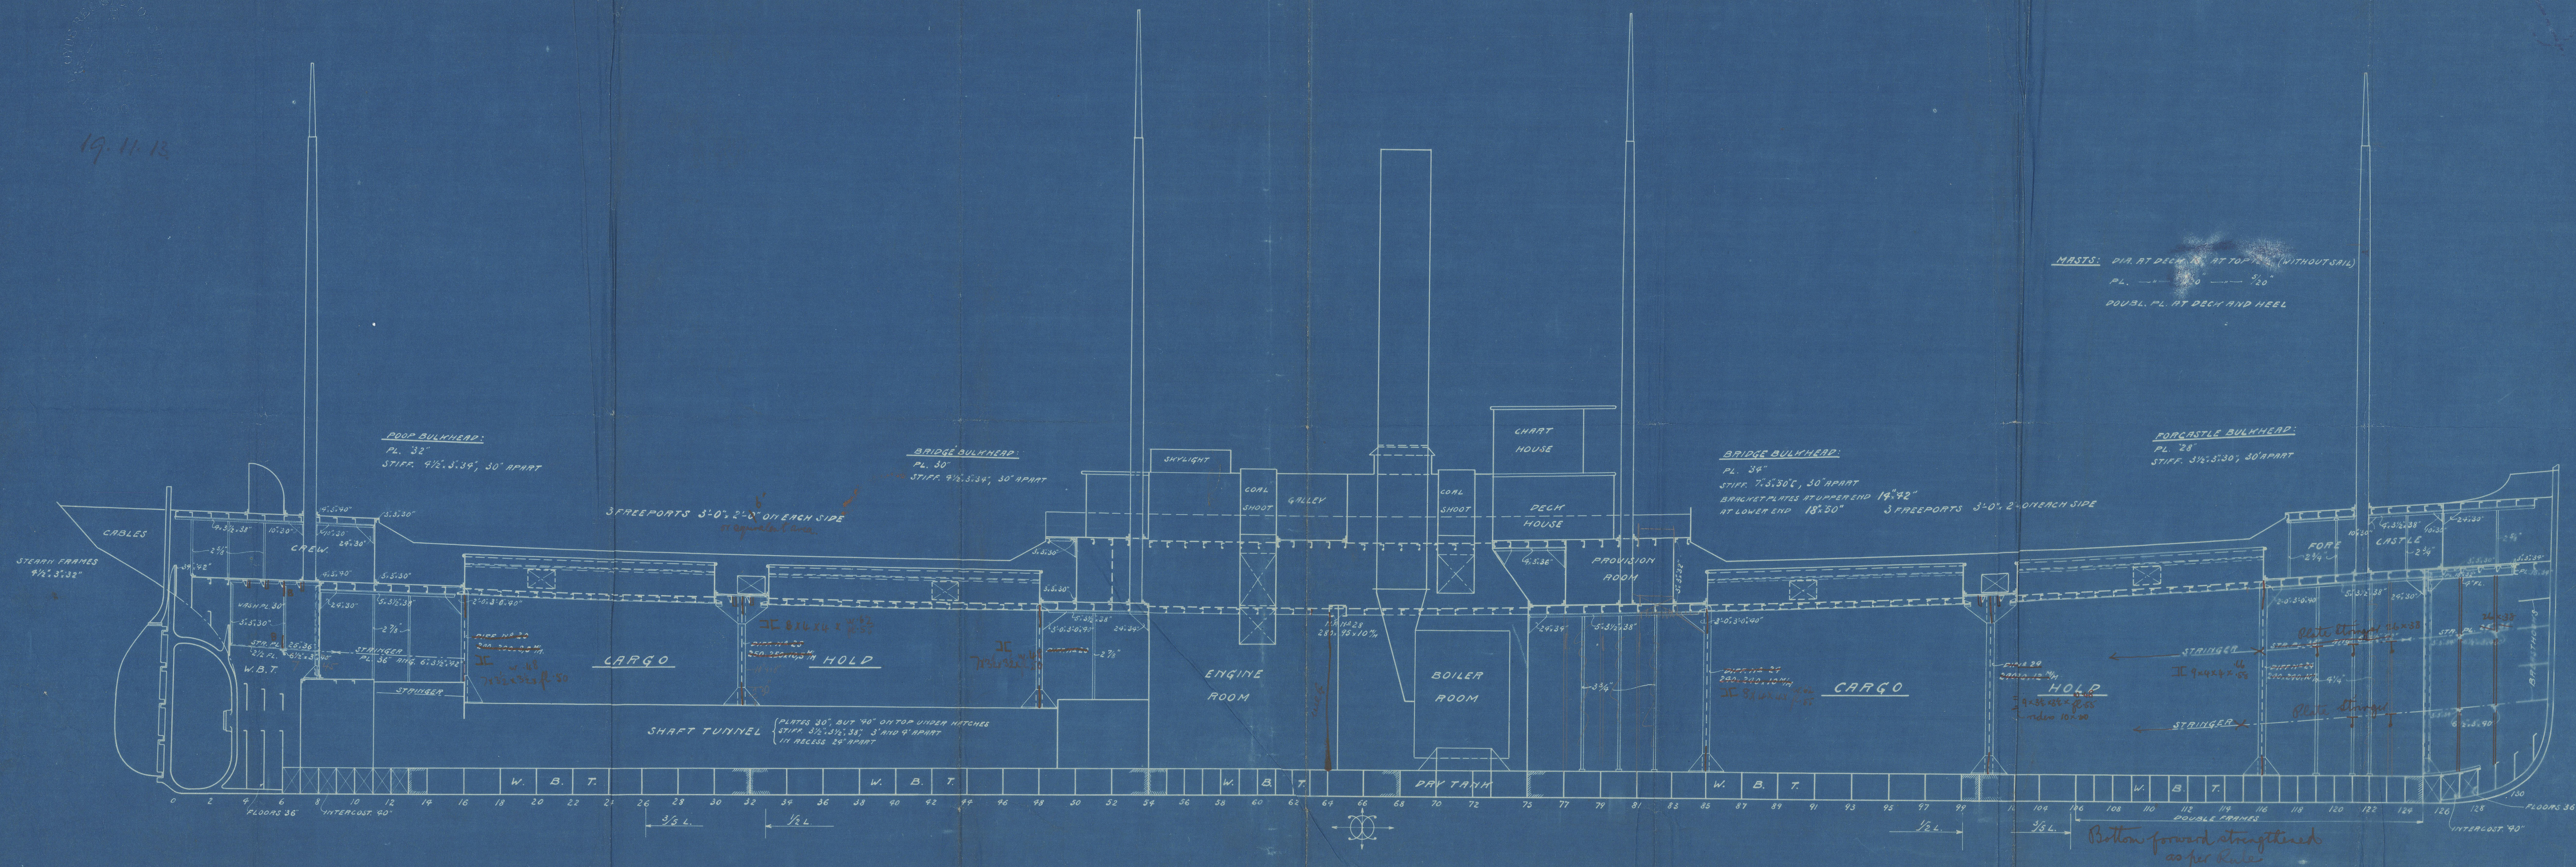

Profile & Deck
"Skard"
Dia 1456.
nn.
"Polfrborg"

W280-0073



© 2020

Lloyd's Register
Foundation

181
Longitudinal



Rolfsborg

Xia 1436.

made



© 2020

Lloyd's Register
Foundation