

N^o 574.

MIDSHIP SECTION.

DIMENSIONS 144'3"BP x 25'0"MLD x 15'0"MLD.

SCALE 2" = 1 FOOT

COOK, WELTON & GEMMELL LTD
SHIPBUILDERS
BEVERLEY

EQUIPMENT


1 STOCKLESS ANCHOR 9 CWTs ✓
" 8 1/2 " ✓
1 RODGERS " 3 1/2 " EX STOCK ✓
120 FATHOMS OF 1 1/4" STUD LINK CABLE ✓
60 " " 6" HAWSER ✓
60 " " 5" WARP ✓

NUMERALS

L x D = 2163.75 ✓
L x (B+D) = 5770.0 ✓
D = 150 ✓
B+D = 40.0 ✓

PROPORTIONS

L/D = 9.61 ✓
L/B = 5.77 ✓
L/d = 13.5 ✓

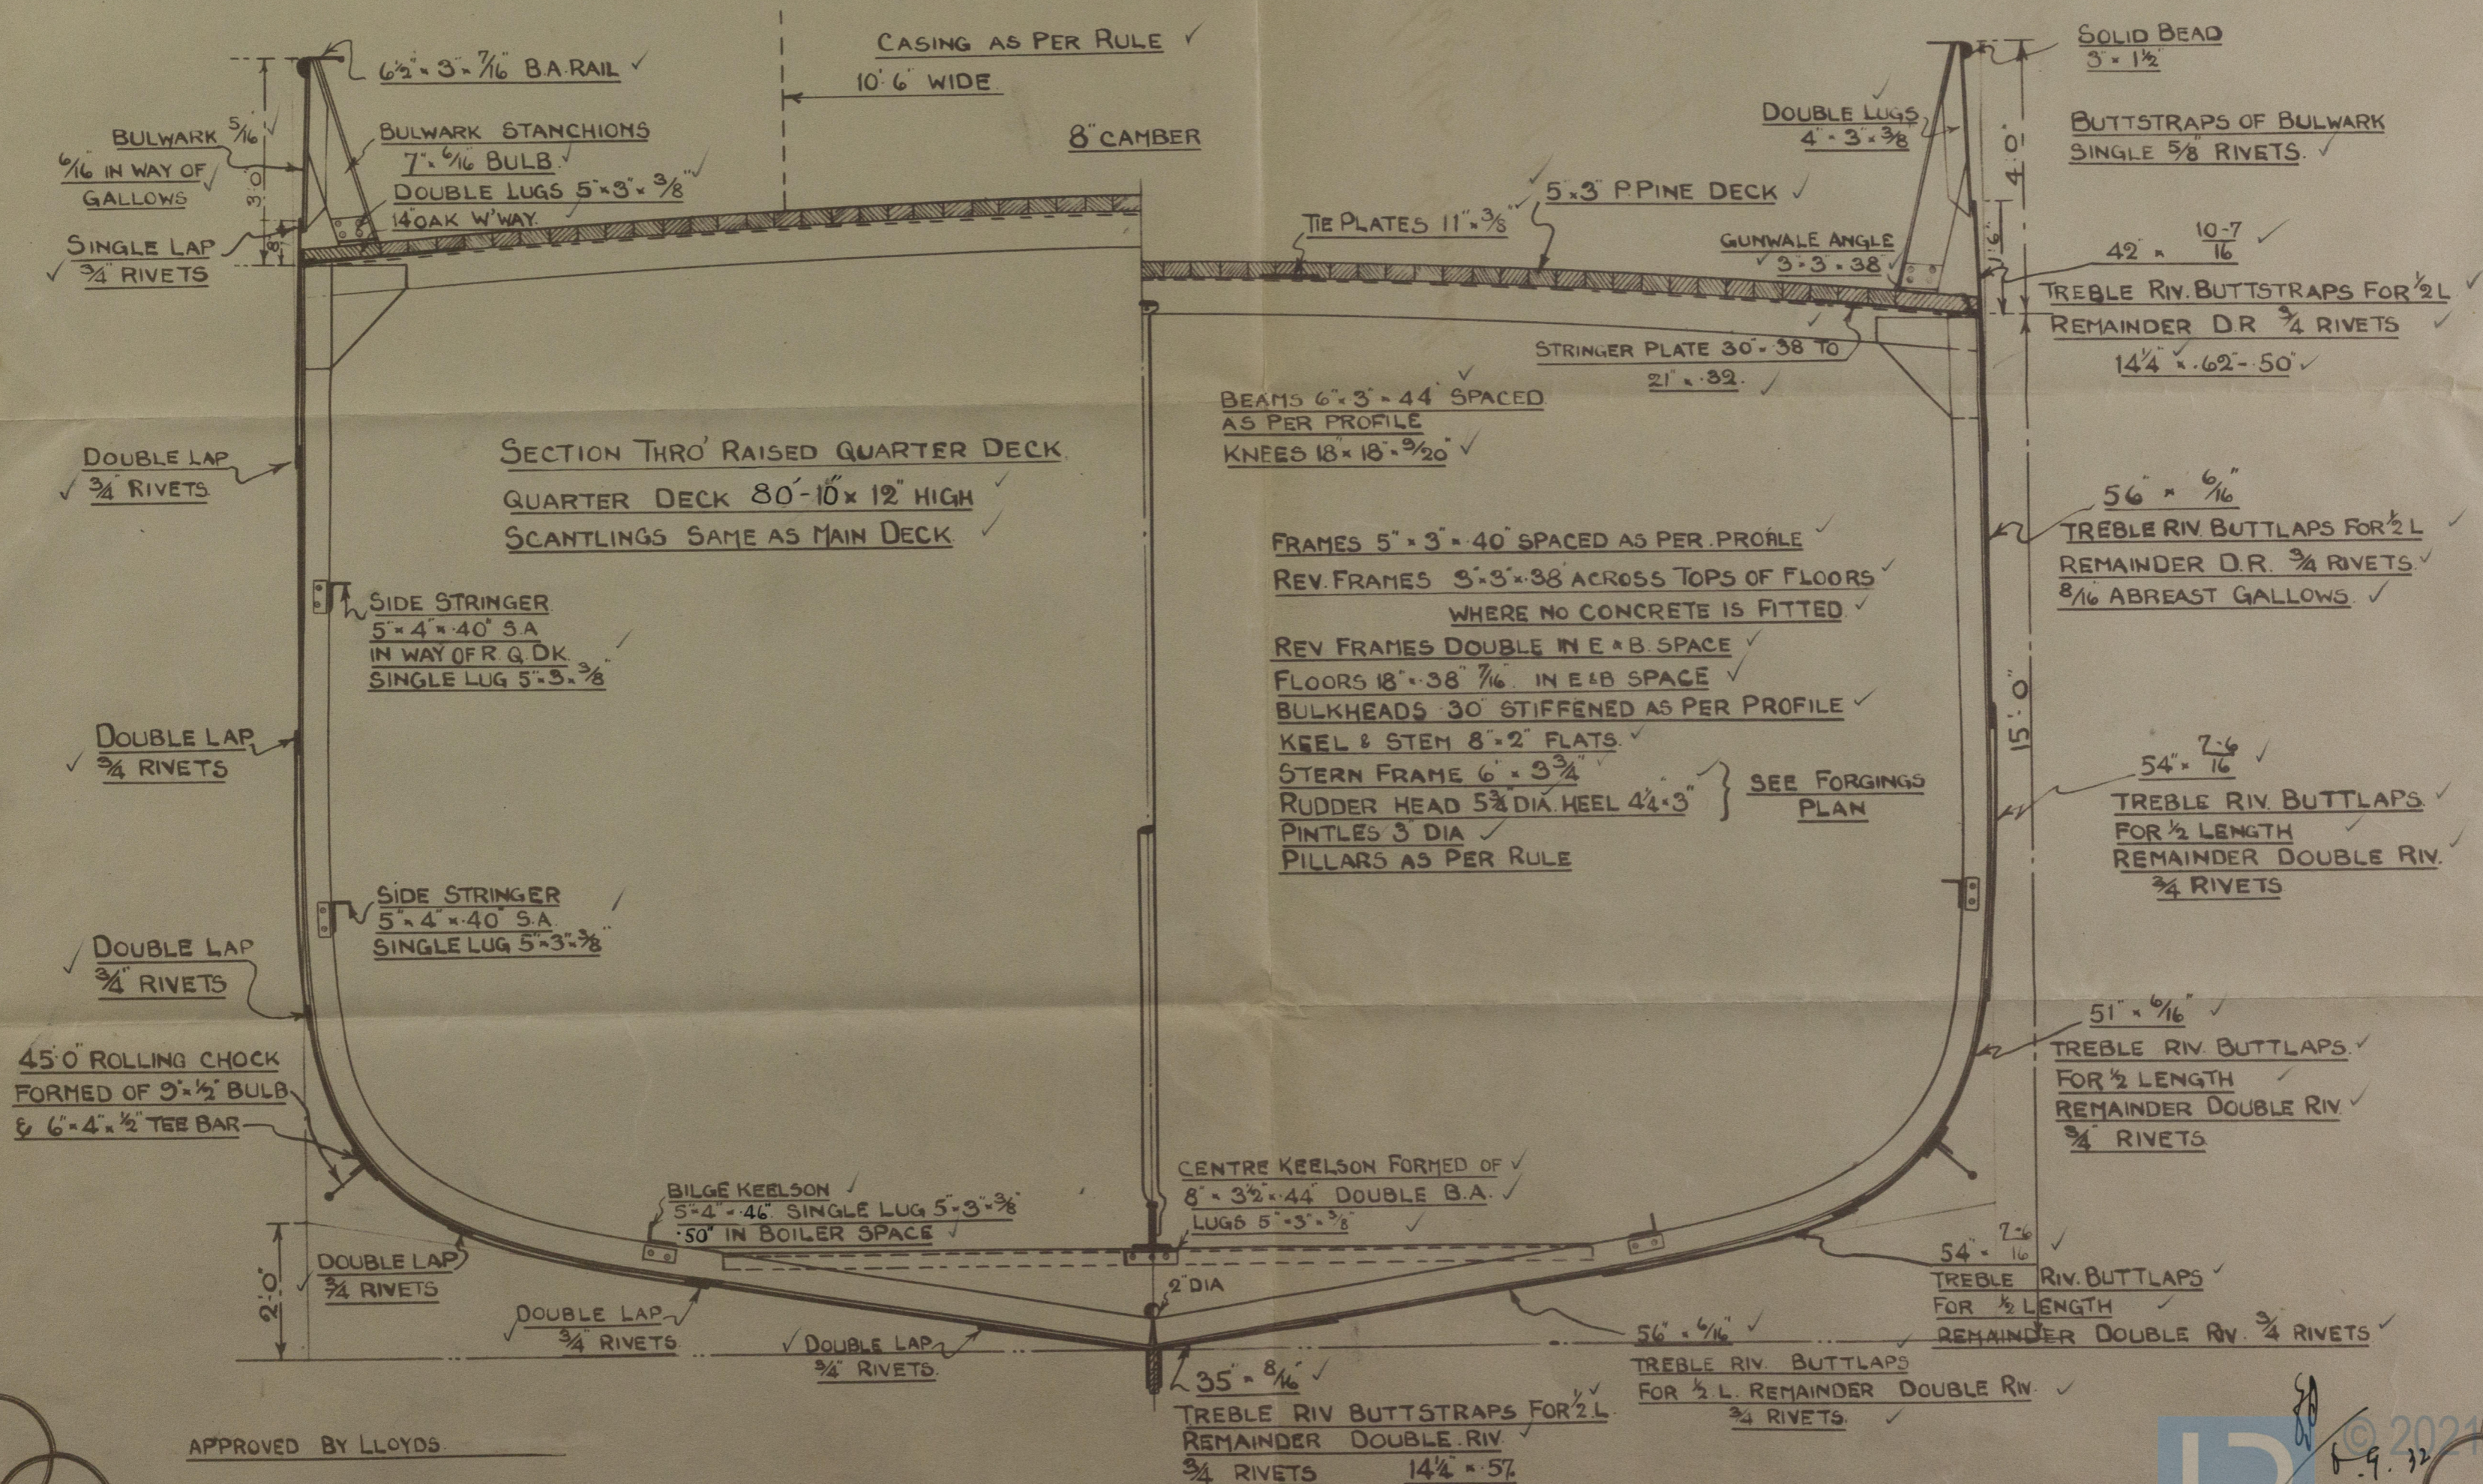

APPROVED BY LLOYDS

HULL

Cook, Welton & Gemmell,

N^o 574.

Madship Section

(Office Copy)

GEN. BCX NO 1206

["]
 $\frac{8}{5}$ Lifesnes["]

Hull 432857

W281-0031



© 2021

Lloyd's Register
Foundation