


PROFILE & DECKS

Nº 574


DIMENSIONS - 144' 3" BP x 25' 0" B M L x 15' 0" D M L

SCALE 1/4" = 1 FOOT

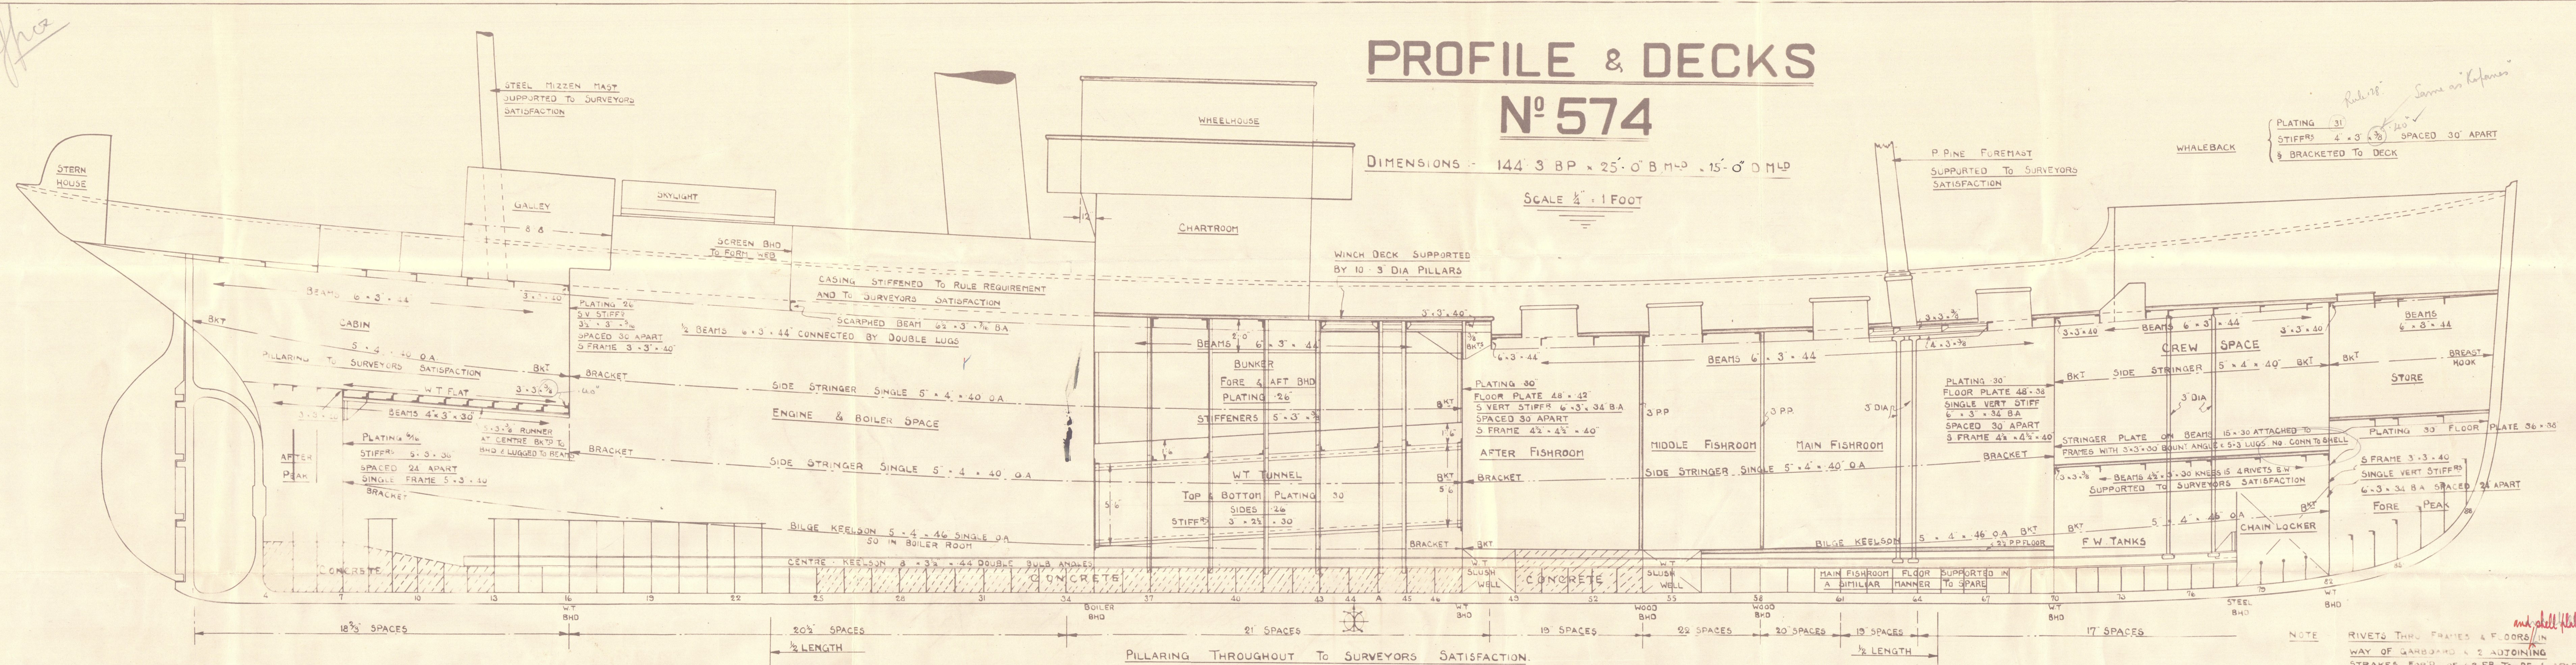

PLATING 31" STIFFERS 4' 3" x 3/8" SPACED 30" APART & BRACKETED TO DECK

NOTE RIVETS THRU FRAMES & FLOORS IN WAY OF GARBAGE & 2 ADJOINING STRAKES FOR 4' OF 63 FT TO BE 4" APART

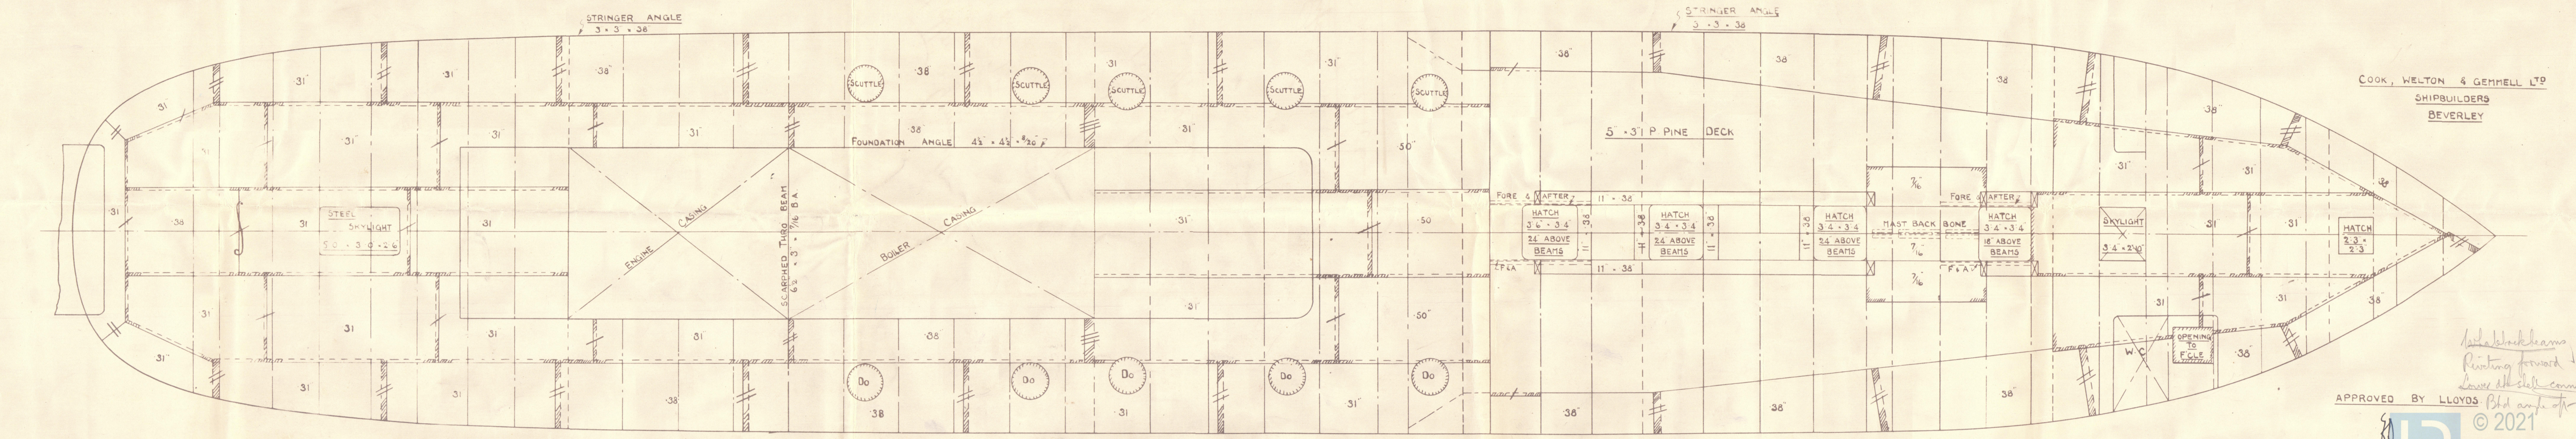

COOK, WELTON & GEMMELL LTD SHIPBUILDERS BEVERLEY

APPROVED BY LLOYD'S REGISTER

HULL.

Book, Welton & Gemmell.

N^o. 574

Profile and Secks

Duplicate print for
repetition in the London
office

(Office Copy)

Sⁿ Rifsmo Hull, 43285.

GEN. BOX NO 1206

W281-0033



© 2021

Lloyd's Register
Foundation