


— S. S. N<sup>o</sup>. 52

# MIDSHIP SECTION

SCALE  $\frac{1}{2}$  INCH = ONE FOOT.

TO CLASS 100 A.I. STEEL AT LLOYDS.

— LENGTH B.P. 145'-0" x 24'-0" MLD x 11'-6" MLD TO MAIN DECK. —

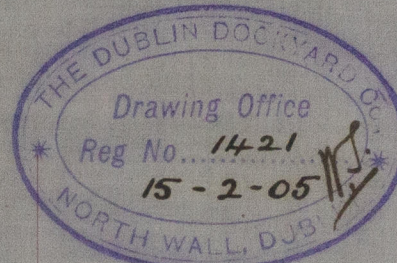

— ERECTIONS. —

R.Q. D<sup>s</sup>.  $51' \times 4' \times 2' = 408'$

BRIDGE  $12' \times 7' \times 1\frac{1}{2} = 126$  ✓

FORECAST  $24 \times 7 - 1\frac{1}{2} = 252$

786

## — PROPORTIONS. —

$$\frac{L}{D} \times \frac{143.96}{12} = 11.99$$
$$\frac{L}{B} = \frac{143.96}{24} = 5.99$$

— NUMERALS.

$\frac{1}{2}$  GIRTH 21.85

$\frac{1}{2}$  BREADTH 12.00

DEPTH 12.00 R.Q.D. 15.75.


1<sup>ST</sup>. Num. 45.85

143.96

2<sup>nd</sup> Num. 6600.56

+ 786.00 ✓

EQUIP. NUM. 7386.56 ✓

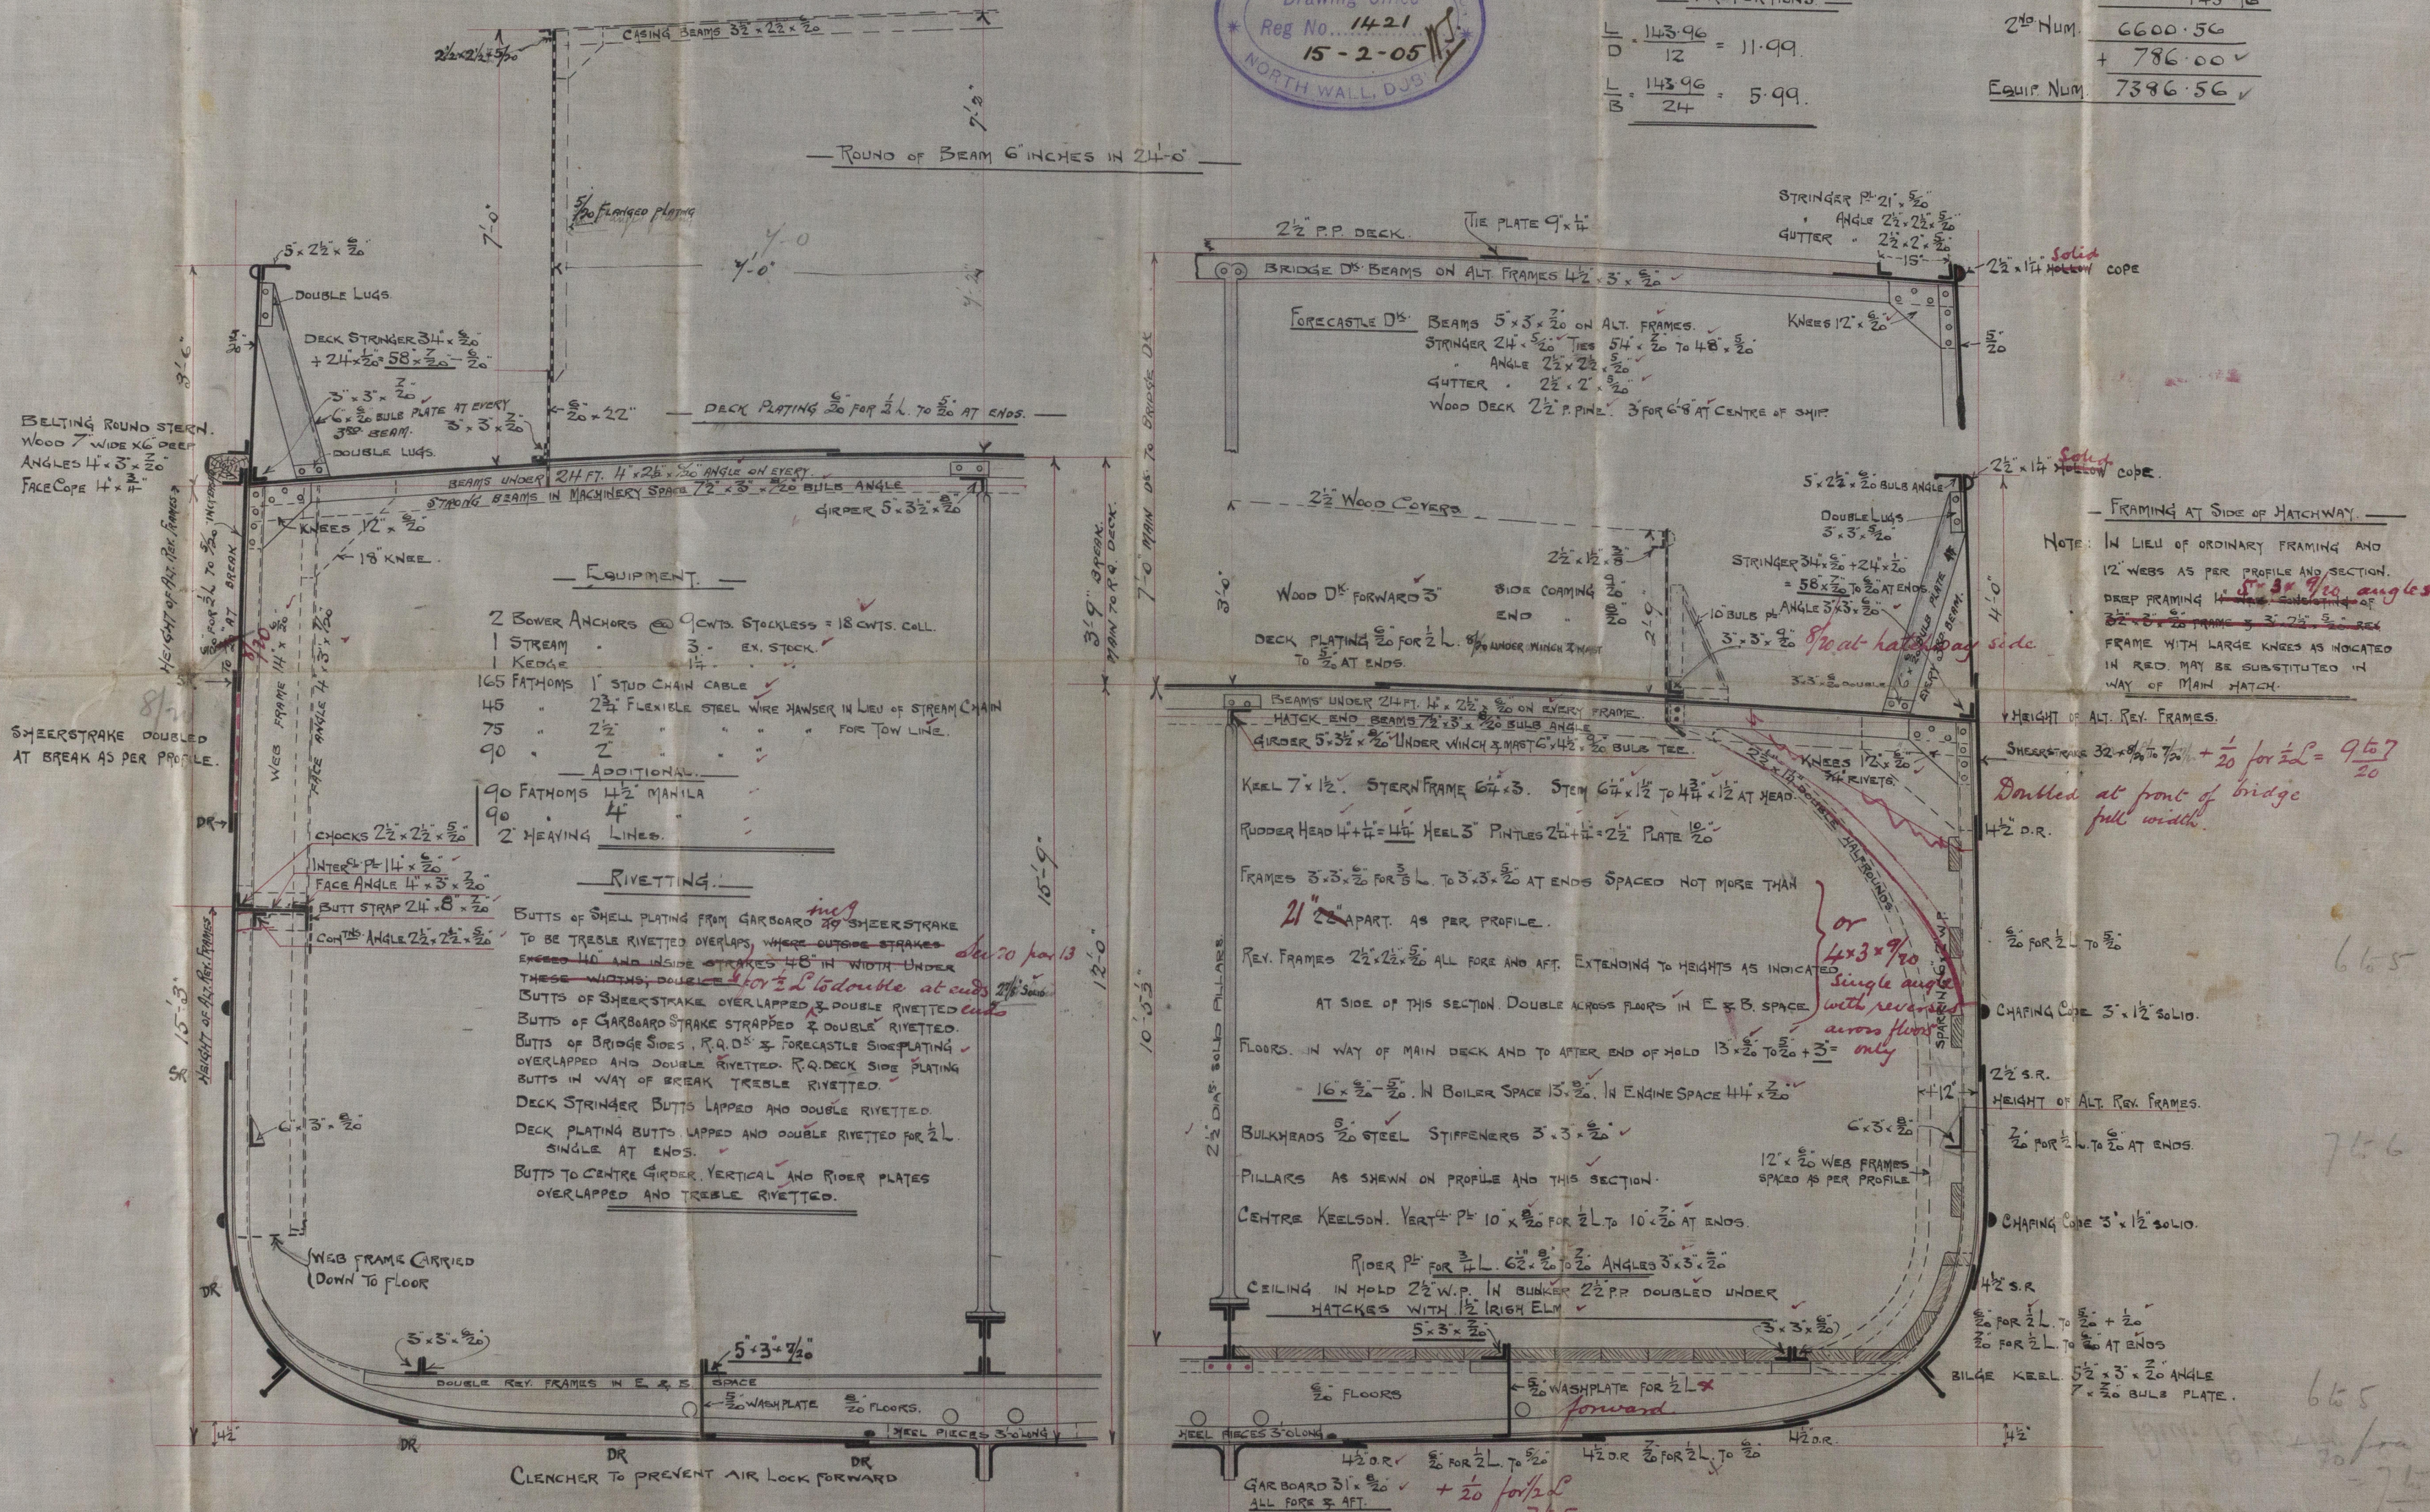

W282-0142



Dublin Dockyard Co.  
No 152

Mid Section  
SS Shellie

Dub Rpt No 2425



© 2020

Lloyd's Register  
Foundation