

18:3:05

CIRCUMFERENCE DOUBLE RIVETED  
1 1/2" HOLES 3 1/4" PITCH



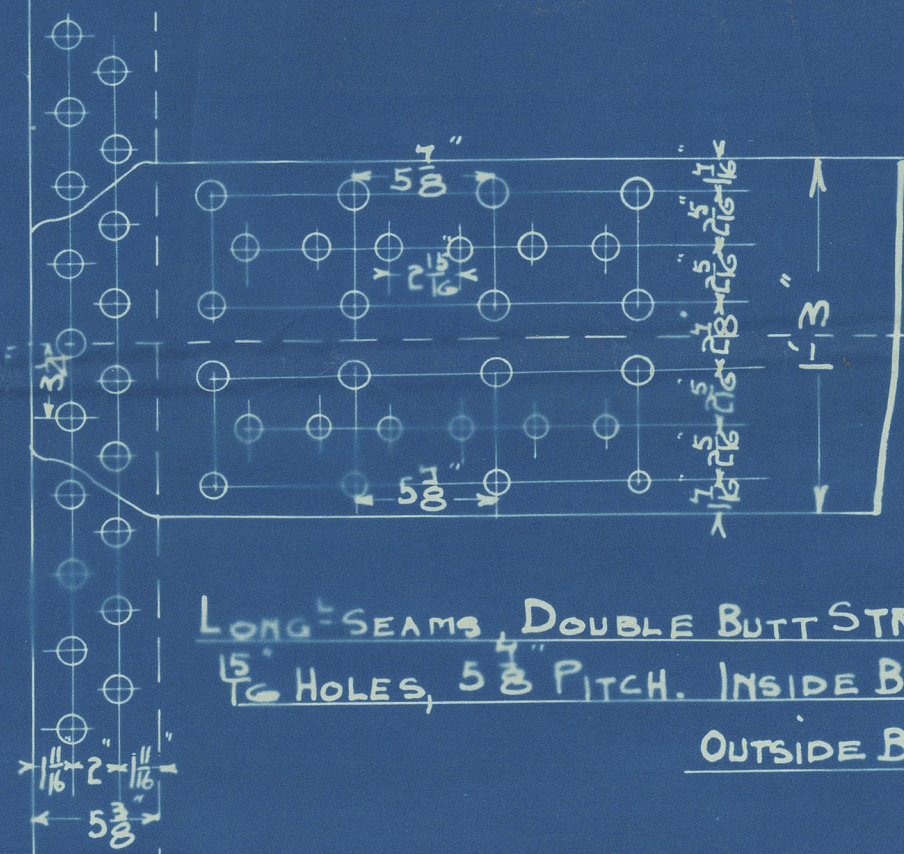


PLATE 84%  
RIVET 89 1/4%

LONG SEAMS DOUBLE BUTT STRAPS  
OUTSIDE BUTT STRAPS 1/2" THICK

STEEL PLATES, BARS & RIVETS,  
IRON TUBES & GIRDERS

SHELL PLATES, BUTT STRAPS & MANHOLE RING  
28 TO 32 TONS PER INCH.

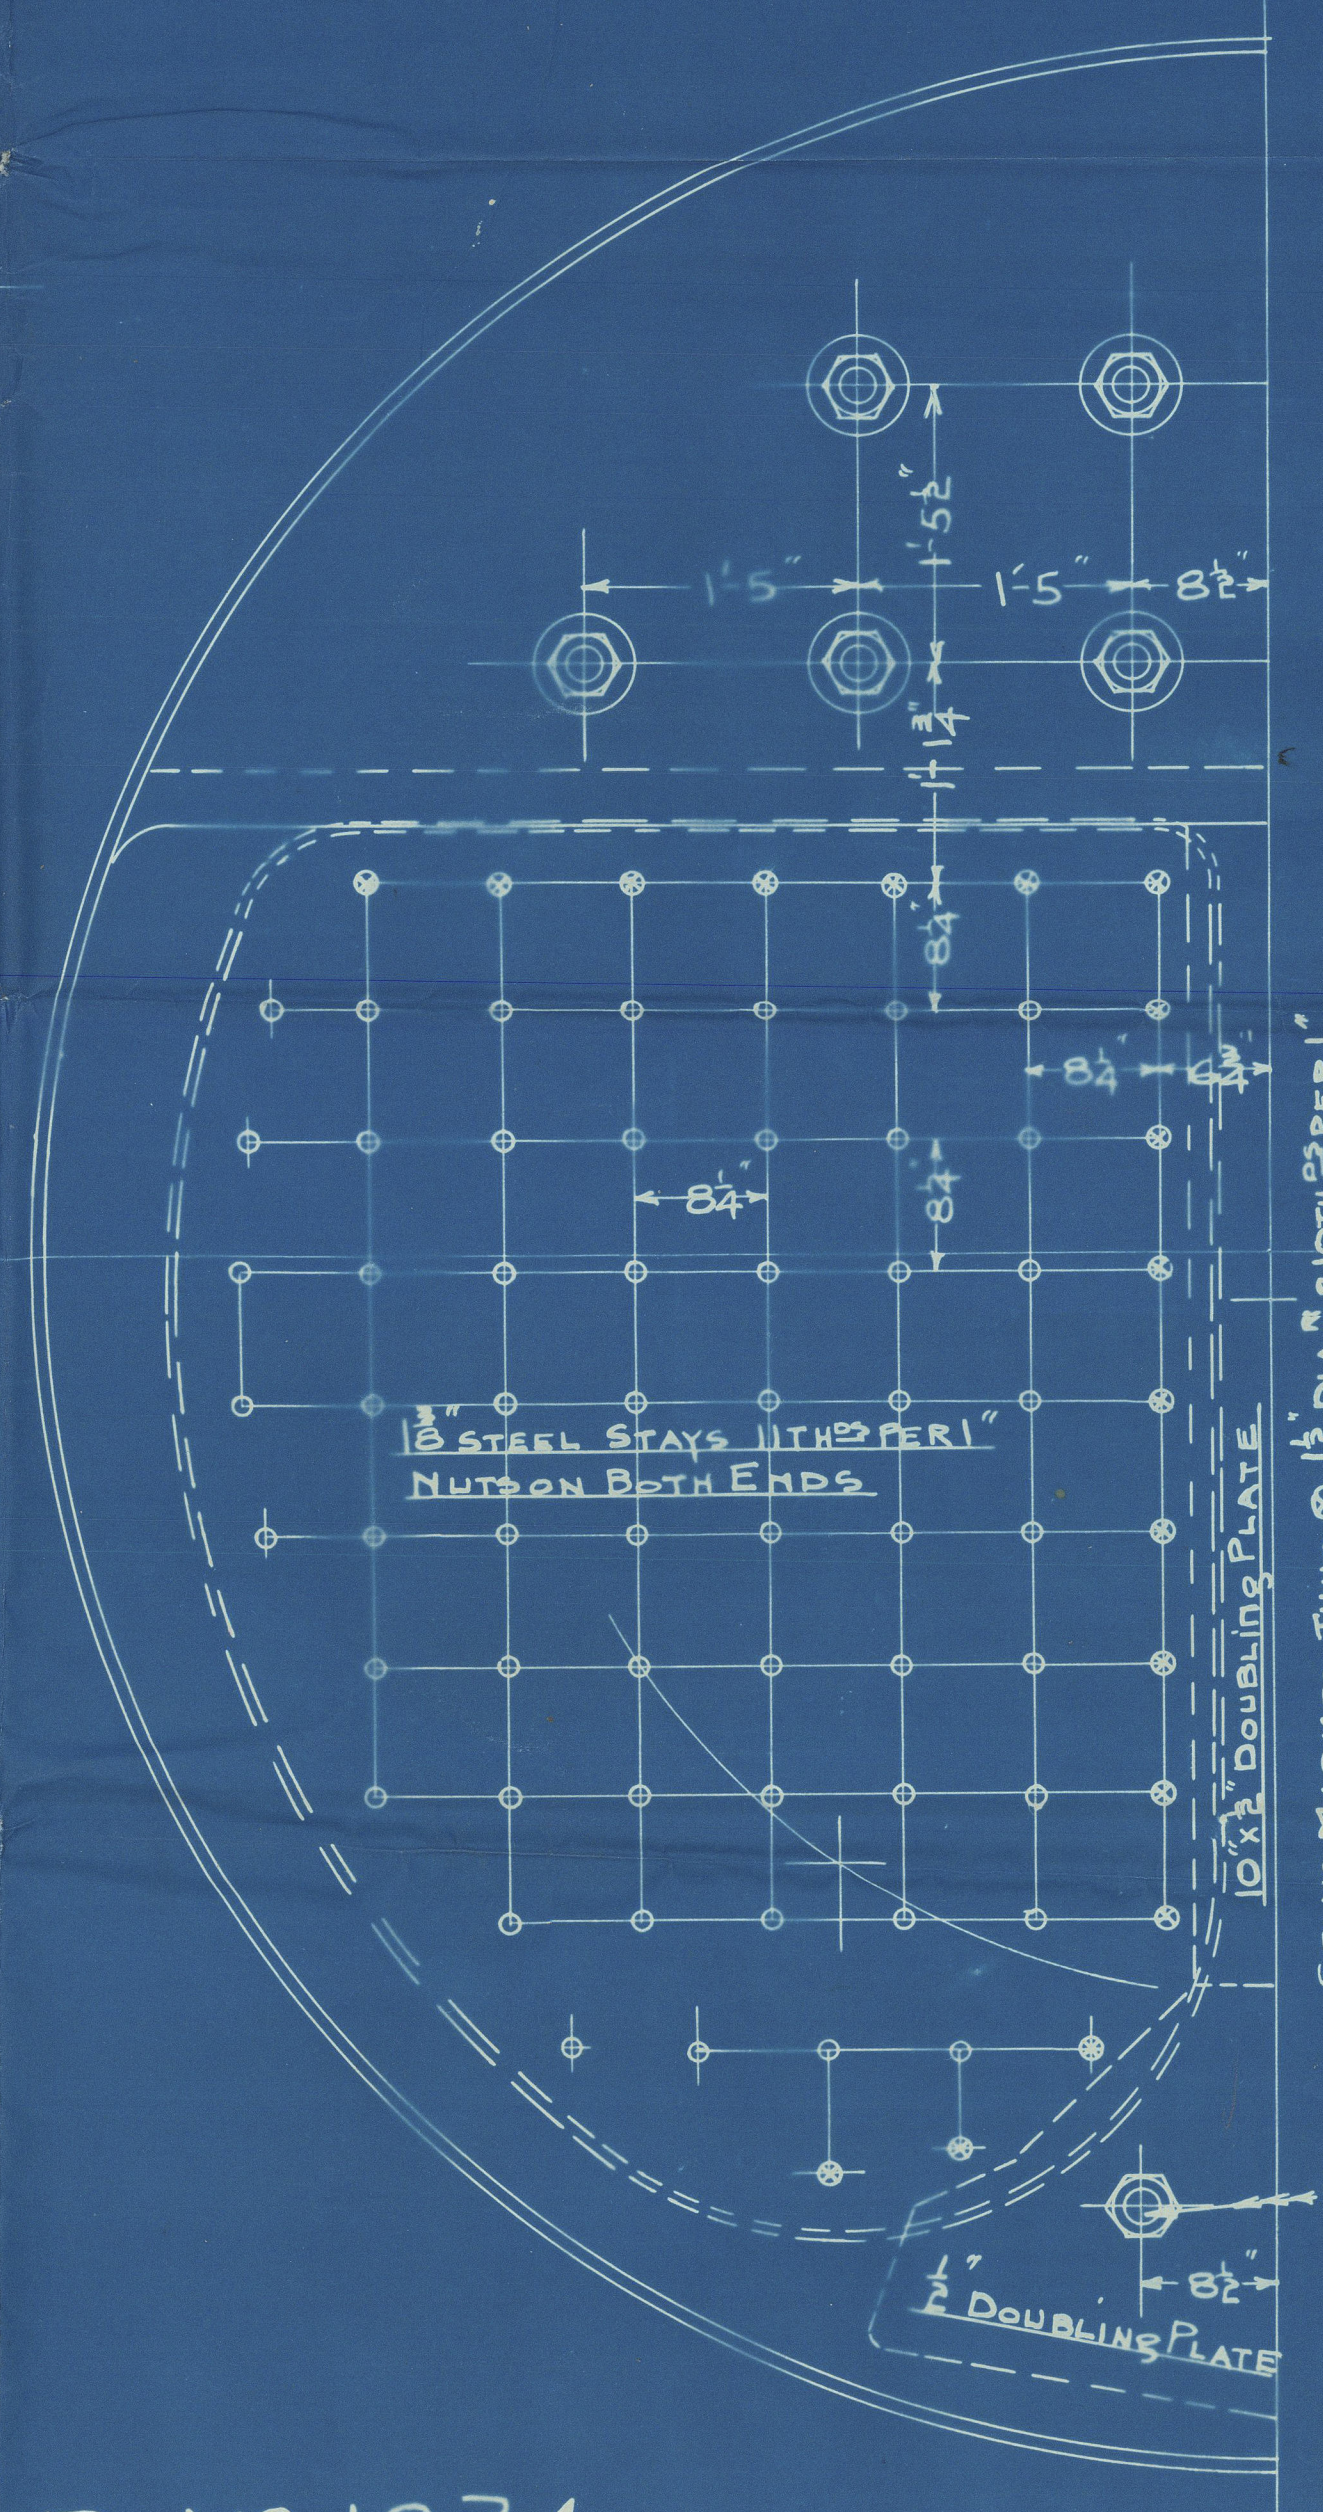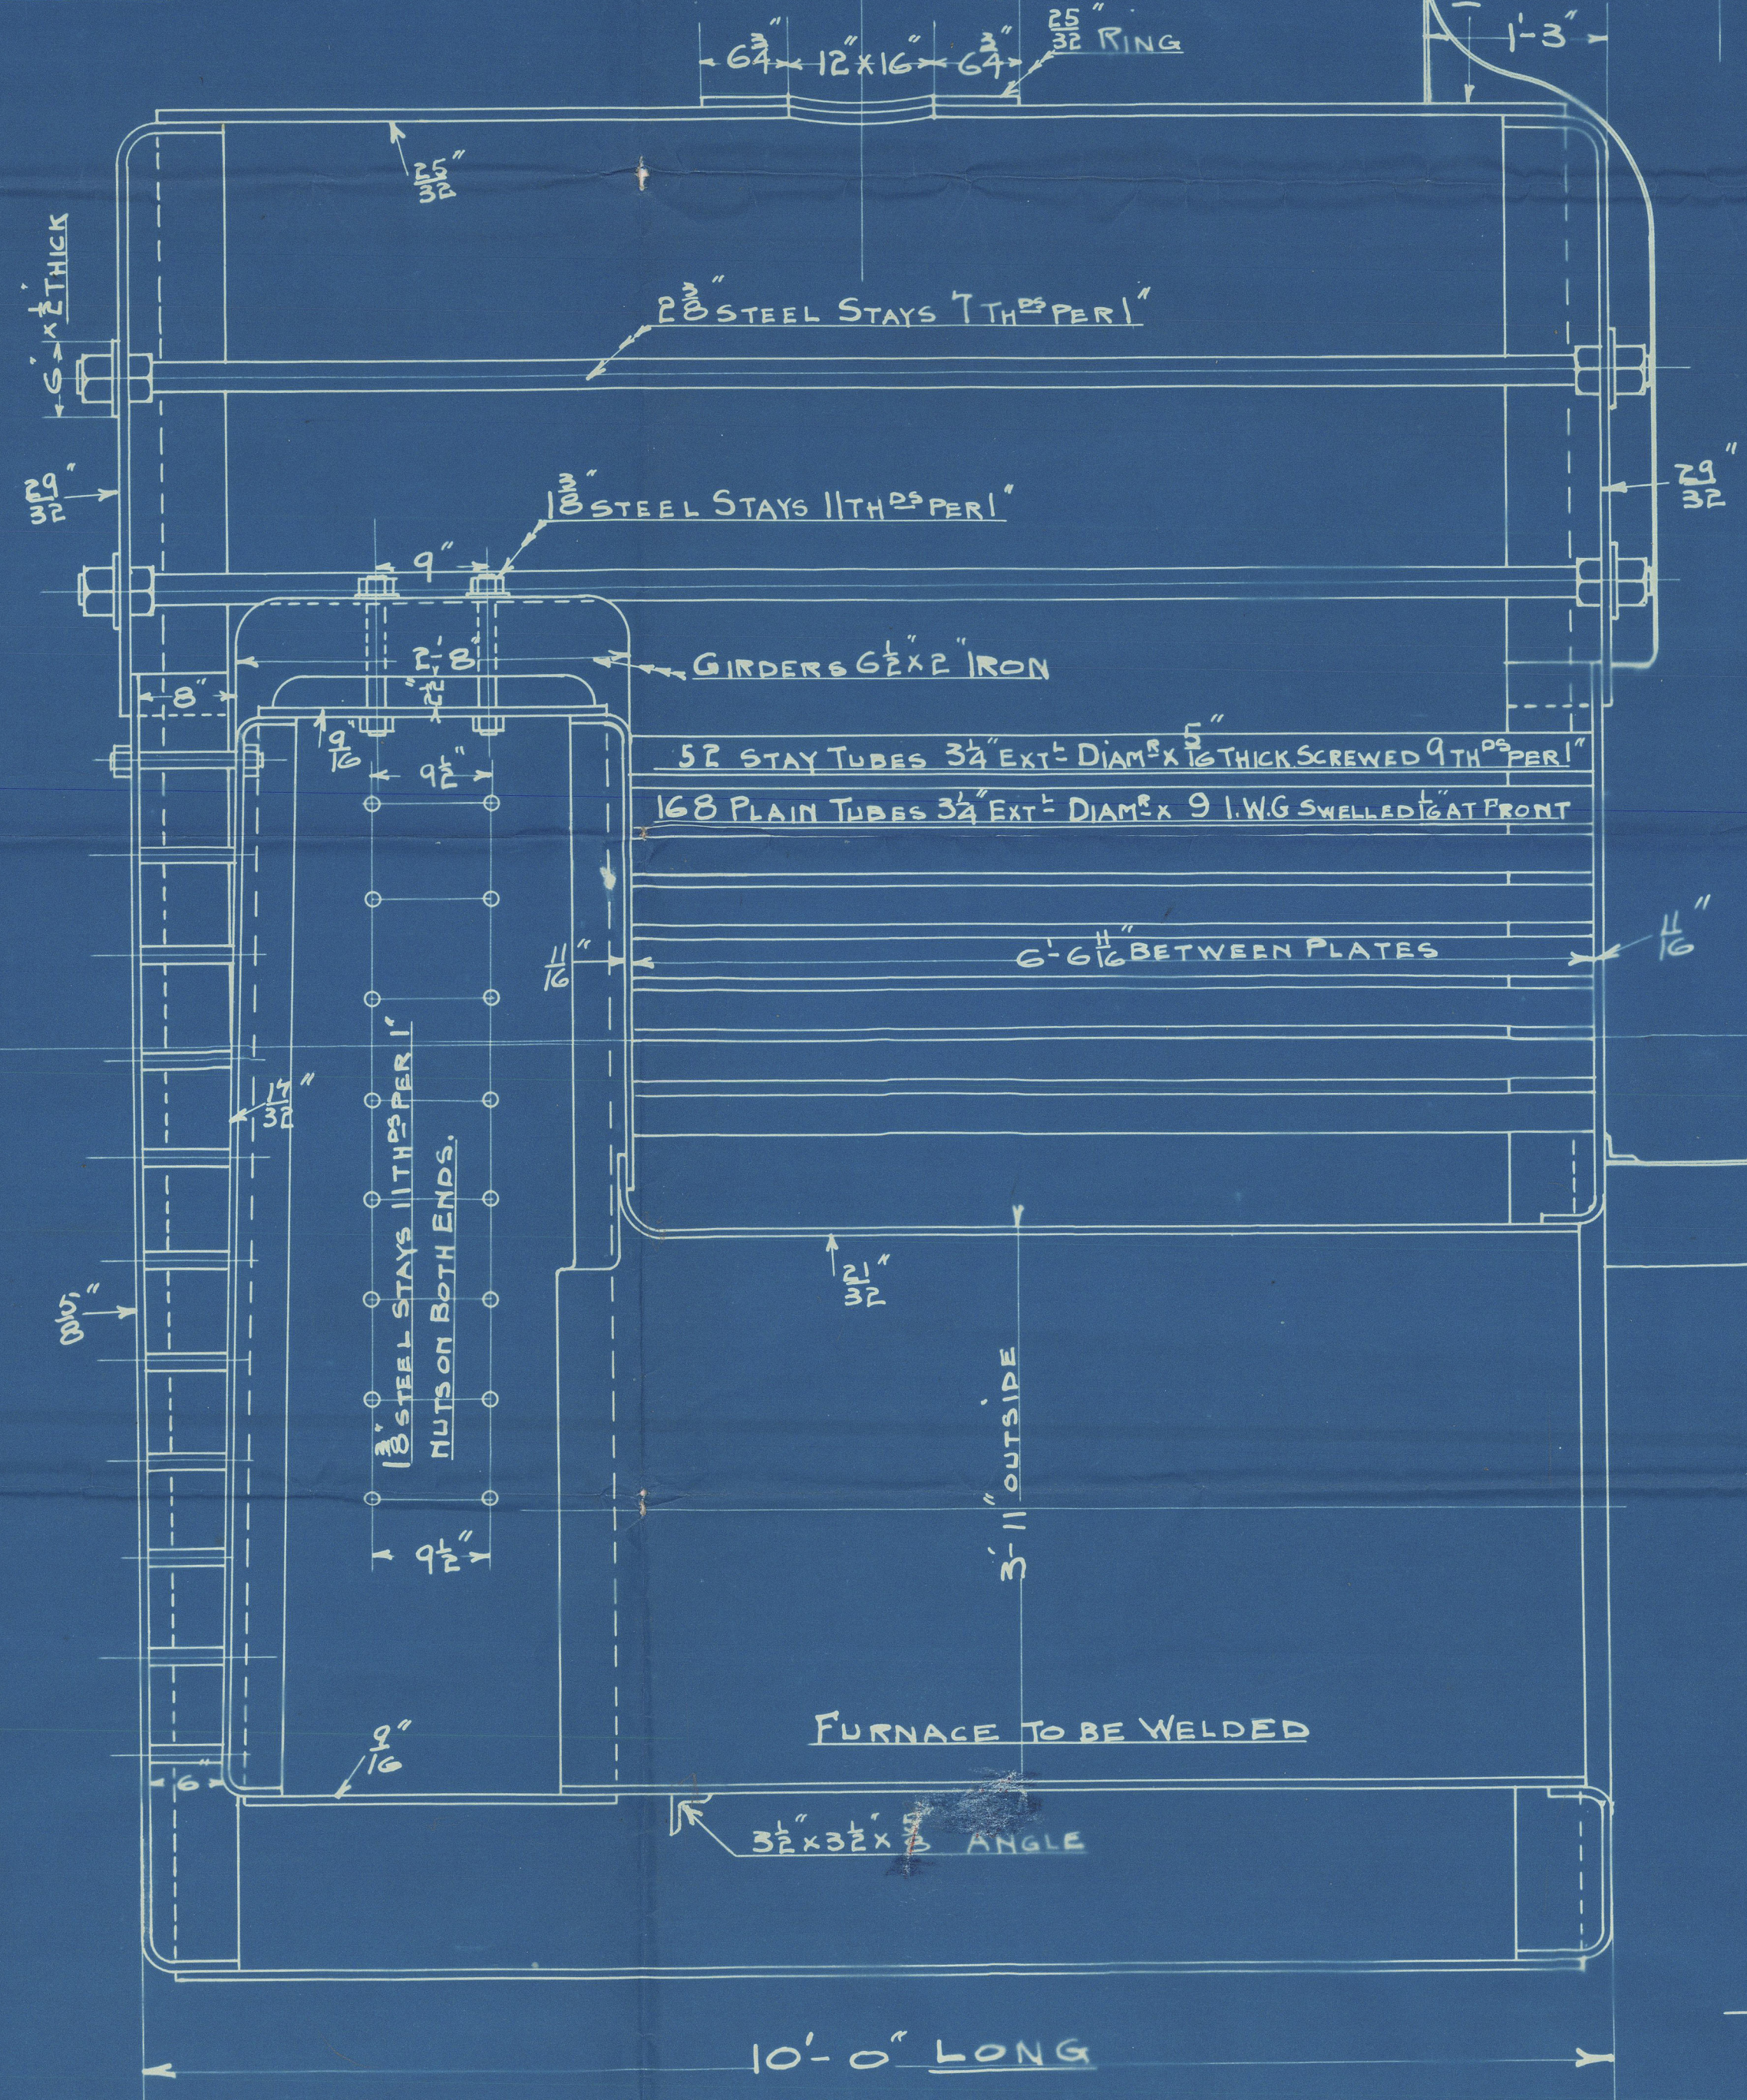

BOILER N° 1034

WORKING PRESSURE 125 LBS. PER INCH.

SCALE INCH - ONE FOOT

|                      |       |          |
|----------------------|-------|----------|
| GRATE SURFACE        | --    | 40 #     |
| TUBE HEATING SURFACE | --    | 1249 #   |
| OTHER                | --    | 225.5 #  |
| TOTAL                | --    | 1474.5 # |
| T.H.S. =             | 3685. |          |

TO HAVE LLOYD'S CERTIFICATE

17/3/05  
17/3/05



Ron & Duncan's  
No 1034 Boiler

For by 647

Dublin Dryd Co's No 52.



WP 125


No 7663  
Lloyds list  
250 lbs  
25/8/05 TLT

*[Handwritten signature]*

S.S. Shellie

Gls. nkt. No. 23347.

Dub. 2425

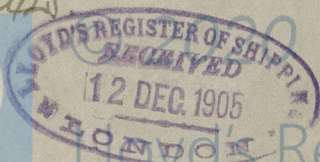

Lloyd's Register  
Foundation

W282-00434