


[illegible]

Bottoms strengthened forward as
per rule & to the surveyors satisfaction

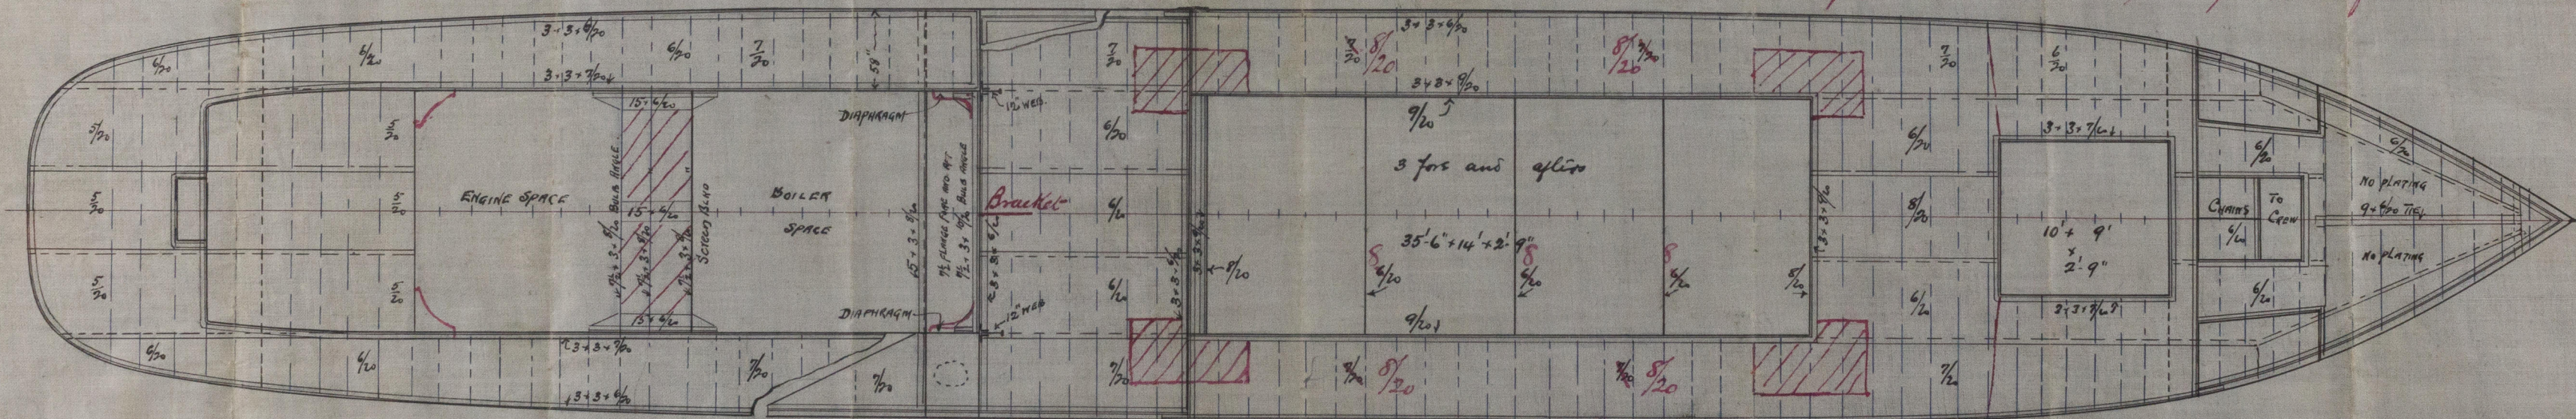

PROFILE AND DECK PLANS S.S. No. 52
145' x 24' x 11'-6" M.L.B.
SCALE 1/8" = 1 FOOT

C.D.
22.2.05.



Lloyd's Register
Foundation

N 282-0043

Dublin Dockyard Co
No 52

Profile & Deck

S S Shellie

Out Rpt. No 2425

W 282-0043



© 2020

Lloyd's Register
Foundation