

MIDSHIP SECTION

STEAM SCREW TRAWLERS

NOS 1203 - 4 & 5

175'-0" B.P. x 30'-0" MLD. x 16'-0" MLD.
TO CLASS 100.A.I. STEAM TRAWLER.

SCALE $\frac{1}{2}$ IN = 1 FT.

NUMERALS

L x D ----- 2800
L x (B + D) ----- 8050

EQUIPMENT

1ST BOWER ANCHOR 13 CWTs. STOCKLESS
2ND " " 12 " "
KEDGE " 4 1/2 " EX. STOCK
150 FMS 1 5/16" STUD LINK CABLE
60 " 6" HAWSER
60 " 6" WARP.

RIVETING


ALL LANDING EDGES TO BE DOUBLE RIVETTED
EXCEPT TOP EDGE OF SHEER STRAKE WHICH IS
TO BE SINGLE RIVETTED

BUTTS OF GARBOARD AND SHEER STRAKE STRAPPED
AND TREBLE RIVETTED FOR 1/2 LENGTH, STRAPPED
AND DOUBLE RIVETTED AT ENDS

BUTTS OF E & F STRAKES OVERLAPPED AND TREBLE
RIVETTED FOR 1/2 LENGTH, OVERLAPPED AND DOUBLE
RIVETTED AT ENDS.

REMAINDER OF BUTTS OVERLAPPED AND DOUBLE
RIVETTED ALL FORE & AFT.

SHELL RIVETS TO BE STEEL, REMAINDER IRON.

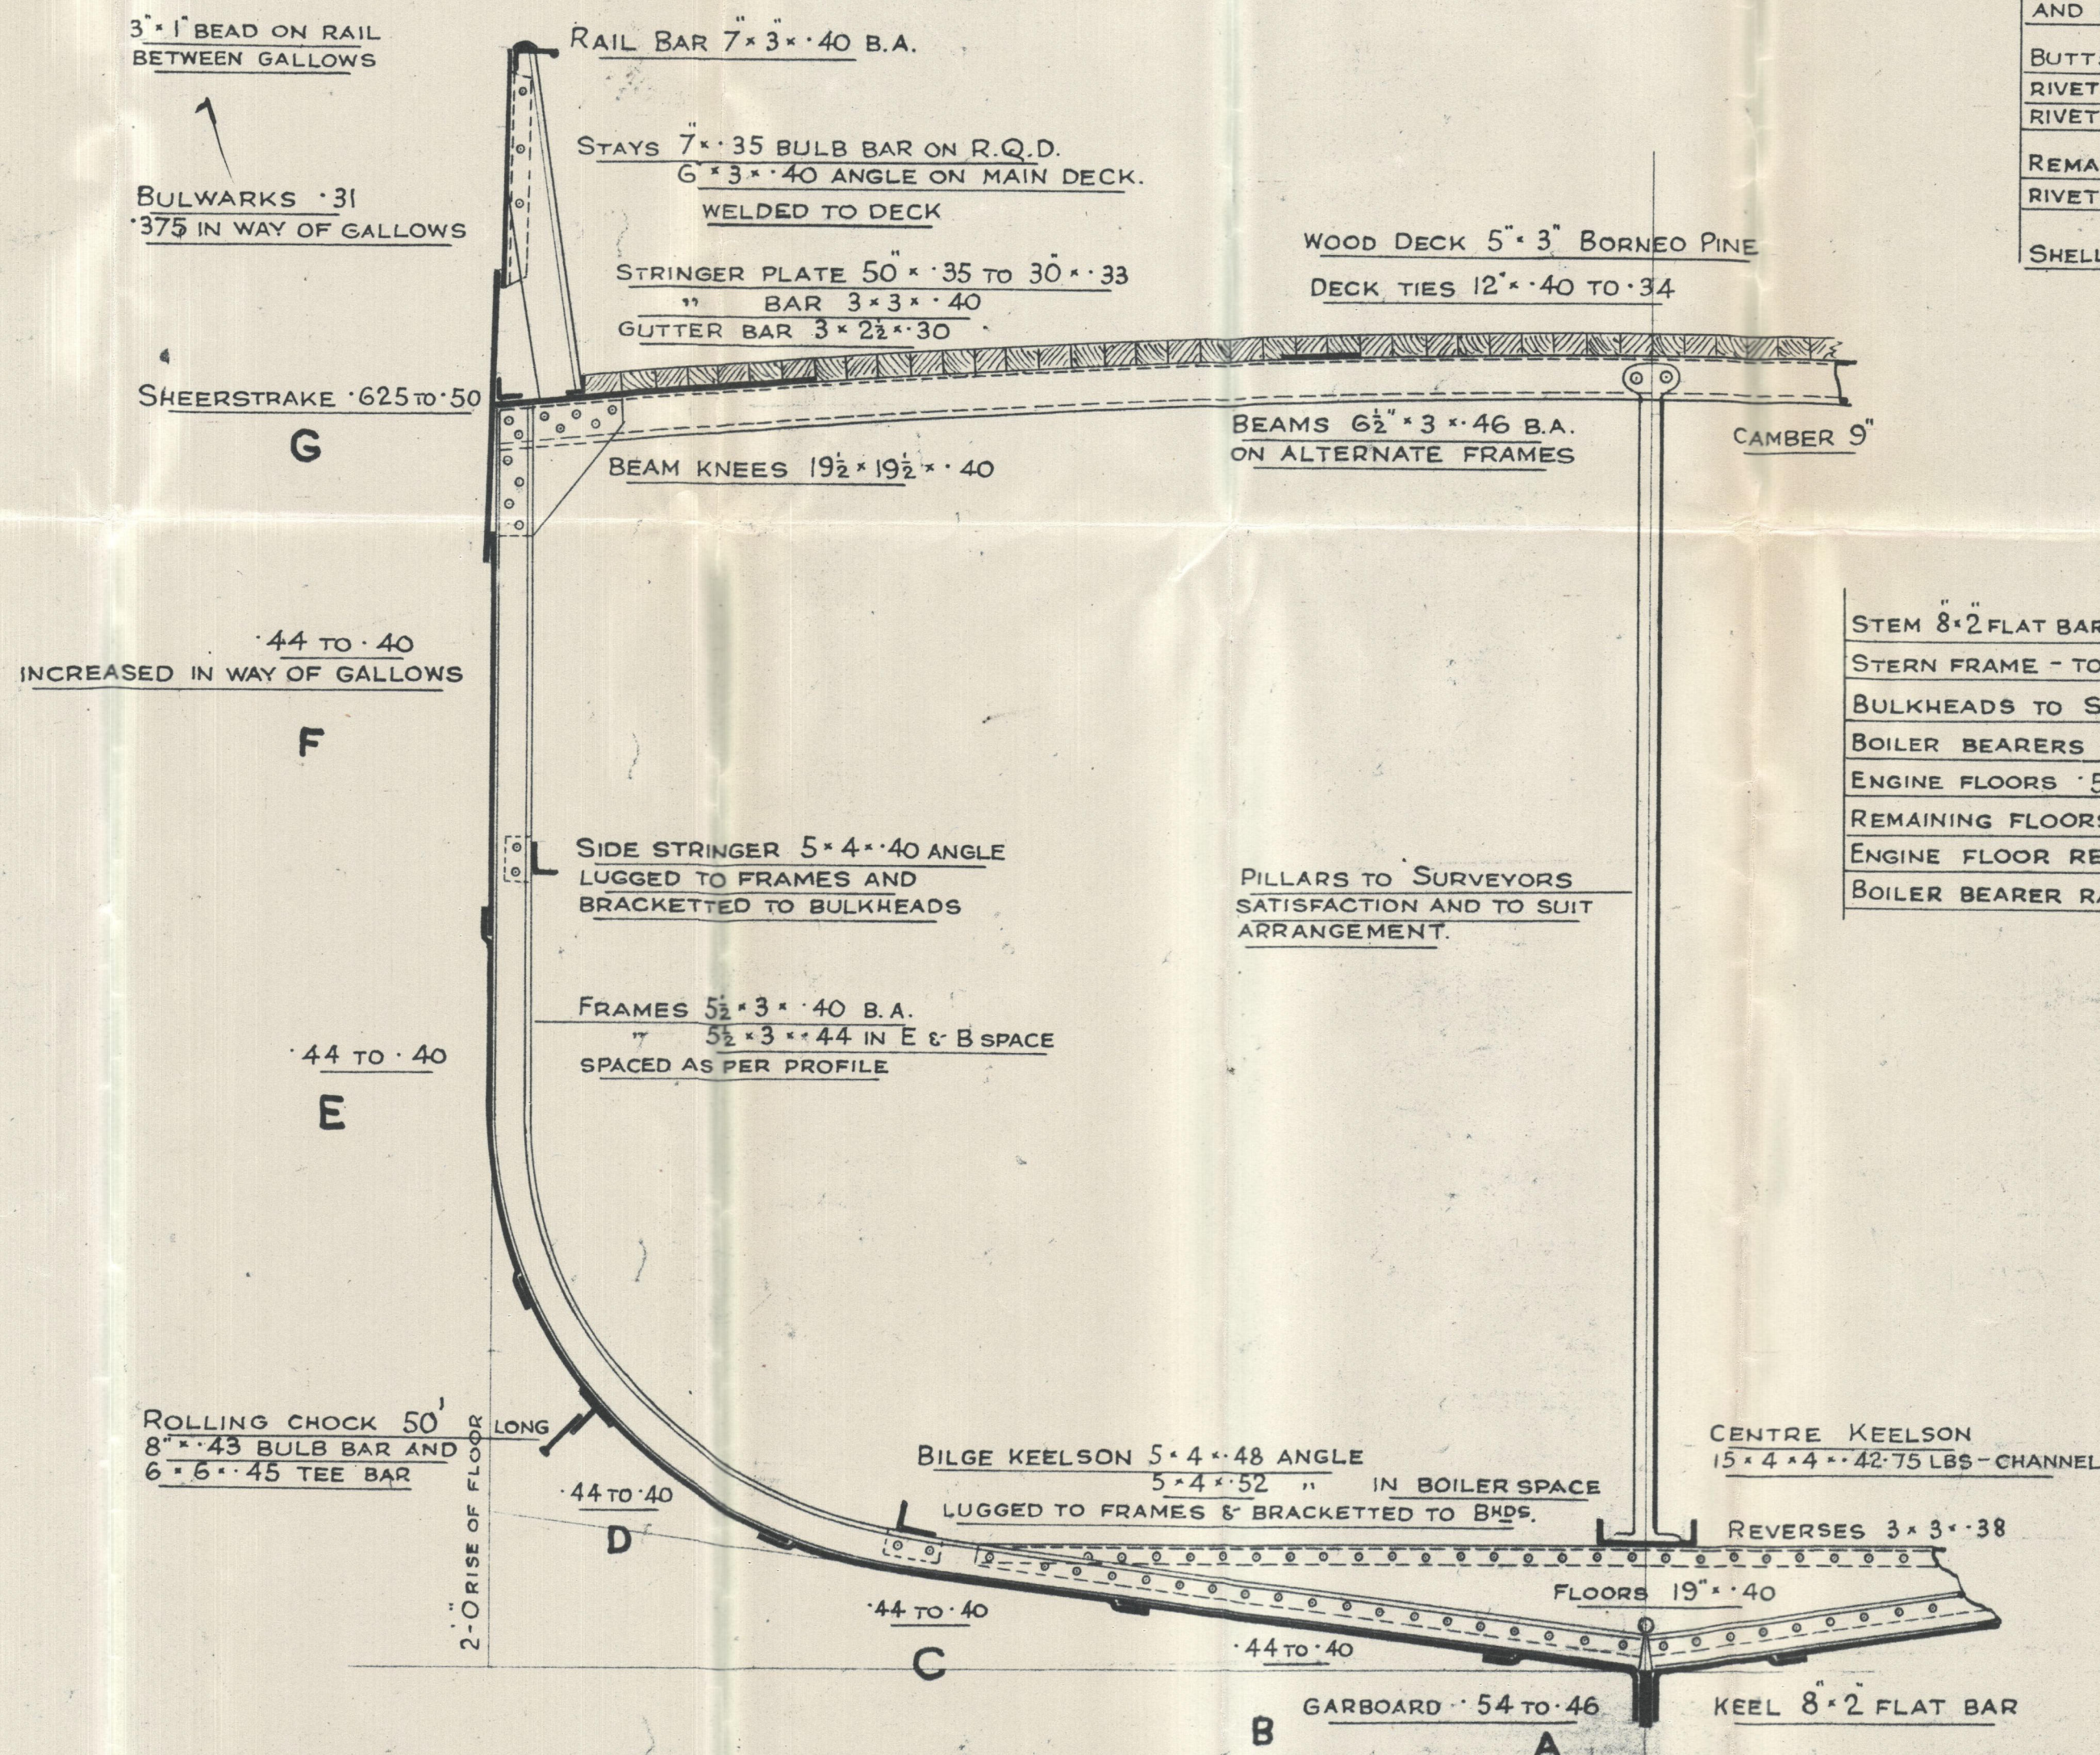

STEM 8" x 2" FLAT BAR AT BOTTOM - DISHED PLATE AT TOP
STERN FRAME - TO BE SUBMITTED
BULKHEADS TO SURVEYORS SATISFACTION
BOILER BEARERS 625
ENGINE FLOORS 50
REMAINING FLOORS IN E & B SPACE 45
ENGINE FLOOR REVERSES 3 1/2" x 3 1/2" x 43 DOUBLE
BOILER BEARER RADIUS BARS 5" x 5" x 50

PLAN No. 3566

FOR ENCLOSURE TO

Messrs Lloyd Register

FROM

COCHRANE & SONS, LTD.

SHIPBUILDERS, SELBY.


DATE 29.3.39

8.8.

Cape Passaro

HULL REPORT No.

58266

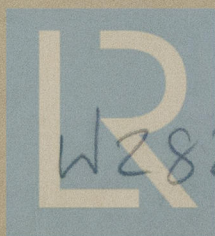

© 2020

W282 Lloyd's Register
Foundation