
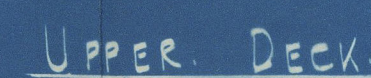
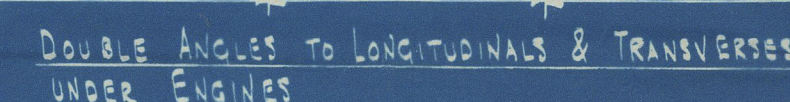


No 374

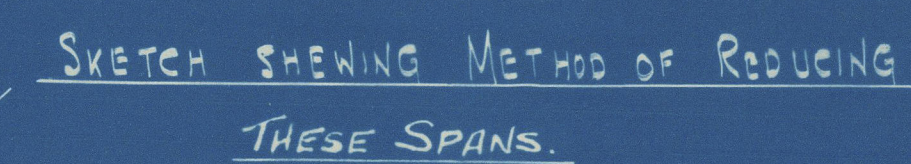





Mess^r Shopt Bros
Profile • Deck Plan

No. 374

S.S. "HESLEYSIDE"

Sho. Report No 25360

x inf. 374

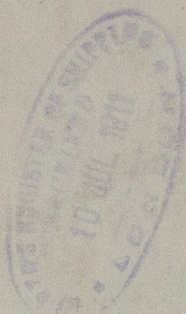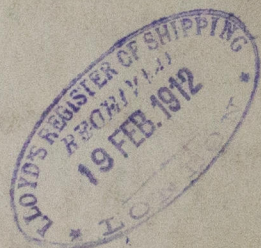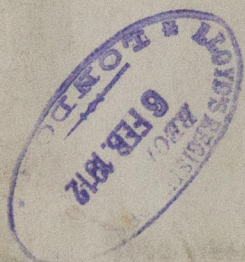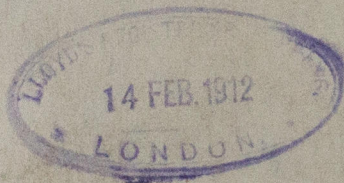

© 2020

Lloyd's Register
Foundation