

Lloyd's Register of Shipping.

(Report on Vessel No. _____)

Port *Newcastle on Tyne*

No. _____

SHIP FORGINGS ~~OR CASTINGS~~.

I have to report that the undermentioned Iron ~~or Steel~~ Forgings ~~or Castings~~, manufactured by *The Darlington Forge Ltd.* of *Darlington* for the Vessel No. *1264*, being built by *Swan Hunter & Co. Ltd.* of *Wallsend* have been inspected by me as set forth below and found to be, so far as can be seen, *Sound*.

Mark on Forgings ~~or Castings~~.

Lloyd's

No. *4740D**MR**M. Robertson**Built Darlington 20-2-25*

	STERN FRAME.	RUDDER FRAME.	STEM.
Material* ...	<i>Scrap Iron</i>	<i>Scrap Iron</i>	
How made ...	<i>Forged</i>	<i>Forged</i>	
Dimensions ...	<i>8 1/2 x 6 1/4 x 9 1/2 x 6 1/4</i>	<i>4 1/2 x 6 1/4 x 5 1/8</i>	
Progress on Inspection	<i>Forged Smithed</i>	<i>Forged Finished</i>	
Date when Inspected	<i>10-11-24. 6-2-25</i>	<i>6-2-25. 20-2-25</i>	

CASTINGS.

Tests on Standard Test Pieces.

Tensile Test—

Tons per square inch ...

Extension per cent. ...

Cold Bending Test—

Angle before fracture ...



Drop Test—

Height from ground ...

Hammering Test—

If made according to Rules and found satisfactory ...

SKETCHES OF FRAMES SHOWING POSITION AND DESCRIPTION OF WELDS OF FORGINGS.

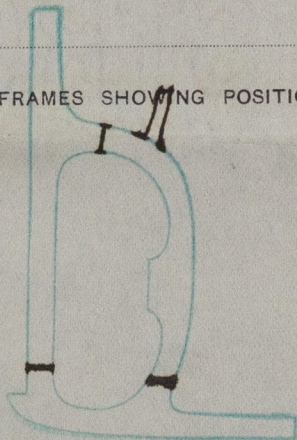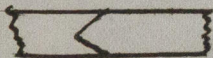

Fee (if any chargeable) £ : :

To be paid at _____

* If of Iron, state whether scrap or puddled Iron. If of Steel, state whether made on the Open Hearth process.