



7-6-15  
28-1-19  
7-3-19  
19-3-19  
3-6-15

Mass supported to Surveyor's satisfaction

Plan of hatchways to be submitted  
made spaced pillars & girders to be submitted



 

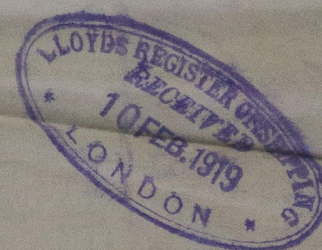

© 2019

Lloyd's Register  
Foundation





Profile & Deck Plans

Messrs A. Stephen & Sons Ltd


G.S.S. No. 474

T.S.S. *Natakara*

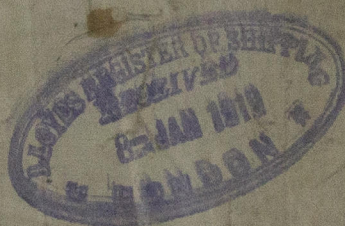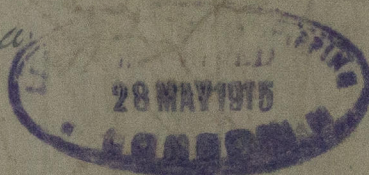

*W. H. Martin*

GLASGOW REPORT No. 406/13

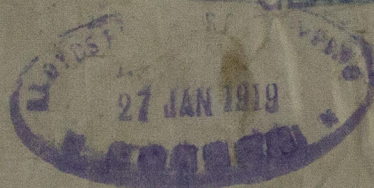

GLASGOW REPORT No. 41250

W284-0062



© 2019

Lloyd's Register  
Foundation