

18.3/14

# MIDSHIP SECTION

STEEL SCREW TRAWLERS

N<sup>o</sup>s 608-9


DIM<sup>s</sup> 125'-0" B.P. x 22'-6" Ex. x 13'-0" Mid

SCALE 1/2 INCH

TO CLASS 100 A.I. LLOYDS STEAM TRAWLER

DECK PLATED OVER IN WAY OF MACHINERY.  
E. & B. CASING AS PREVIOUSLY APPROVED.

PLAN No. 4075  
FOR ENCLOSURE TO  
MESSRS LLOYDS SURVEYORS  
HULL FROM  
COCHRANE & SONS, L.D.  
SHIPBUILDERS, GLENN  
DATE 16/3/14

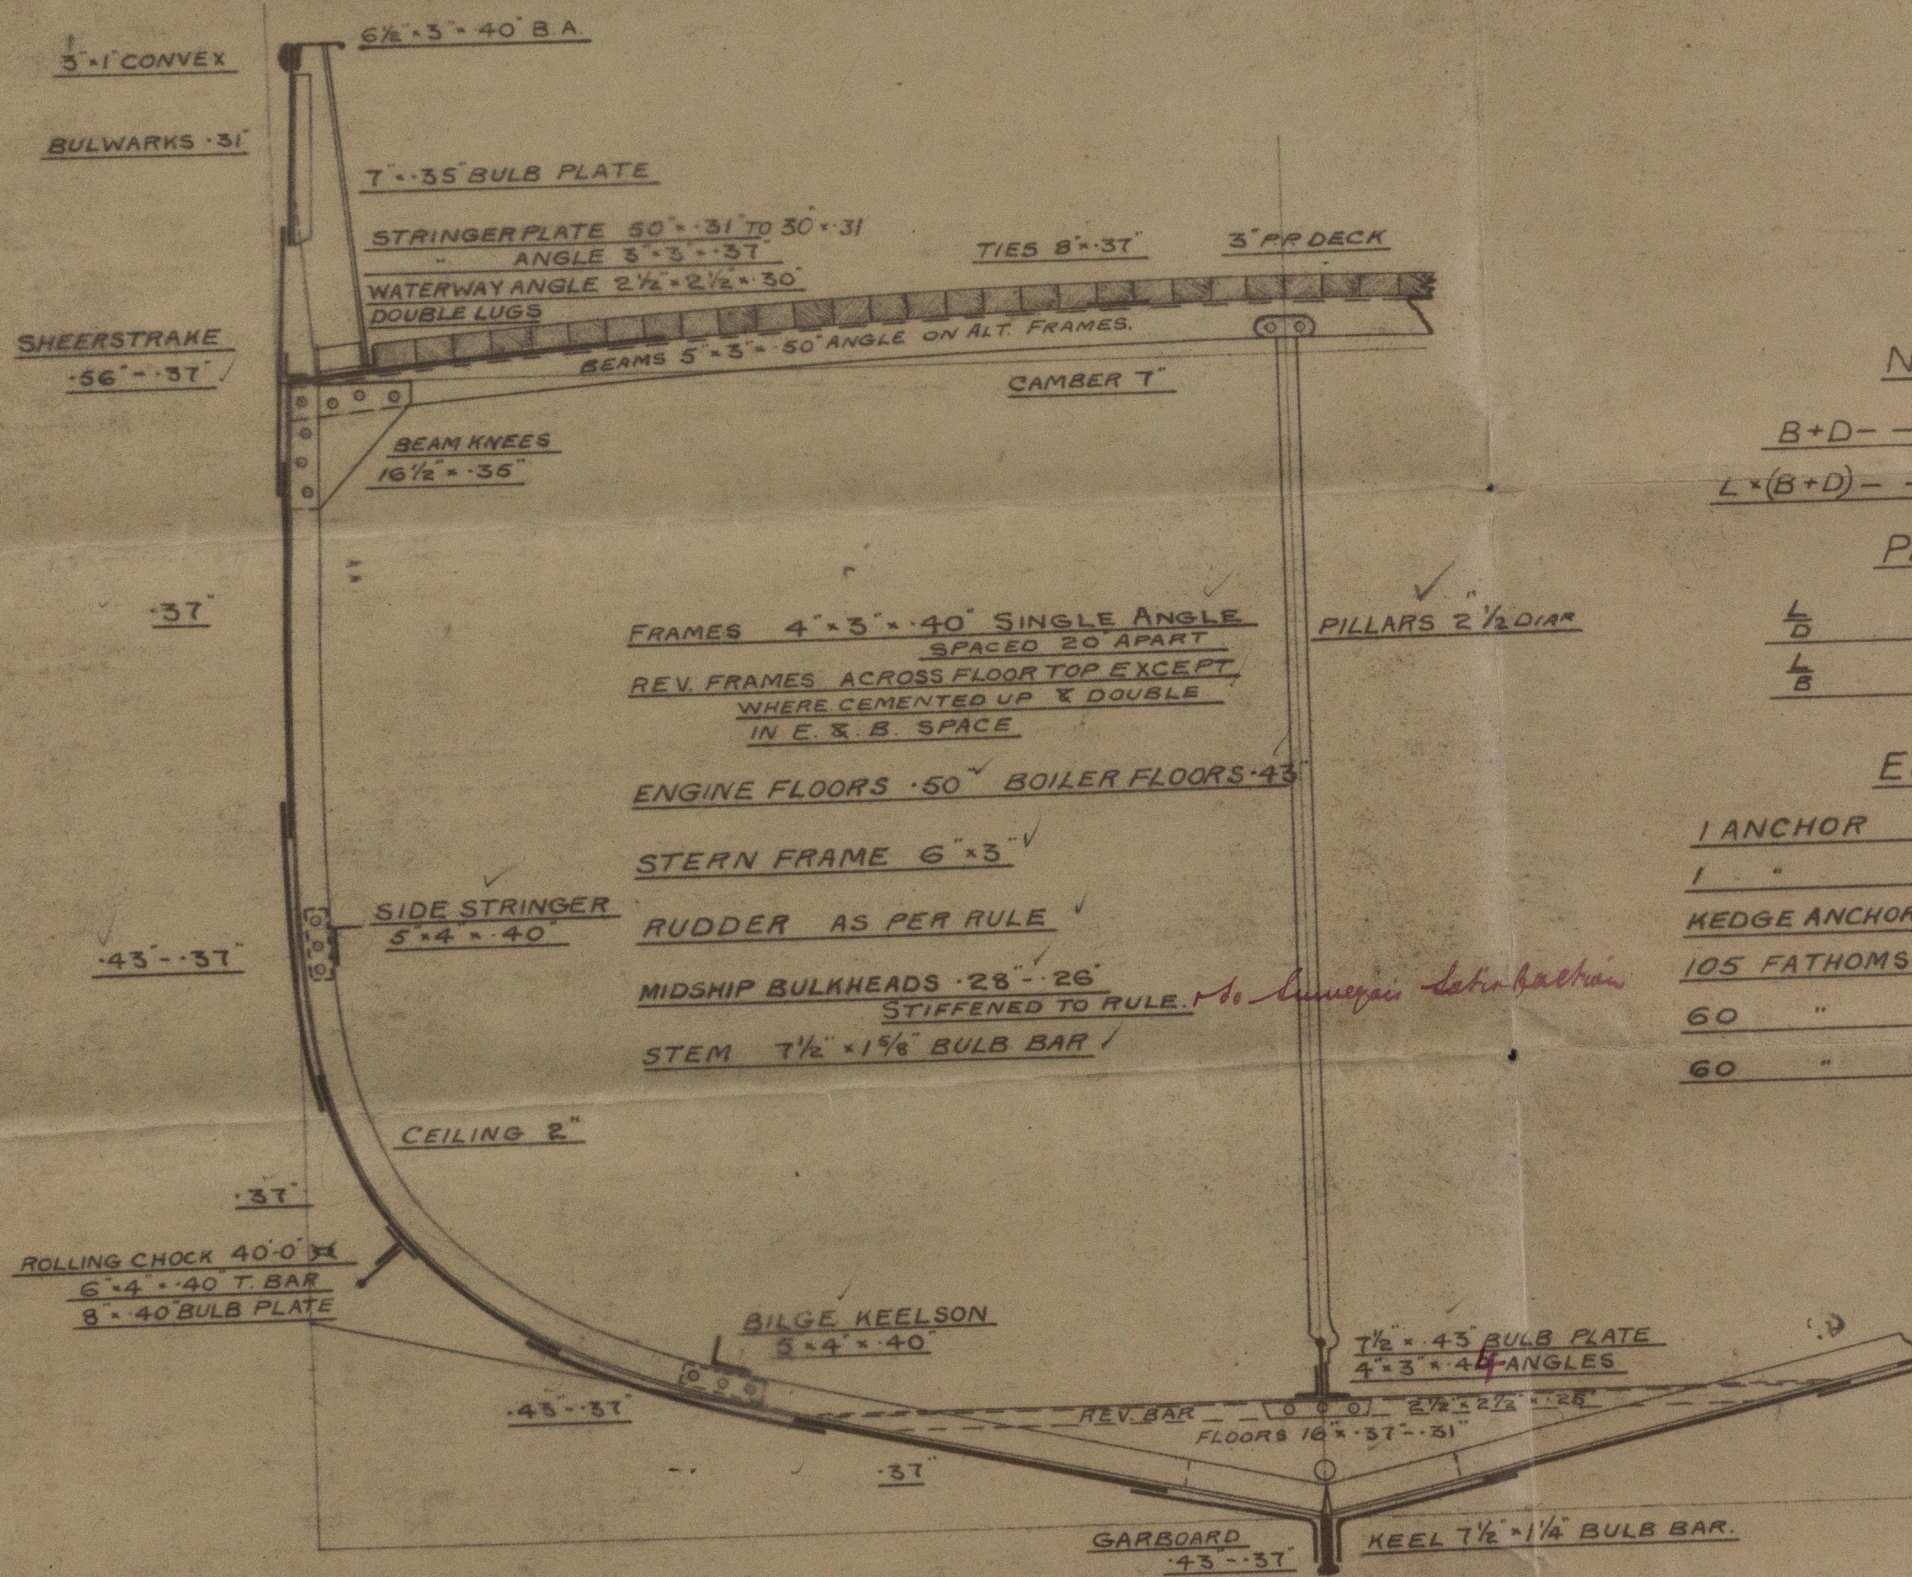

## NUMERALS

B+D --- 35.37

L\*(B+D) --- 4421.25

## PROPORTIONS

L/D --- 9.61

L/B --- 5.58

## EQUIPMENT

1 ANCHOR	5 1/2 CWTs Ex Stock or 7 CWTs Stockless
1 "	5 " " " " 6 1/4 " "
KEDGE ANCHOR	2 3/4 " " " "
105 FATHOMS	1 1/16" STUD LINK CABLE
60 "	6" HAWSER
60 "	4 1/2" WARP

## RIVETING

BUTTS OF SHELL PLATING TO BE OVERLAPPED & DOUBLE RIVETED EXCEPT GARBOARD & SHEERSTRAKE WHICH ARE TO BE STRAPPED LANDINGS DOUBLE RIVETED. BULWARKS SINGLE RIVETED DECK STRINGERS & TIES OVERLAPPED & DOUBLE RIVETED

*COF*  
18.3.14.

*RW*  
17/3/14






Midship Section  
No 608-9

Cochran Jones

$\frac{3}{4}$  Sea Searcher Hull Rpt No. 280  
" Sea Ranger - - - 280

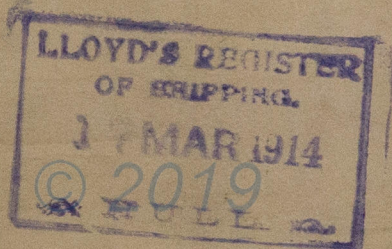

Lloyd's Register  
W288-0039