

22/4/16



No 507.

PROFILE AND DECK PLANS.

DIMENSIONS:- LENGTH B.P. 420'-0", BREADTH MLD 54'-3", DEPTH MLD 32'-8 1/2".

SCALE 1/4" = 1 FOOT.

LONGITUDINAL SYSTEM.

 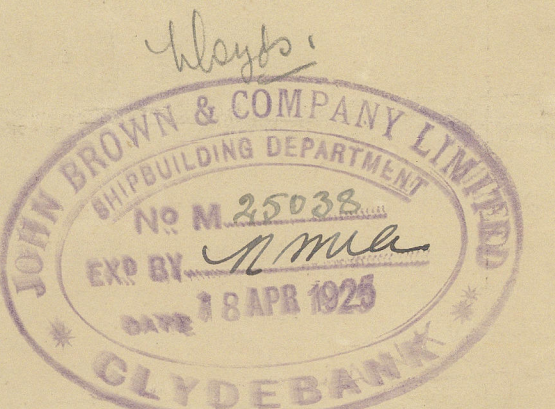

11/1/15

PILLARS IN CARGO TWEEN DECK

FR 70	83' 40" TIME 10.15
FR 74	6' 40" OR 3 1/2"
FR 77	55' 36" OR 3 1/2"

PILLARS IN CARGO HOLD

FR 70	54' 40" OR 5 1/2"
FR 74	58' 40" OR 5 1/2"
FR 77	58' 40" OR 5 1/2"

Profile & deck plan


John Brown & Co

T. S. M. V. "British Diplomat"

507. British
Diplomat

u.u. "Empire Diplomat"

GLASGOW REPORT No. 45790



© 2020

Lloyd's Register
Foundation

W289-0074