


22/4/18
20/9/19 (238)
20-3-20 (259040)

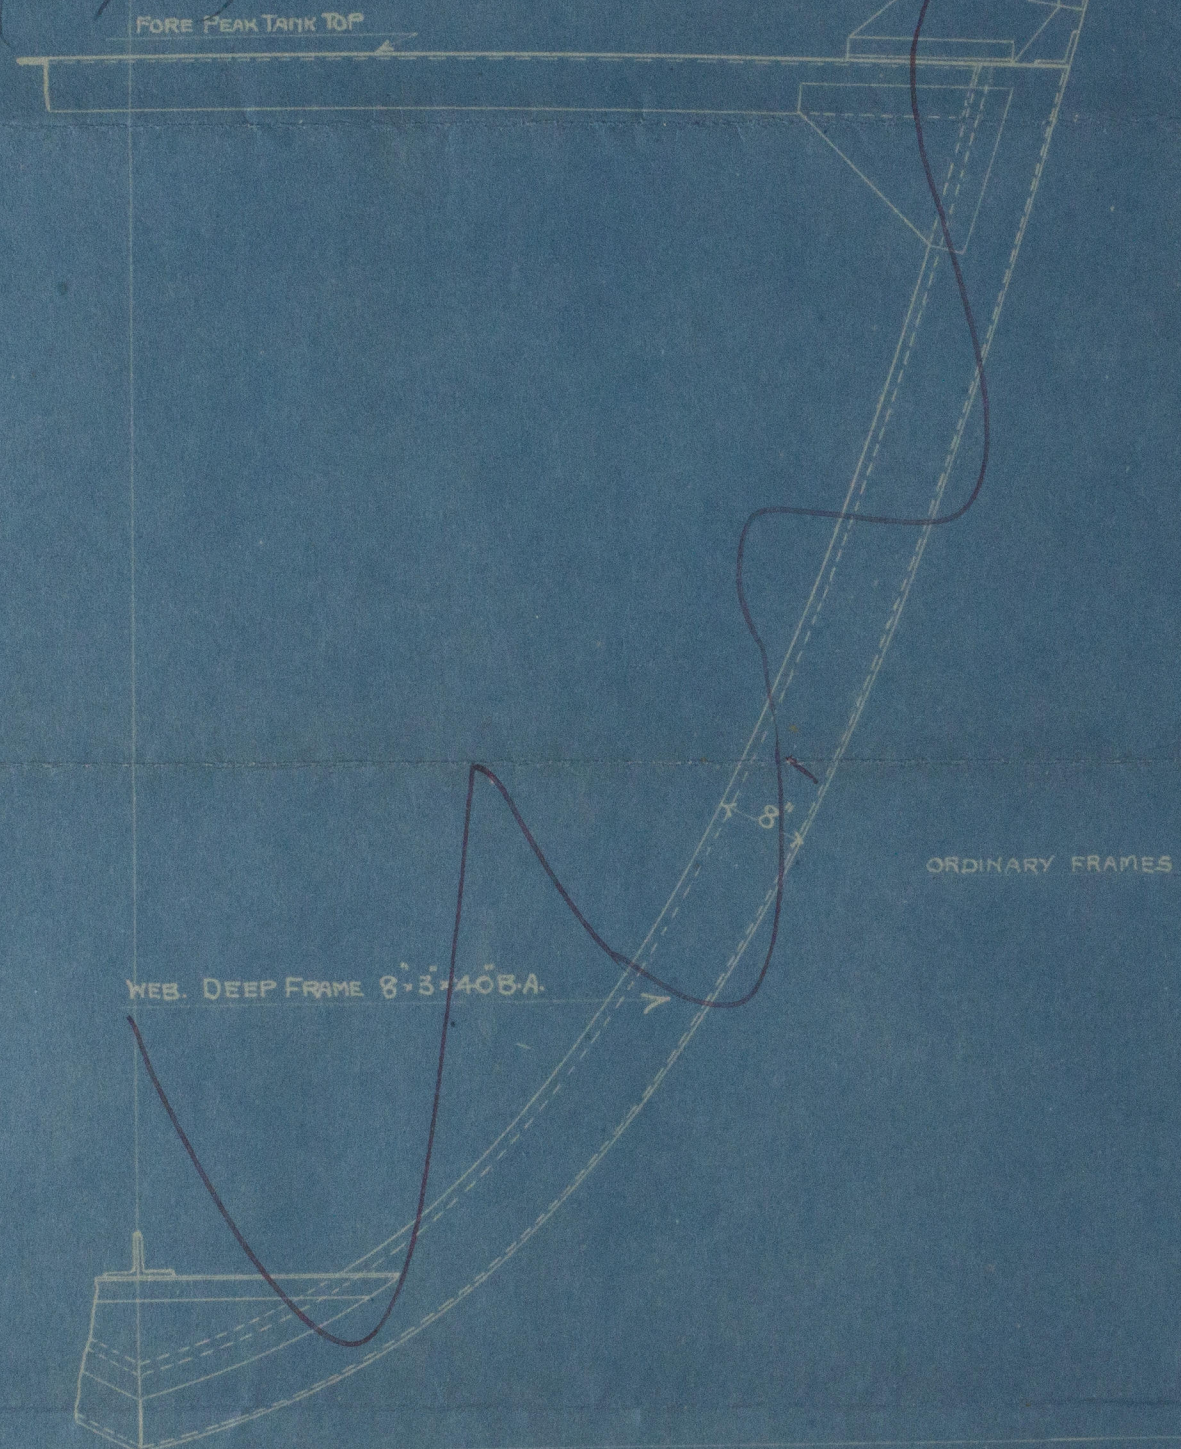


ALTERNATIVE METHOD.

BULB ANGLE STIFFENING.

S.S.N° 230. 238

PROPOSED STIFFENING ON FRAMES 94-97 IN LIEU OF KEELSON IN FORE PEAK.

SCALE $\frac{3}{4}$ " = 1 FOOT.

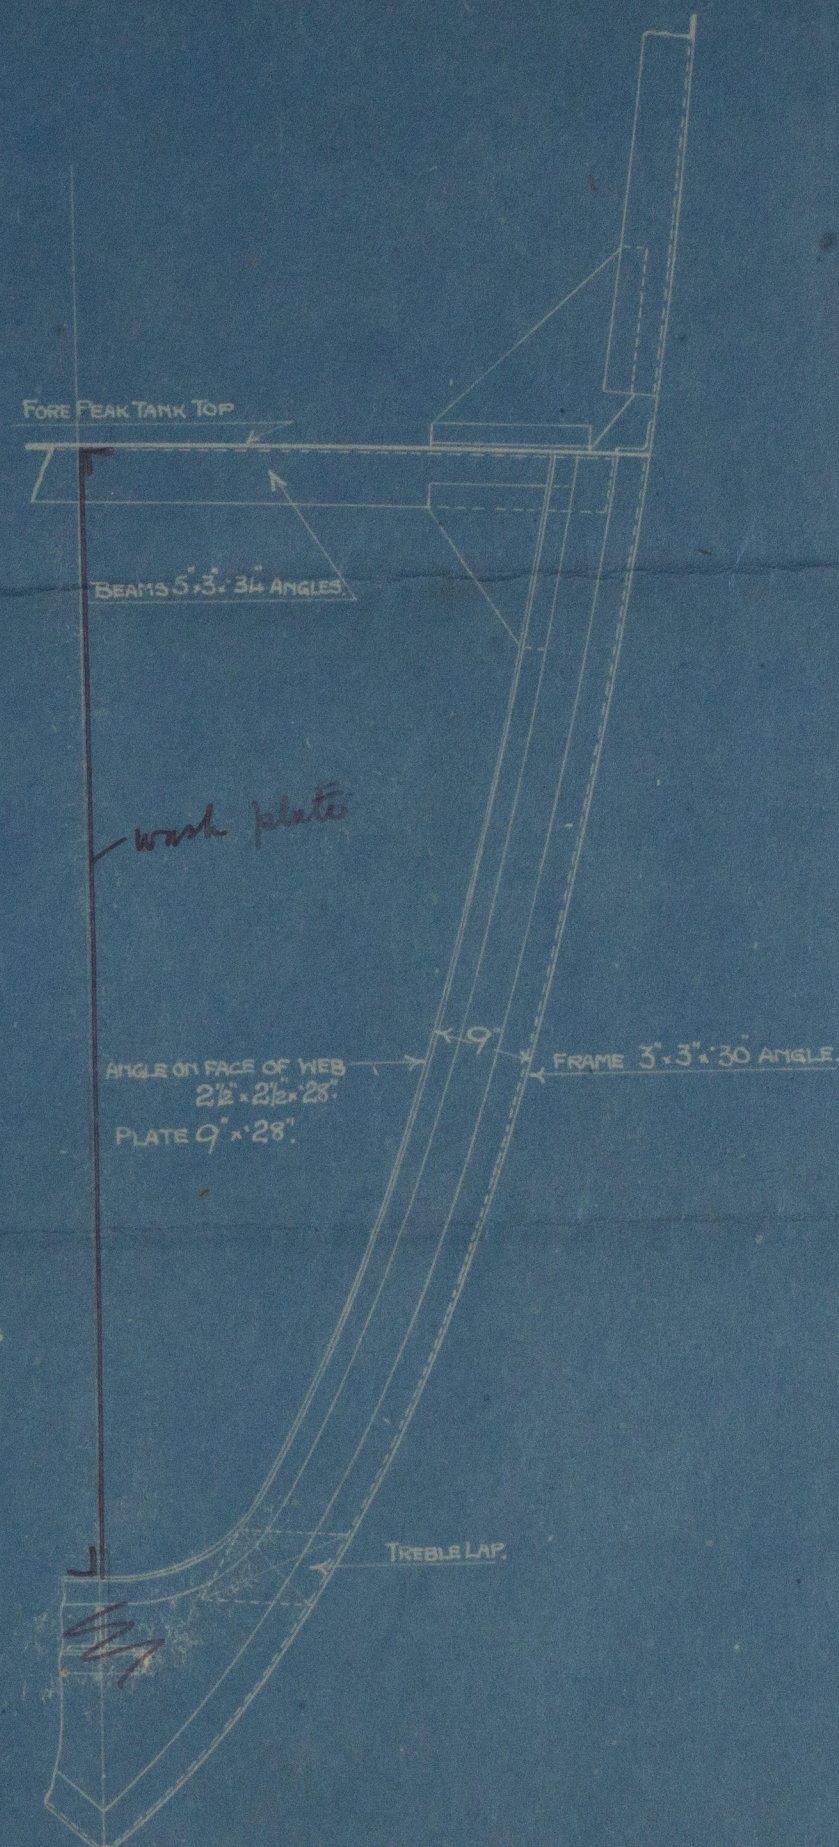

PROPOSED METHOD.

PLATE + ANGLE STIFFENING.

R. WILLIAMSON & SON,
SHIPBUILDERS

WORKINGTON.

TRACING N° 3292.



© 2019

Lloyd's Register
29-0050

S. S. No 230. 238. 237.

WEBS IN FORE PEAK.

WORKINGTON
WILLIAMSON & SON

LLOYD'S REGISTER,
LONDON.

RECD 20 SEP 1919

ANSD




No 230 - S. S. "Dynamo" 1st Entry Rpt
no 183/7

Pl. 40524

S. Ardshean.

W29-0050

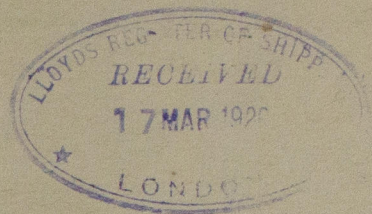

© 2019

Lloyd's Register
Foundation