

S. S. Nos 230 + 237. 238

ALL SIZE DRAWING OF RUDDER PINS.

LLOYD'S REGISTER,
LONDON.


RECD 20 SEP 1919

ANSD

R. WILLIAMSON & SON,

WORKINGTON

Gls Rpt. 39937.

S/S Dynamo 

Gls. Rpt. 40524

S/S Ardshean.

W29-0054




© 2019

Lloyd's Register
Foundation




21/6/18
20/9/19 (N238)
22.2.20 (239+40)

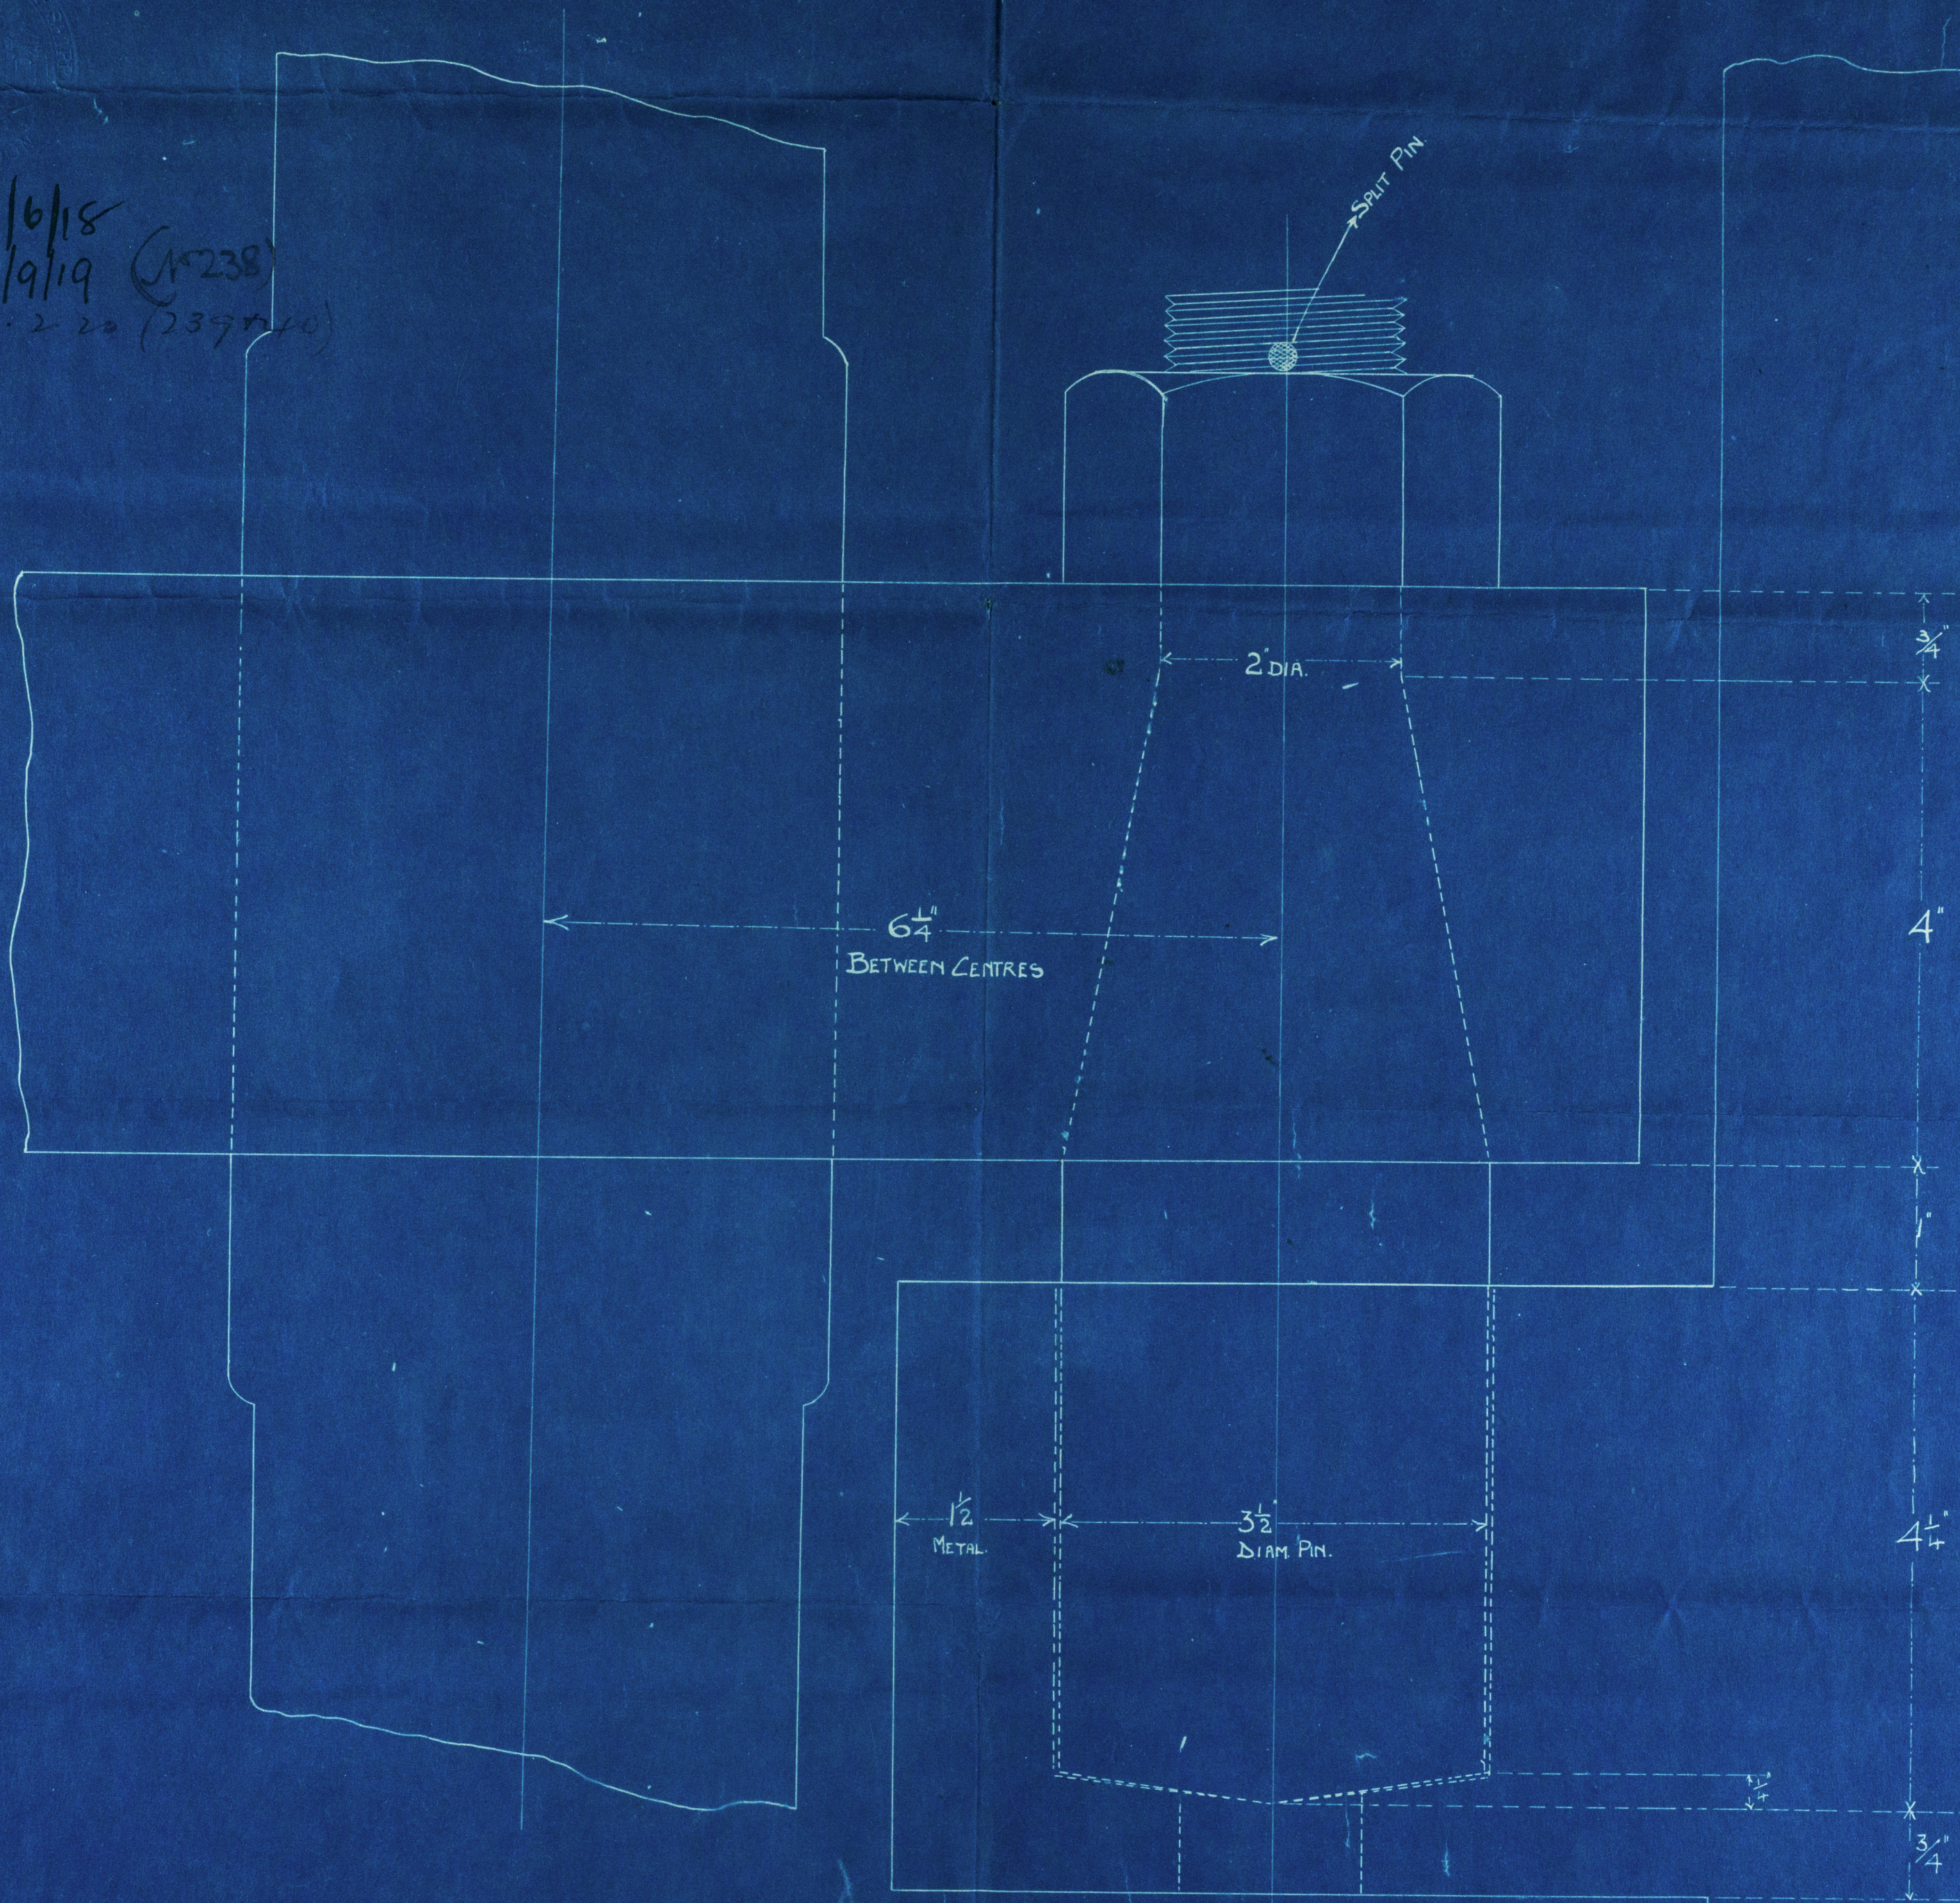

FULL SIZE DRAWING OF RUDDER PINS. N^o 230, +237. +238

Jul
21.6.18

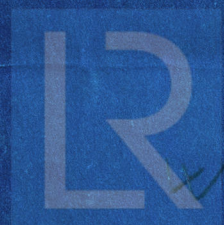

X/50-0054