


5500-67 M

22/4/18

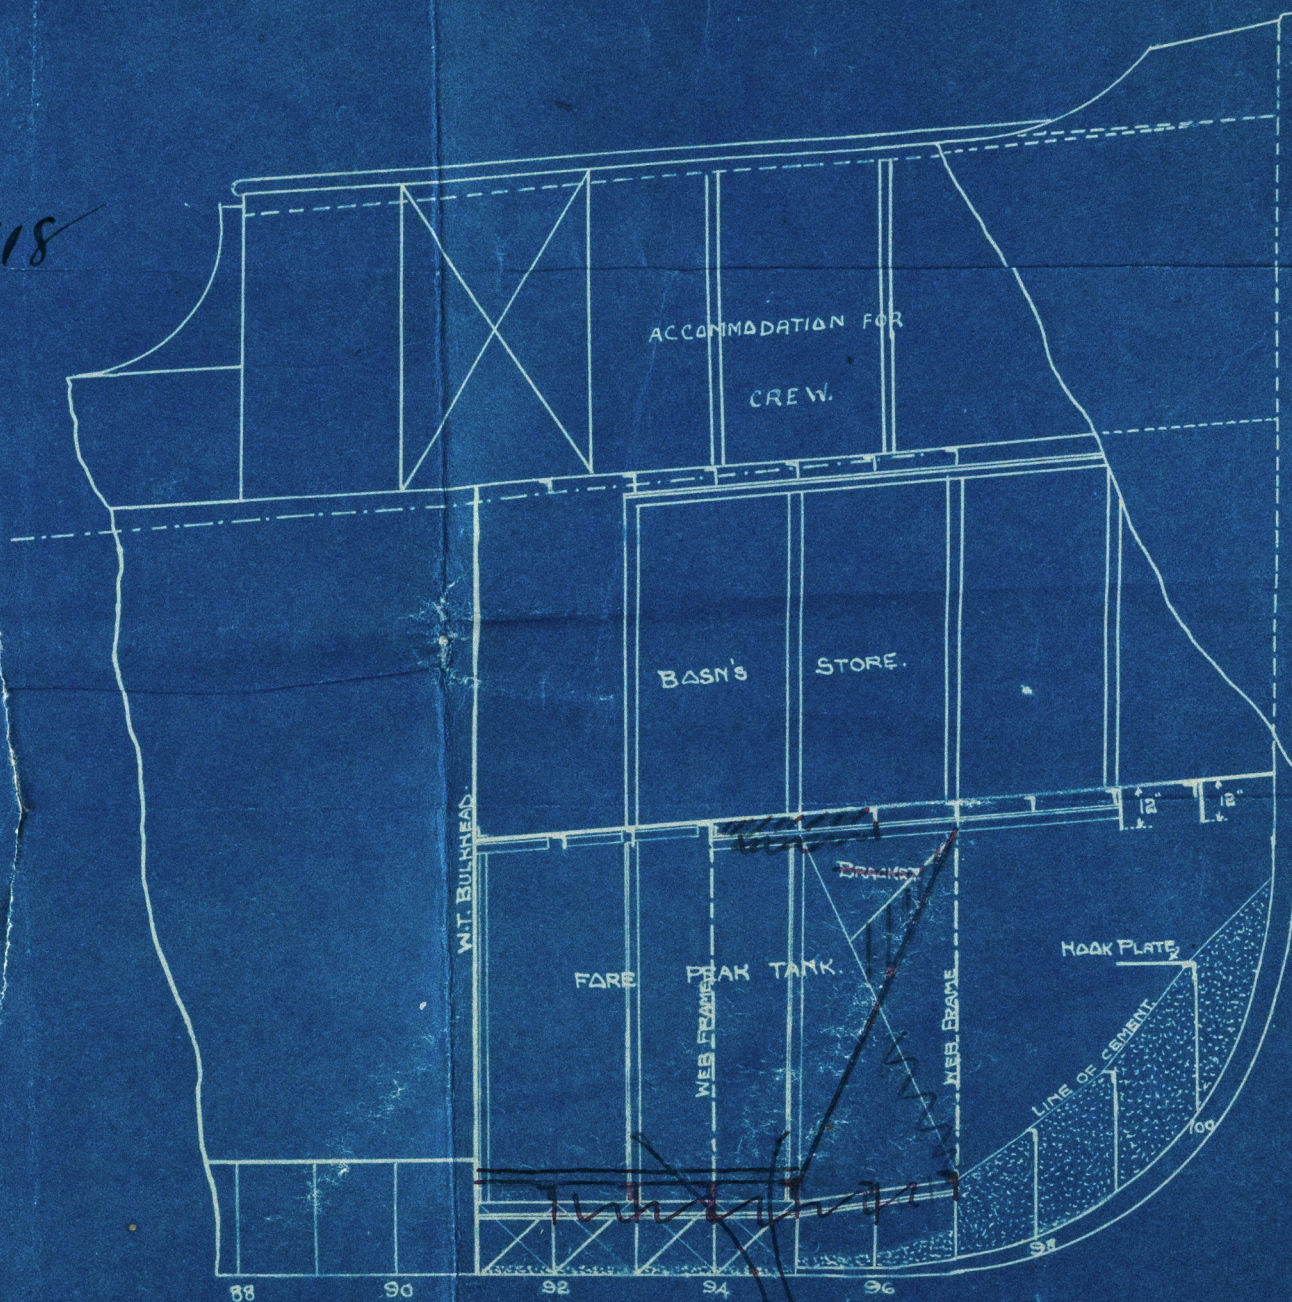

stiffeners to left in fore.

FORE END S.S. N° 230.



R. WILLIAMSON & SON,
SHIPBUILDERS,
WORKINGTON.

For Ind. S. S. N: 230



© 2019

Lloyd's Register
Foundation

W29-0055