


15/1/19

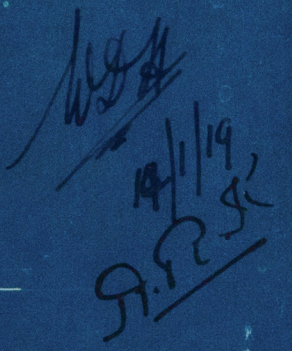

N<sup>o</sup>s 2211/12 STEEL VERTICAL BOILER.

- 10'-0" HIGH x 4'-9" DIAM<sup>ER</sup> x 90 LBS. WORKING PRESSURE

SCALE 1 INCH = 1 FOOT

TO PASS LLOYDS.

ENG No 938-9

From M'KIE & BAXTER,  
FOR ENCLOSURE TO

FOR ENCLOSURE TO  
Clyde Regt Shipping  
Admiral

ТОВ № 2211/12.

DRAWING N<sup>o</sup>. 141




A. Anderson & Sons.  
Glasgow Boiler Works.  
Steel Vertical Boilers.  
Nos. 2211/12.  
for.


Mr. Kie & Baxters  
Inquiries No. 938/9.

W.P. 90 lbs/sq"

Donkey Boilers  
No. 938-9

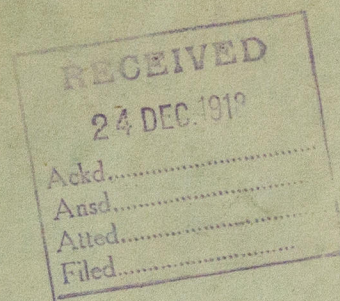

GLASGOW REPORT No 39561.

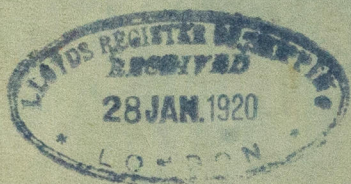

W29-0060



© 2019

Lloyd's Register  
Foundation

W.P. 90 lbs/sq"