

27.9.12
waiter 6 ginkabill

27.9.12

PLAN No. 2394
FOR ENCLOSURE TO
Messrs Lloyd's Surveyors
Hull FROM
COCHRANE & SONS, LTD.
SHIPBUILDERS, SELBY.
DATE Jan 3rd 1913. RK

MIDSHIP SECTION

NOS 552, 3, 4, & 5.


STEEL SCREW TRAWLERS
DIM^s 133'-4" BP x 23'-0" E x 13'-0" M^{LO}

SCALE 1/2" = 1 FOOT.

TO CLASS 100 A1 LLOYD'S. STEAM TRAWLER.

201
Messrs Lloyd's Surveyors
Hull

25/9/12 RK

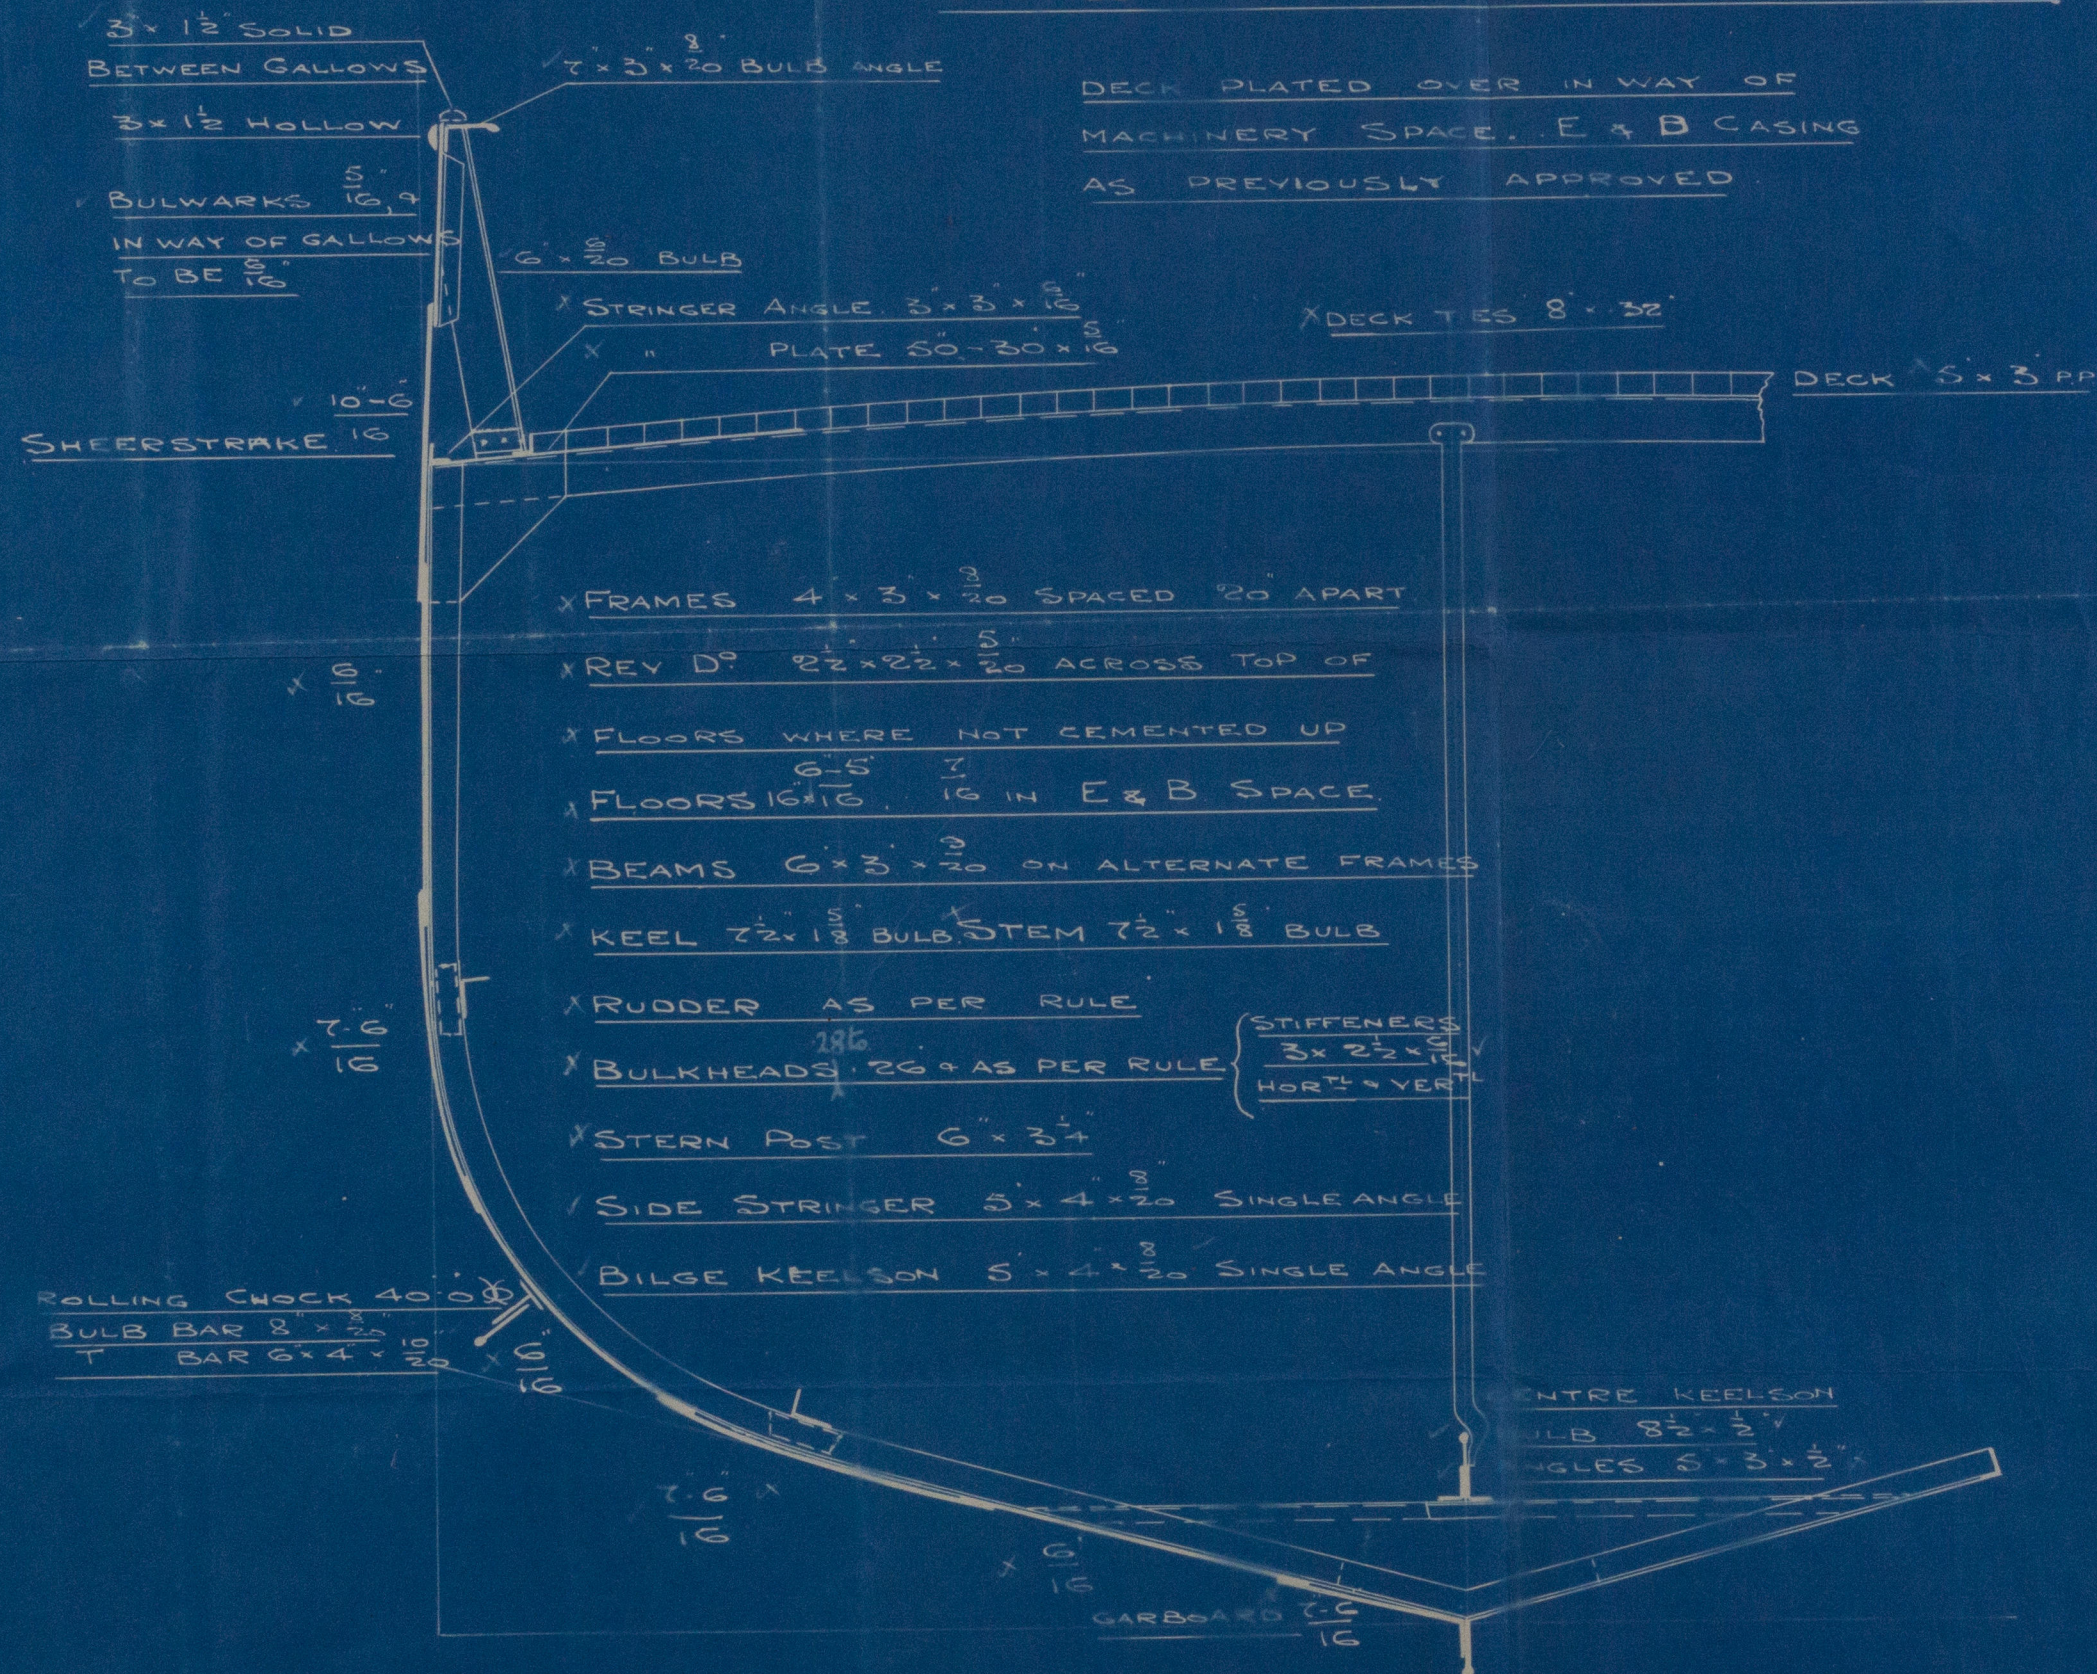

NUMERALS

B + D = 35.87
L x (B + D) = 4782.54

PROPORTIONS

D/L 10.25
L/B 5.82

EQUIPMENT

1ST BOWER ANCHOR 6 CWT^s EX STOCK
2ND " " 5 1/2 " " "
KEDGE " 3 " " "
120 FATHOMS 1 1/2" CABLE
60 " 6" HAWSER
60 " 5" WARP

RIVETING

ALL LANDINGS TO BE DOUBLE RIVETED. BUTTS TO BE LAPPED & DOUBLE RIVETED EXCEPT GARBOARD & SHEER STRAKE WHICH ARE TO BE STRAPPED & DOUBLE RIVETED.

C.B.
27.9.12



190-0150

^{M.S.}
Cochrane & Sons.

N^o 552.553.554.555

Copy of approved
Midship Section

1/2 Diamond Hull Rpt No: 25908

"Sapphire" " " " 25969

"Cadella" ex. "Pearl" " " " 26060

"Emerald" " " "



© 2019

Lloyd's Register

W290-0150
Foundation