


Scheepsketel 26° 50.
Schaal 1 a 10

Minimum Tensile Strength
of girders to be not less
than 44 Kg.

Gebonden door toezicht Bureau Veritas

Verwamd: Opp 120 Nl²
Stoomdruk 14 Kg / c Nl²

4. 5. 21.

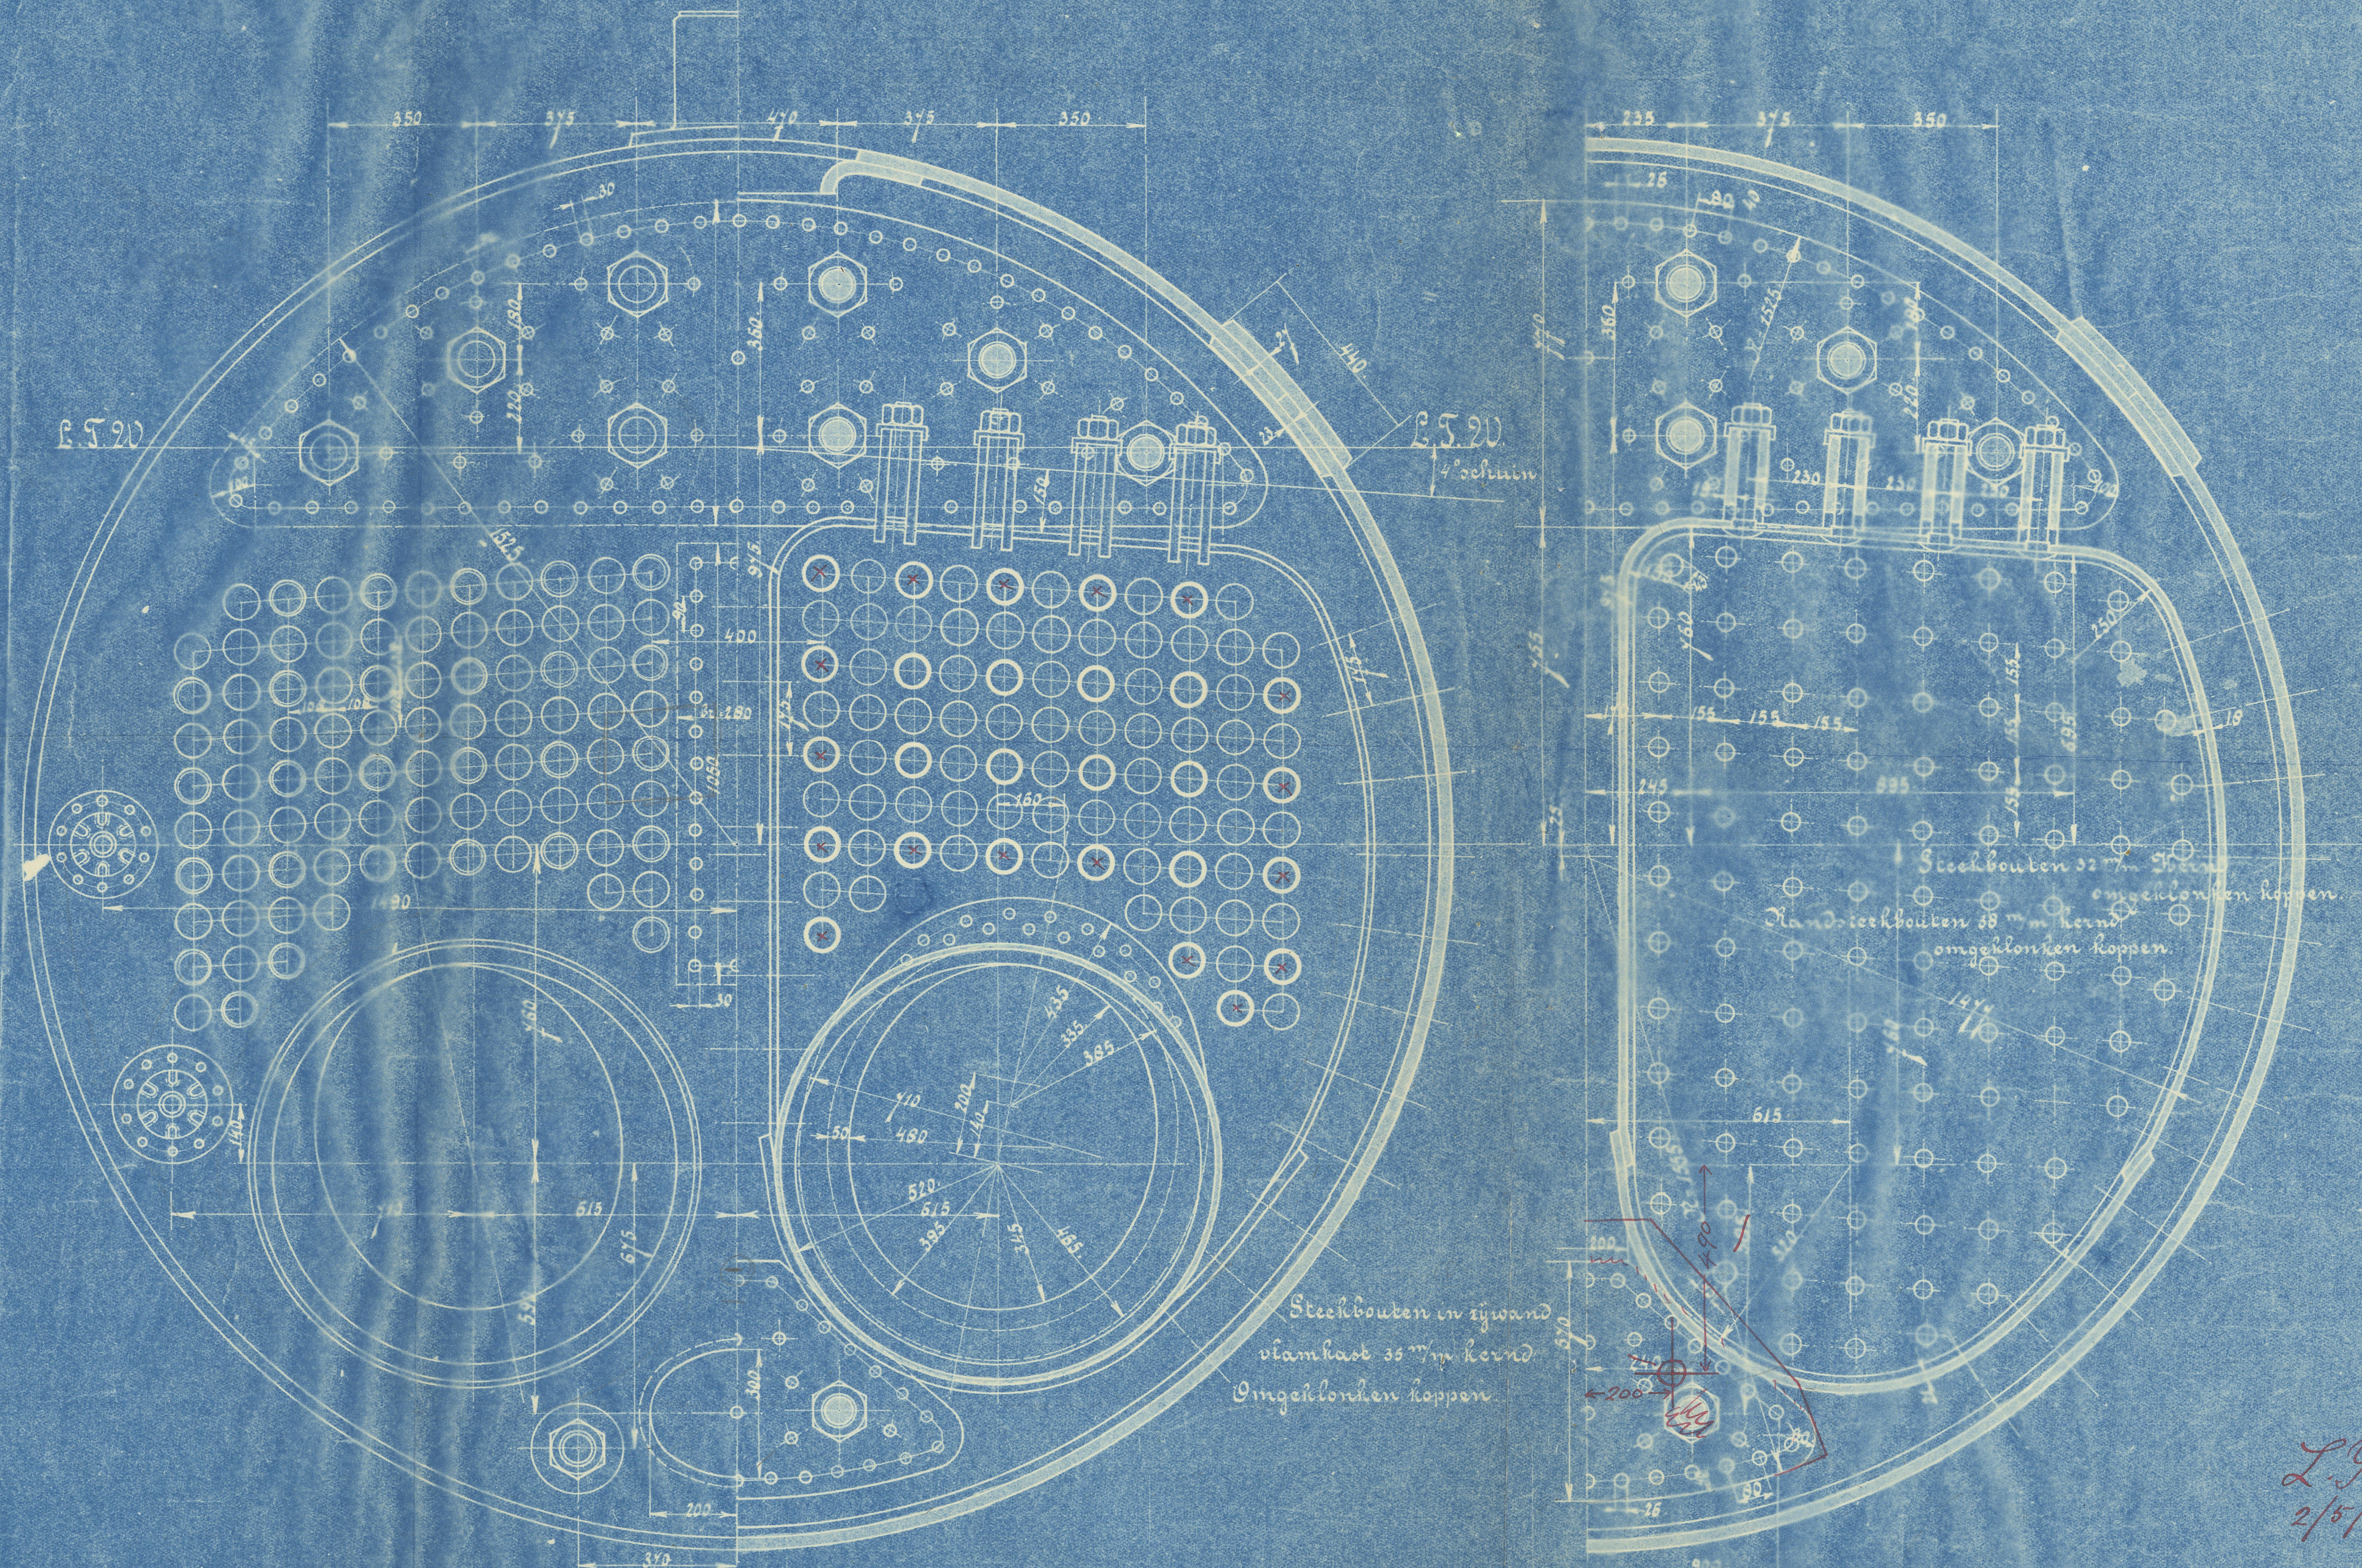

L.Y.
2/5/21.
A. F. R.

L. Straatman

Machinofabrik-Hetelmakery

Dordrecht-Holland

W290-0214 Lloyd's Register Foundation

Plom

W^o & Straatmans Boiler N^o 50

London

Copy

Gen. Box

3620

S.S. Leine

Rot. Rept. 15070

W290-0214



© 2019

Lloyd's Register
Foundation