


K E T E L S N° 33 & 34



SCHAE 1" 12. 11.12.07.

LLOYD'S TEST

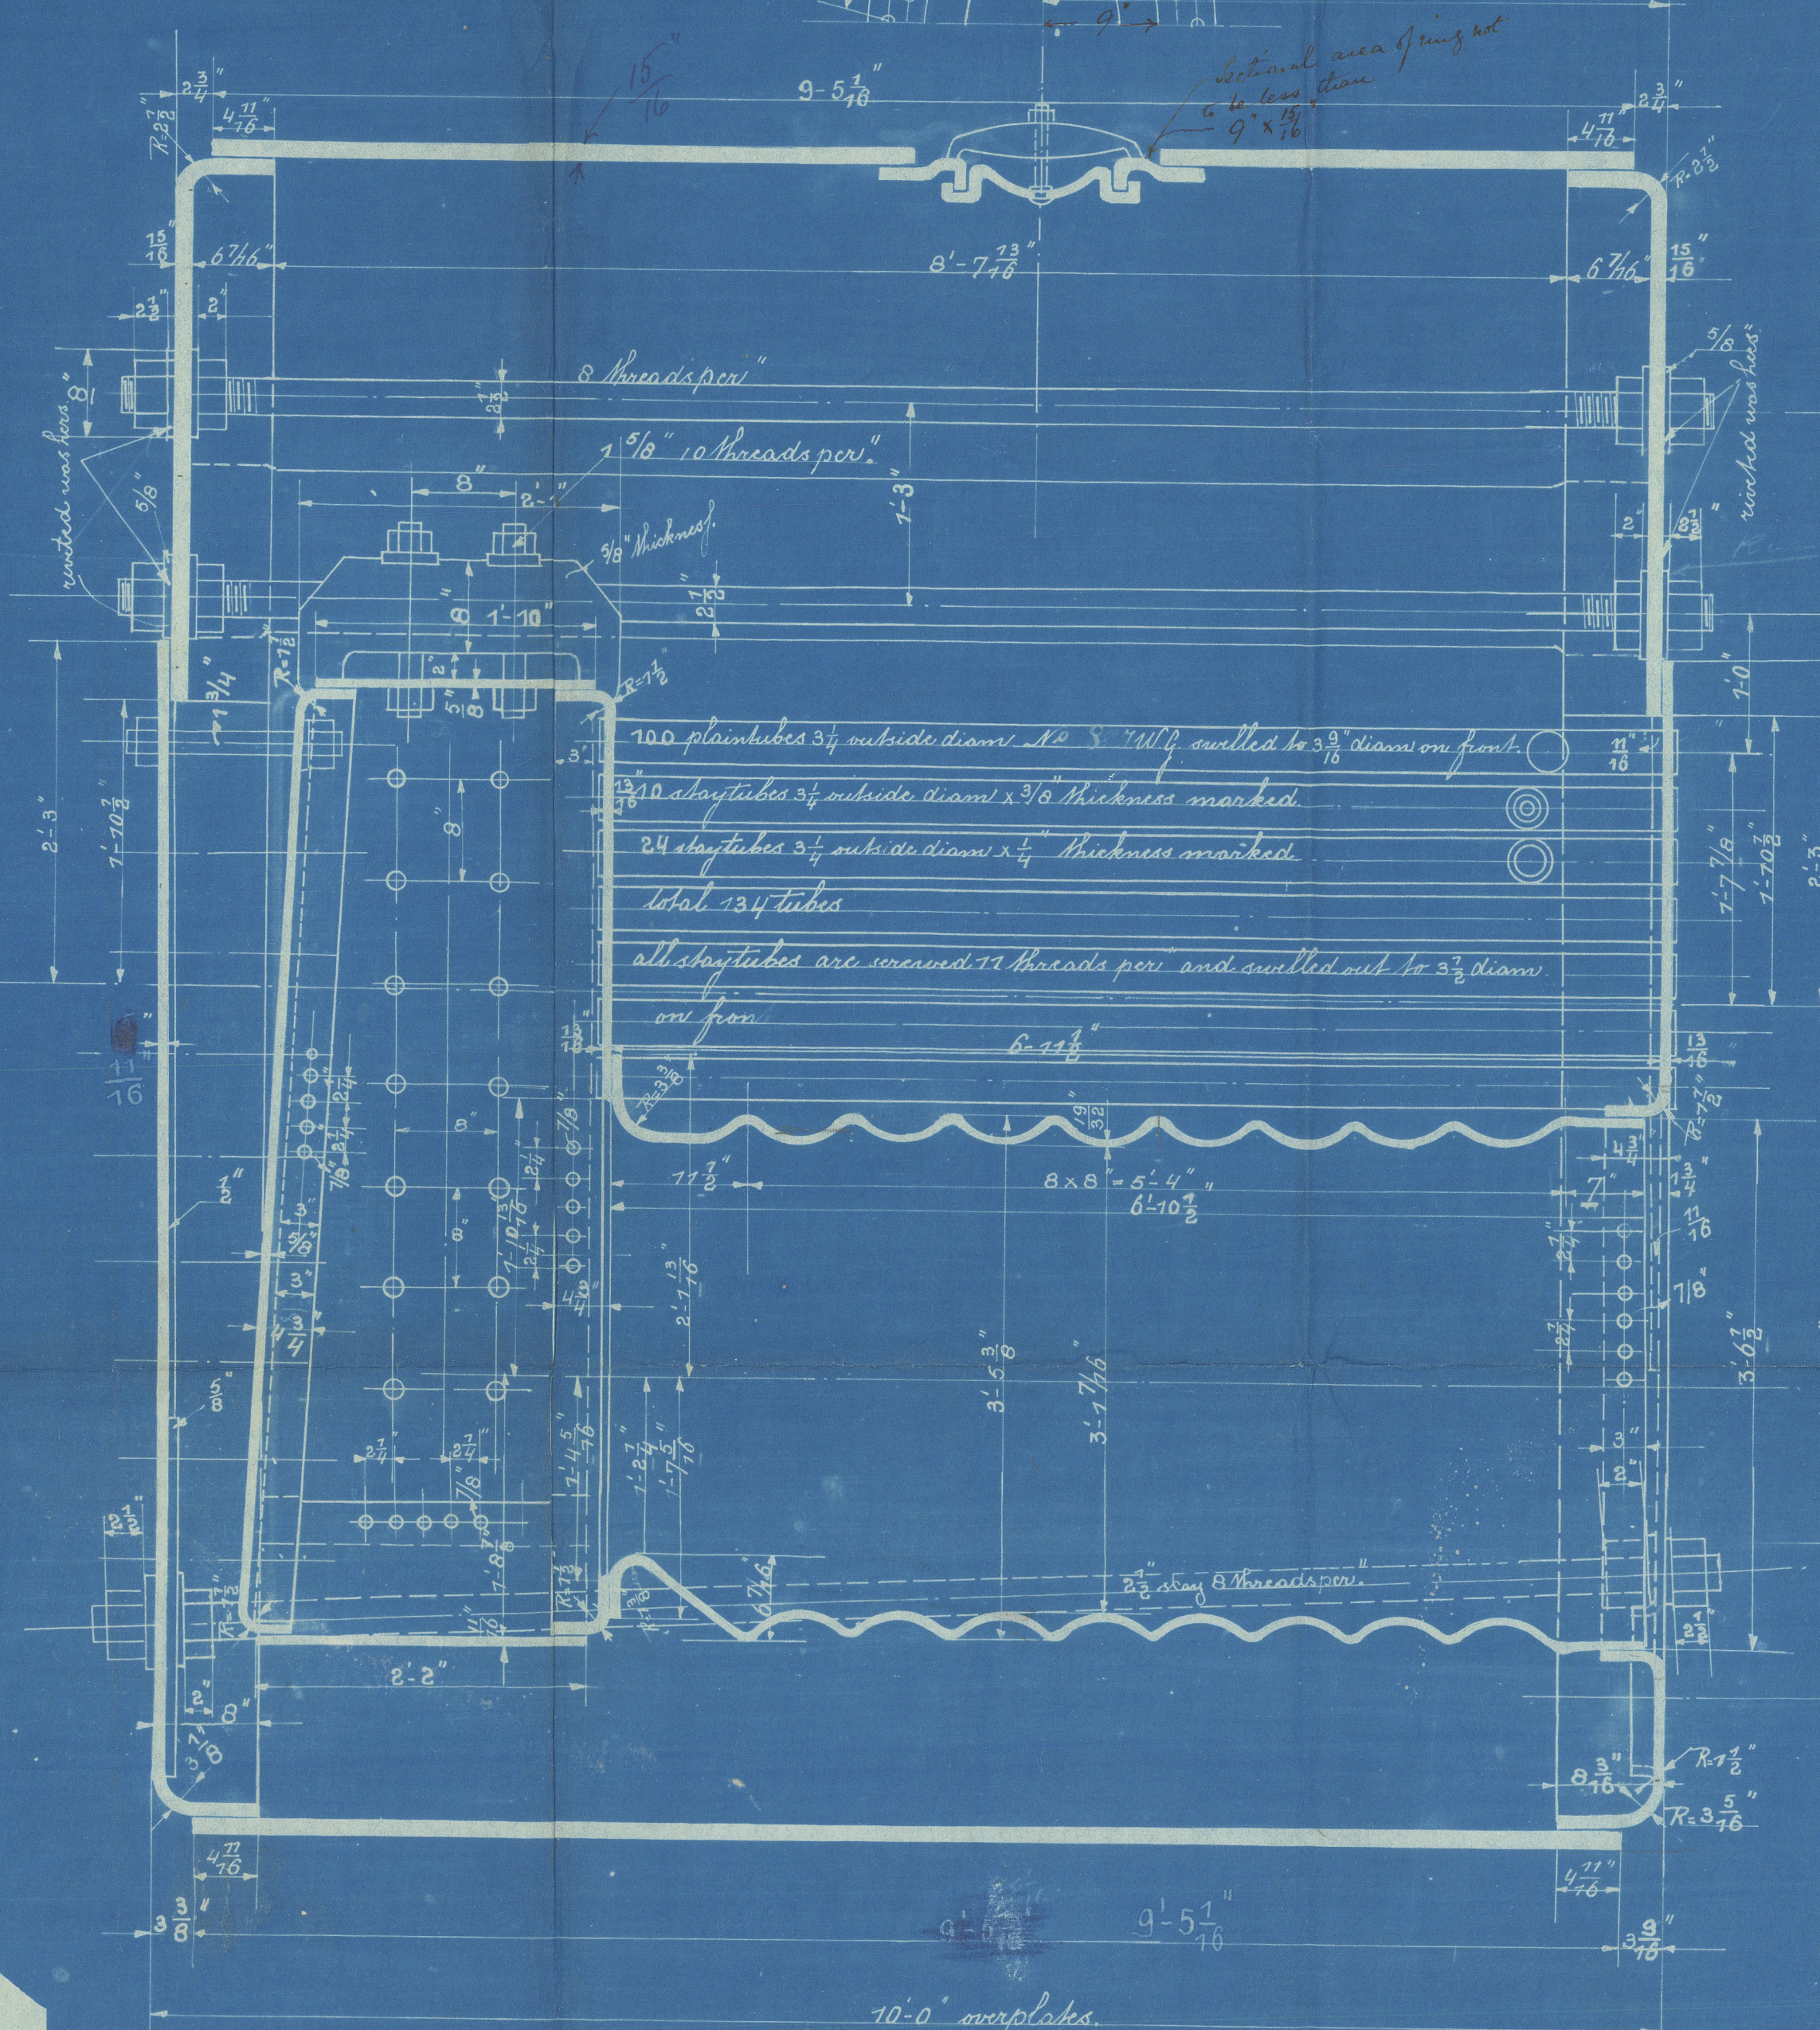


EXP NO 364 A

11129

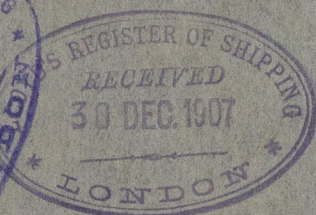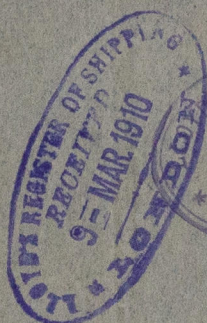

*Screw Tug "Seine"
Mainboilers*

*Port of Rotterdam
Report No. 5774^E*

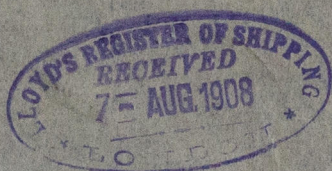

© 2019

Lloyd's Register
Foundation

W290-0218