



Position of stay tubes if iron,  $3\frac{1}{2}$ " dia, & 11 threads,  
 With this arrangement of stay tubes the back tube plate  
 may be made  $\frac{23}{32}$ " thick.

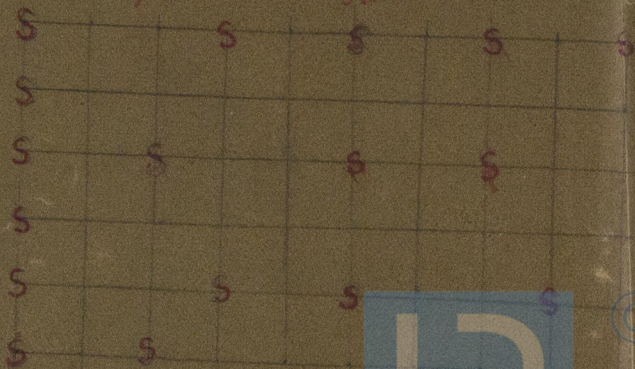


not adopted  
 W. G. B. M. O'Leary

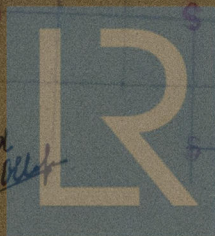

© 2019

Lloyd's Register  
 Foundation

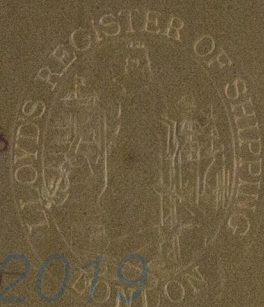

M290-0219