


STEAM SCREW TUG N°16
LONGITUDINAL & DECKPLANS
DIMENSIONS 130'-0" x 23'-0" x 13'-6" MLD
TO CLASS 100 AI LLOYDS
SCALE 1/4" = 1 FOOT

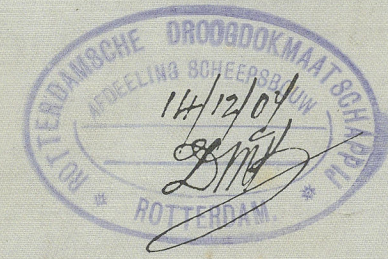

Ham. of Gloucester
Dine "
Gard no. 16.
Pair of Pedam.
Expos. no. 3774^A

MIDSHIP SECTION
SCALE $\frac{1}{2}'' = 1 \text{ FOOT}$

$$\begin{array}{r} \text{Tale. } 10 \times 7 \times 1.5 = 6160 \\ \text{Bridge } 45 \times 7 \times 1.5 = 472 \\ \hline 6737 \end{array}$$

NUMERALS

1/2 GIRTH 22.3

1/2 BEAM 11.5

DEPTH 15.97

47.77 AT NUMERAL

LENGTH 188.56

6160.41 NO NUMERAL

EQUIPMENT NUMERAL ~~6160.41~~ 84

1 PATENT STOCKLESS ANCHOR 7 CWT

1 PATENT STOCKLESS SPANCHOR 8 CWT

1 COMMON ANCHOR 9 CWT INCLUDING STOCK

180 PATHWAYS 1 1/4 STUO CHAIN CABLE

TOWING + WARPING HAWESER SUPPLIED BY OWNERS (Acc per notes)

1 Kedge anchor 1 cwt
ex. stock

Frames cut &
bracketed in way
of W.T. flat.

C.B.
18.12.07.

SCALE № 1 FOOT

TO CLASS 100 VI FLOORS

DIMENSIONS 130-0 x 53-0 x 13-0 IN

LONGITUDINAL & DECK PLANS




Seine

RA 5744

MS

Profile + DKS