

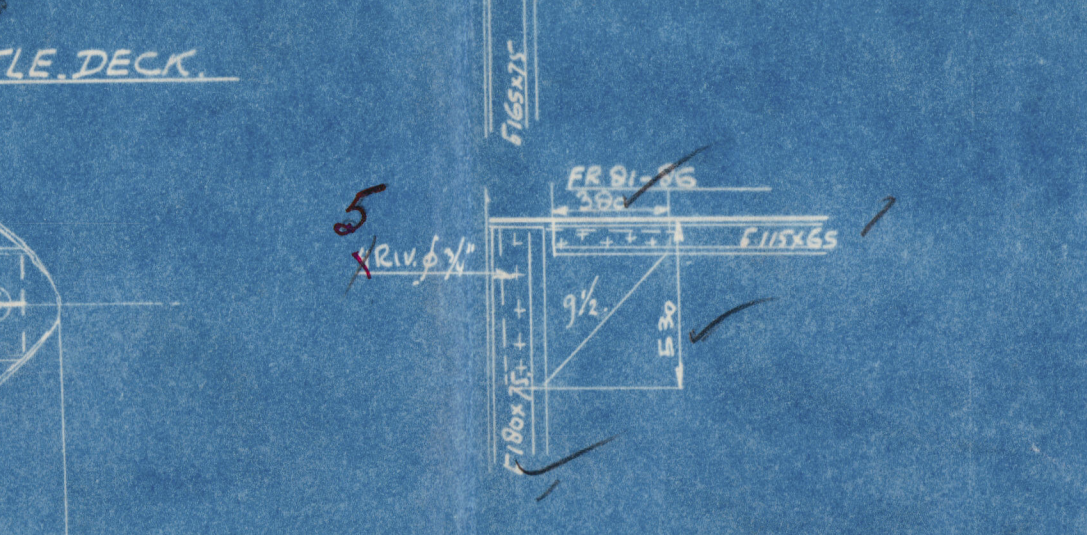
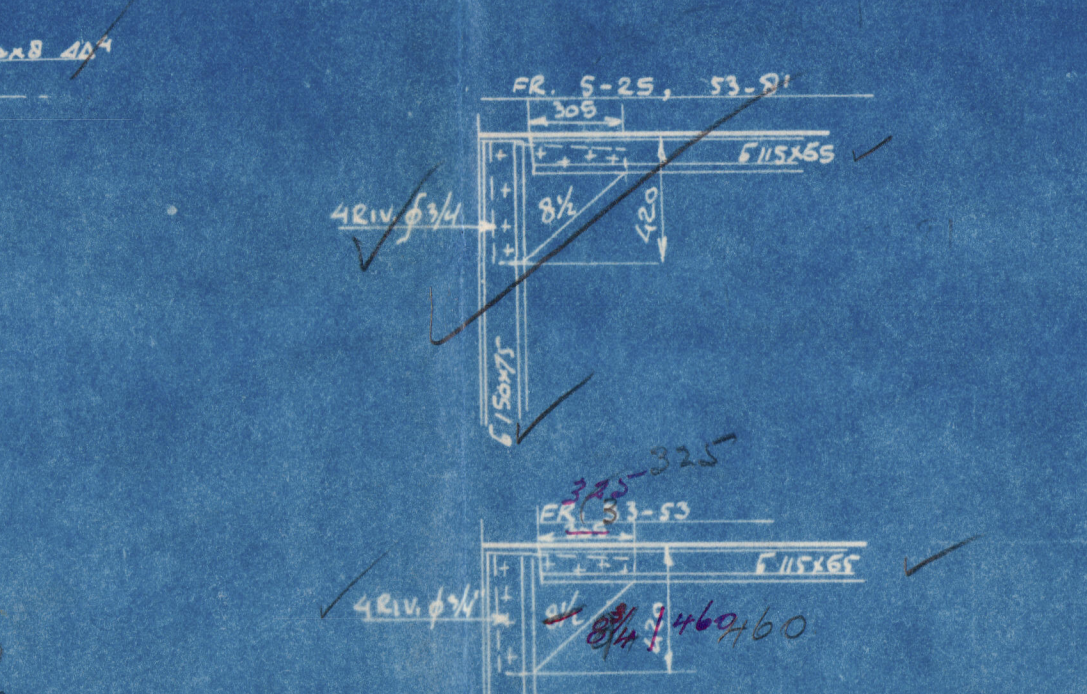
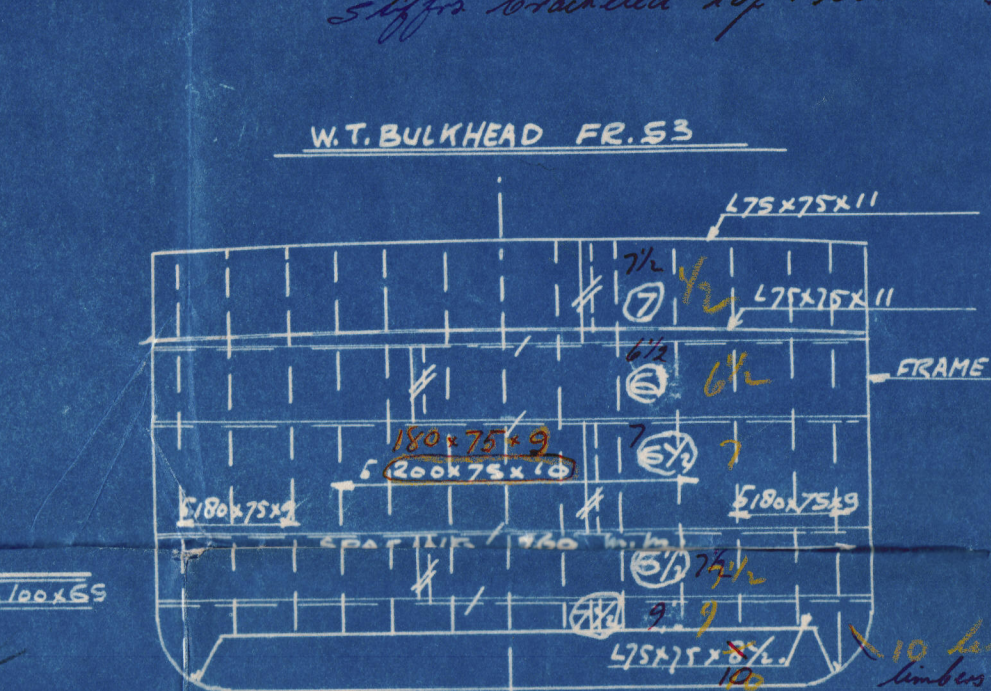
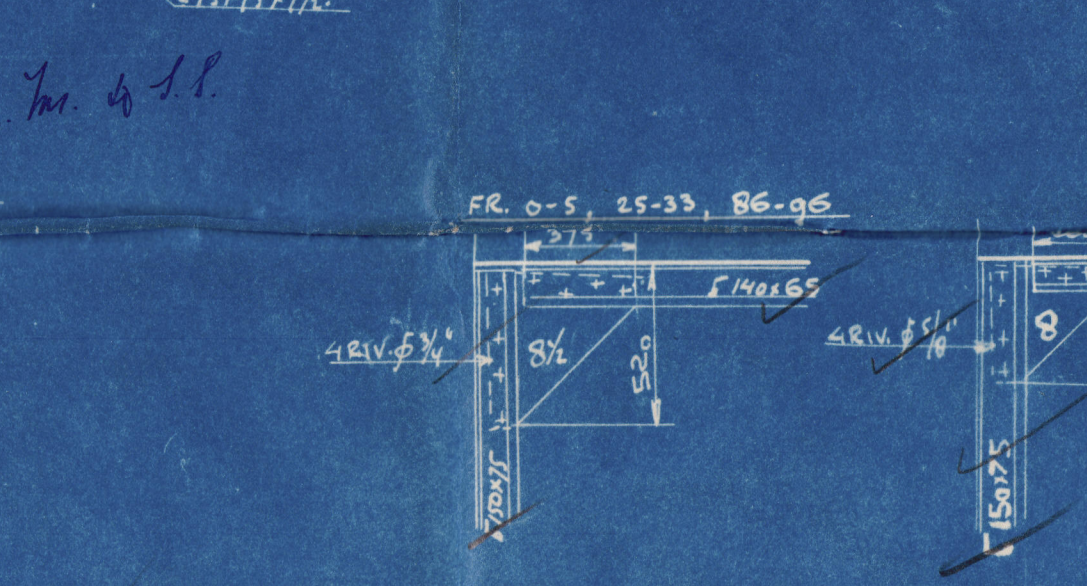
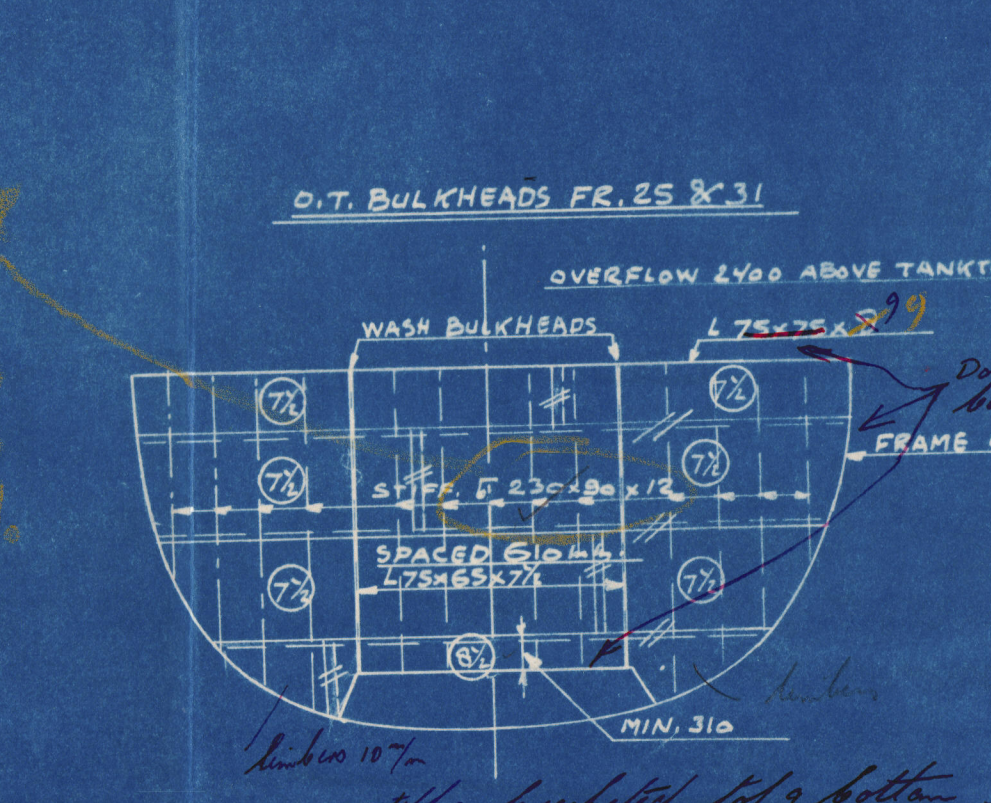



250

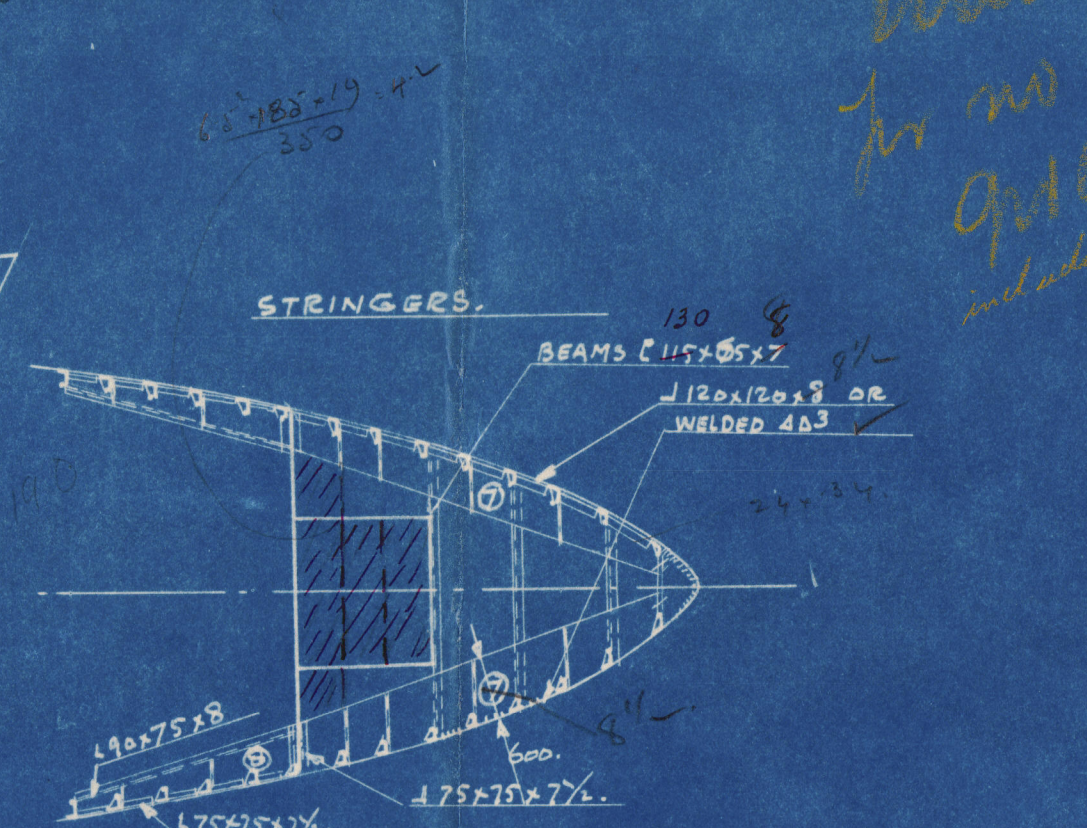

122A

JKL  
15/8/39

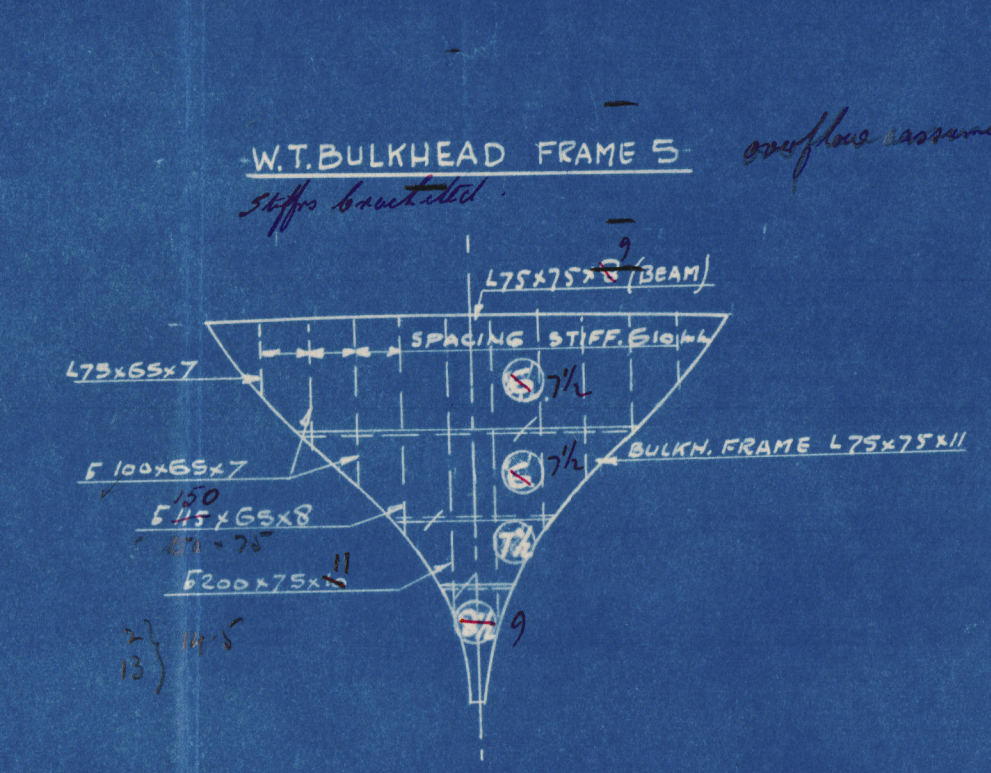

 "VIRIATO" 

Profile & Decks, shell  
expansion, bulkheads and  
double bottom

2



© 2019

Lloyd's Register  
Foundation  
W291-0065