

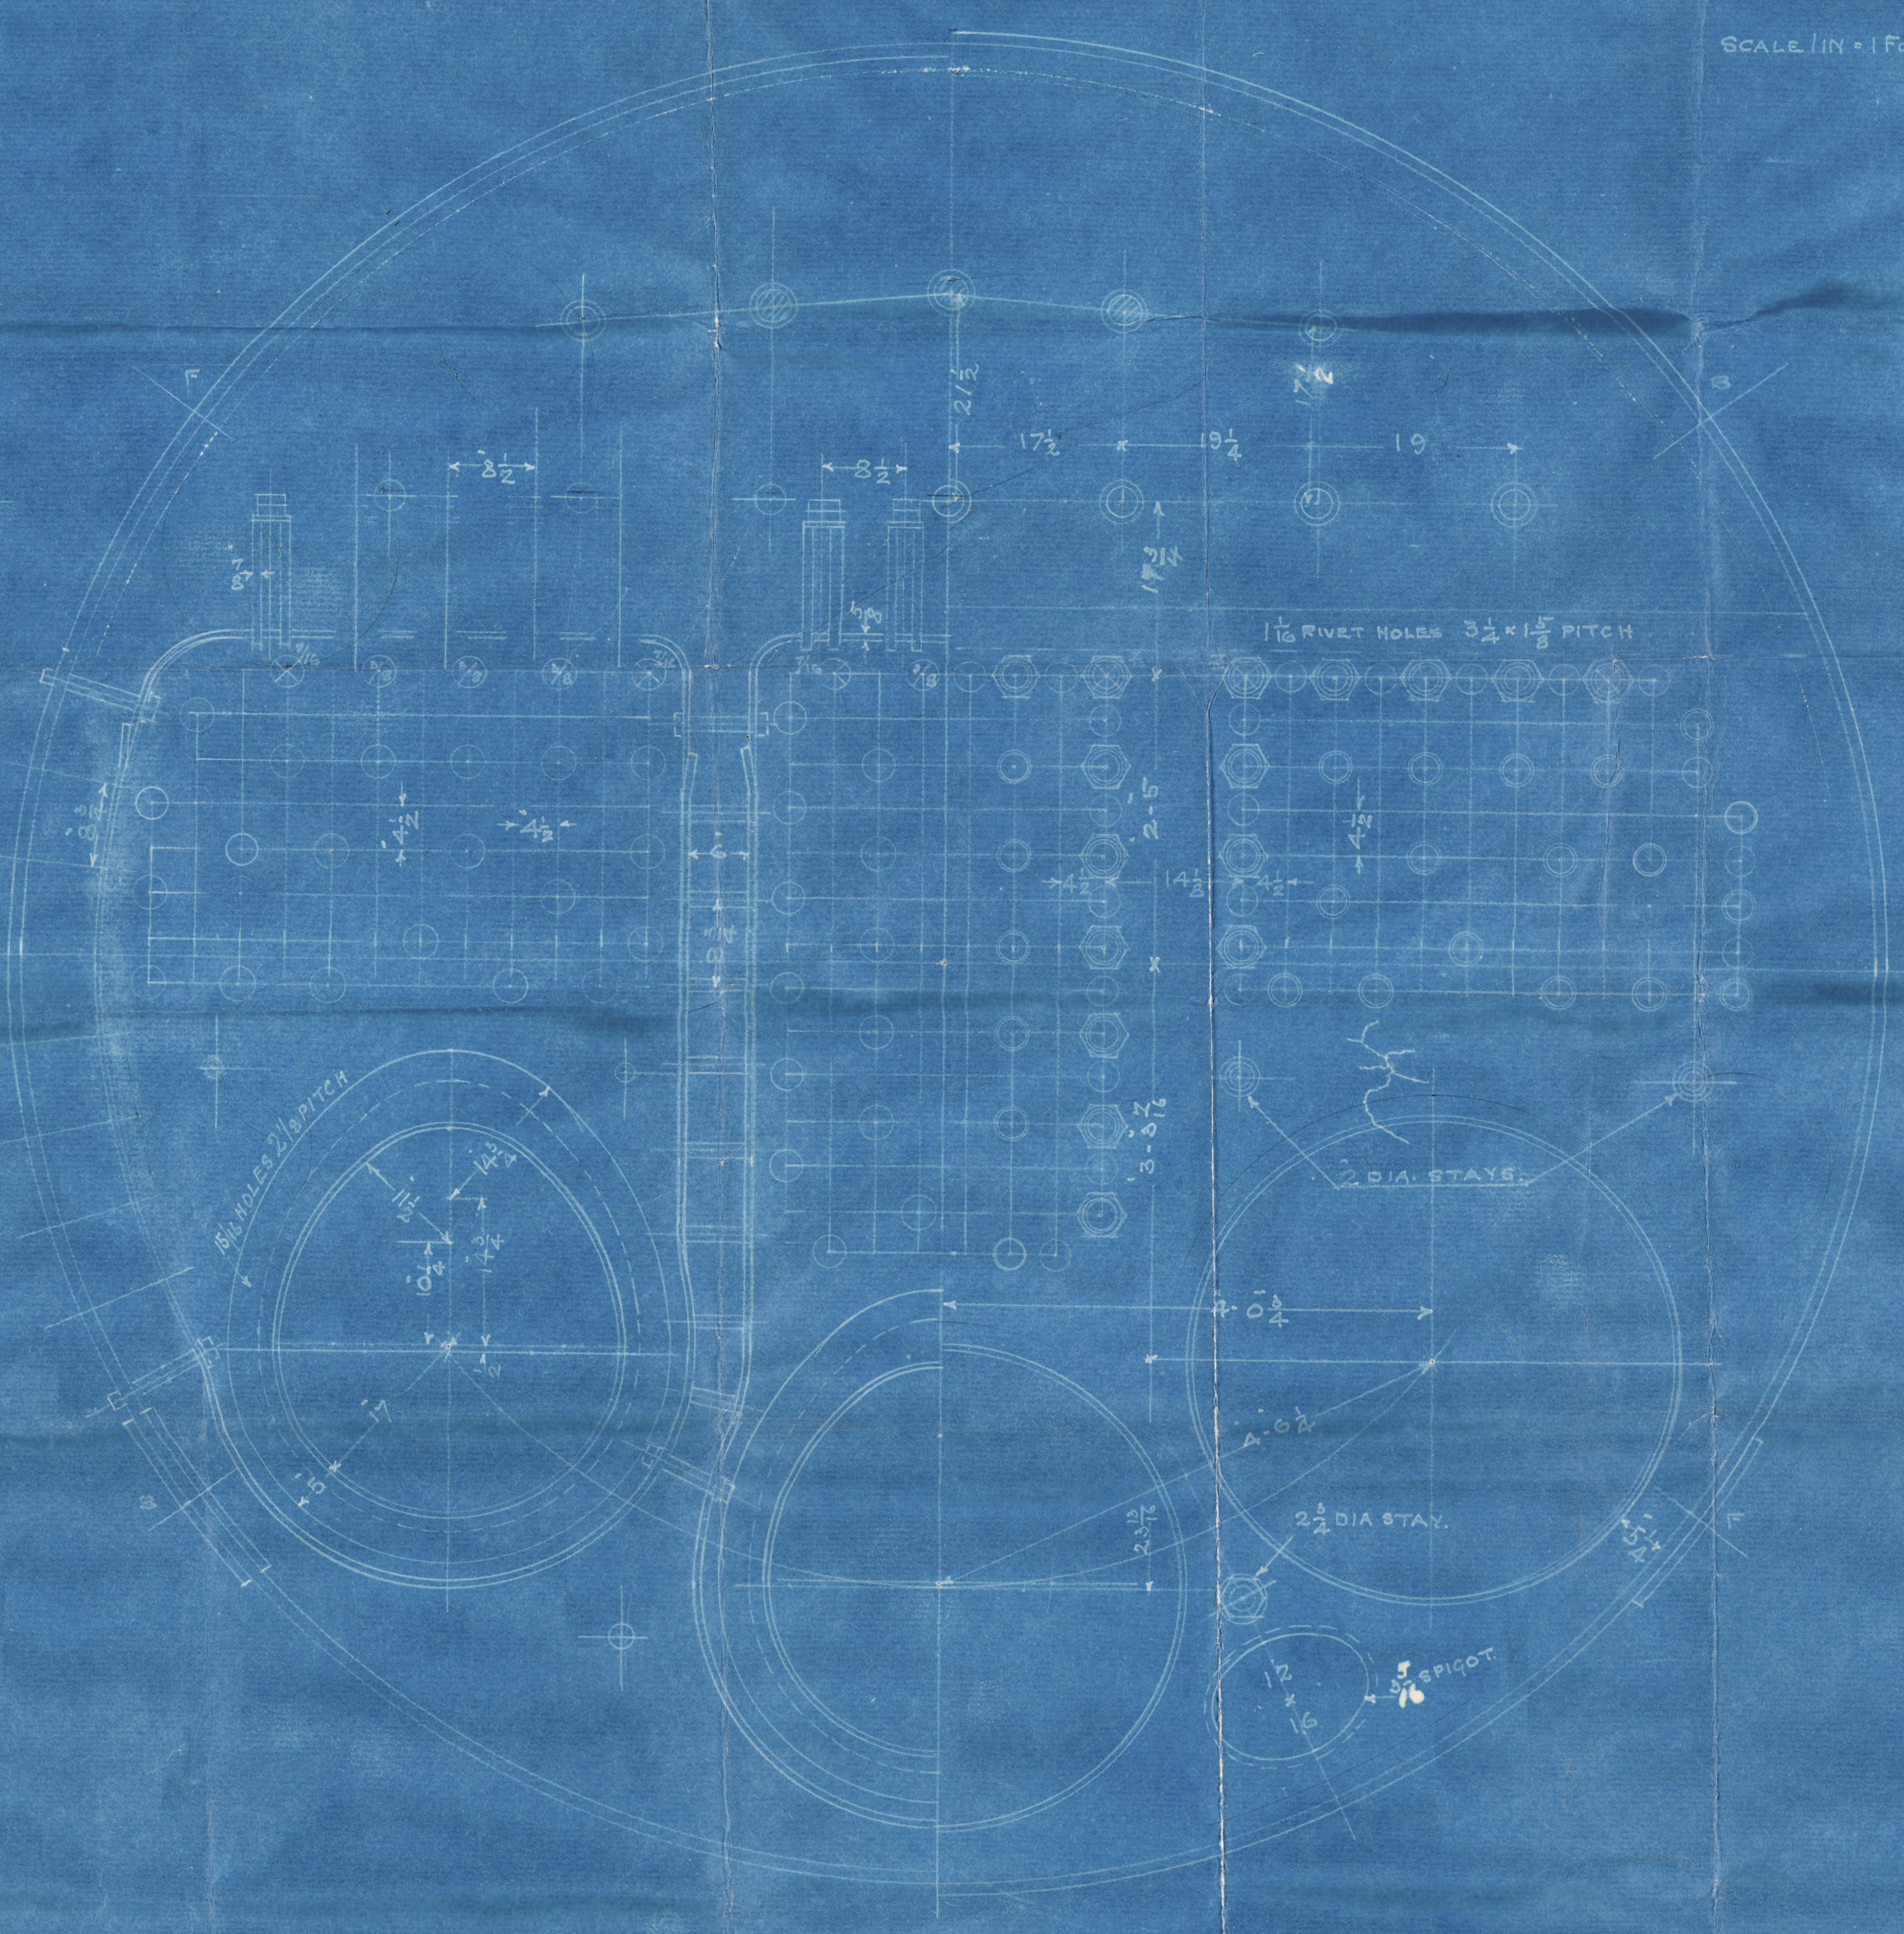


TO BE FITTED TO S. S. CHARTERHAQUE
 TO PASS LLOYDS SURVEY FOR A WORKING PRESSURE OF 200 LBS PER IN.
 TO BE TESTED IN THE PRESENCE OF LLOYDS & OWNERS SURVEYORS.

- TENSILE OF SHELL PLATES 28.5 TO 32.5 TONS.
- FLANGE & FURNACES 26.0 - 30.0
 - MAIN STAYS & RIBS 28.0 - 32.0
 - SCREW - & RIVET BAR 26.0 - 30.0

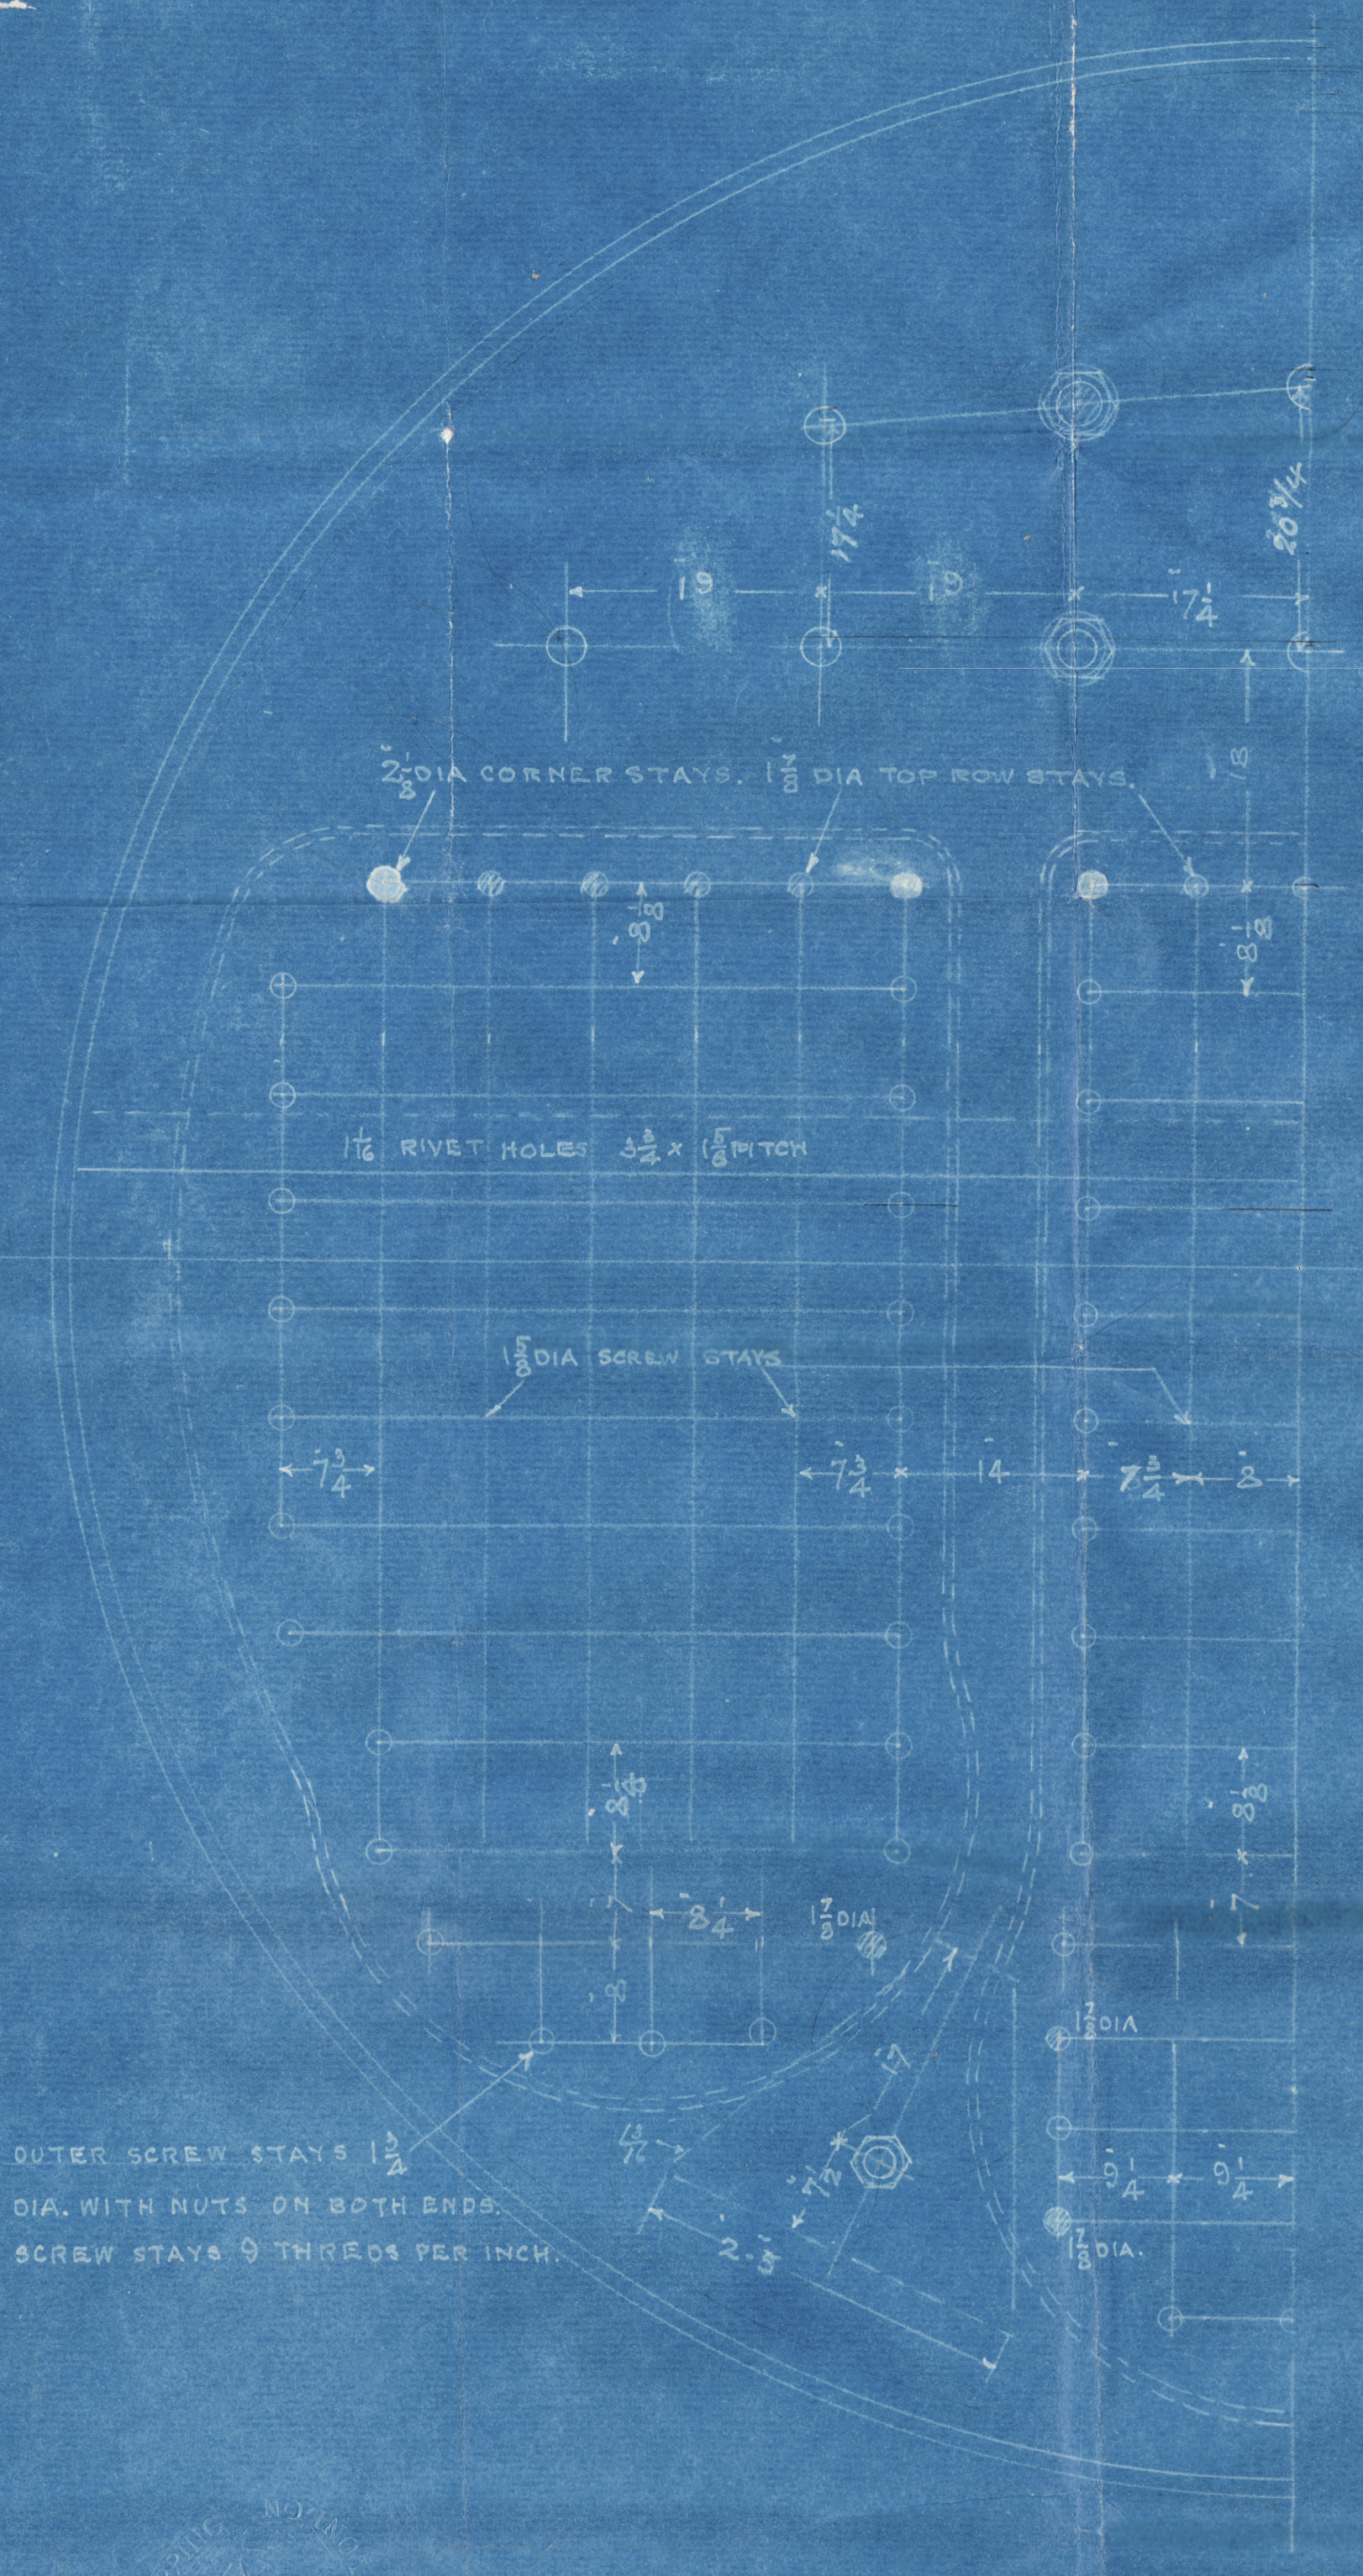

2. OFF
 SCALE 1 IN = 1 FOOT.

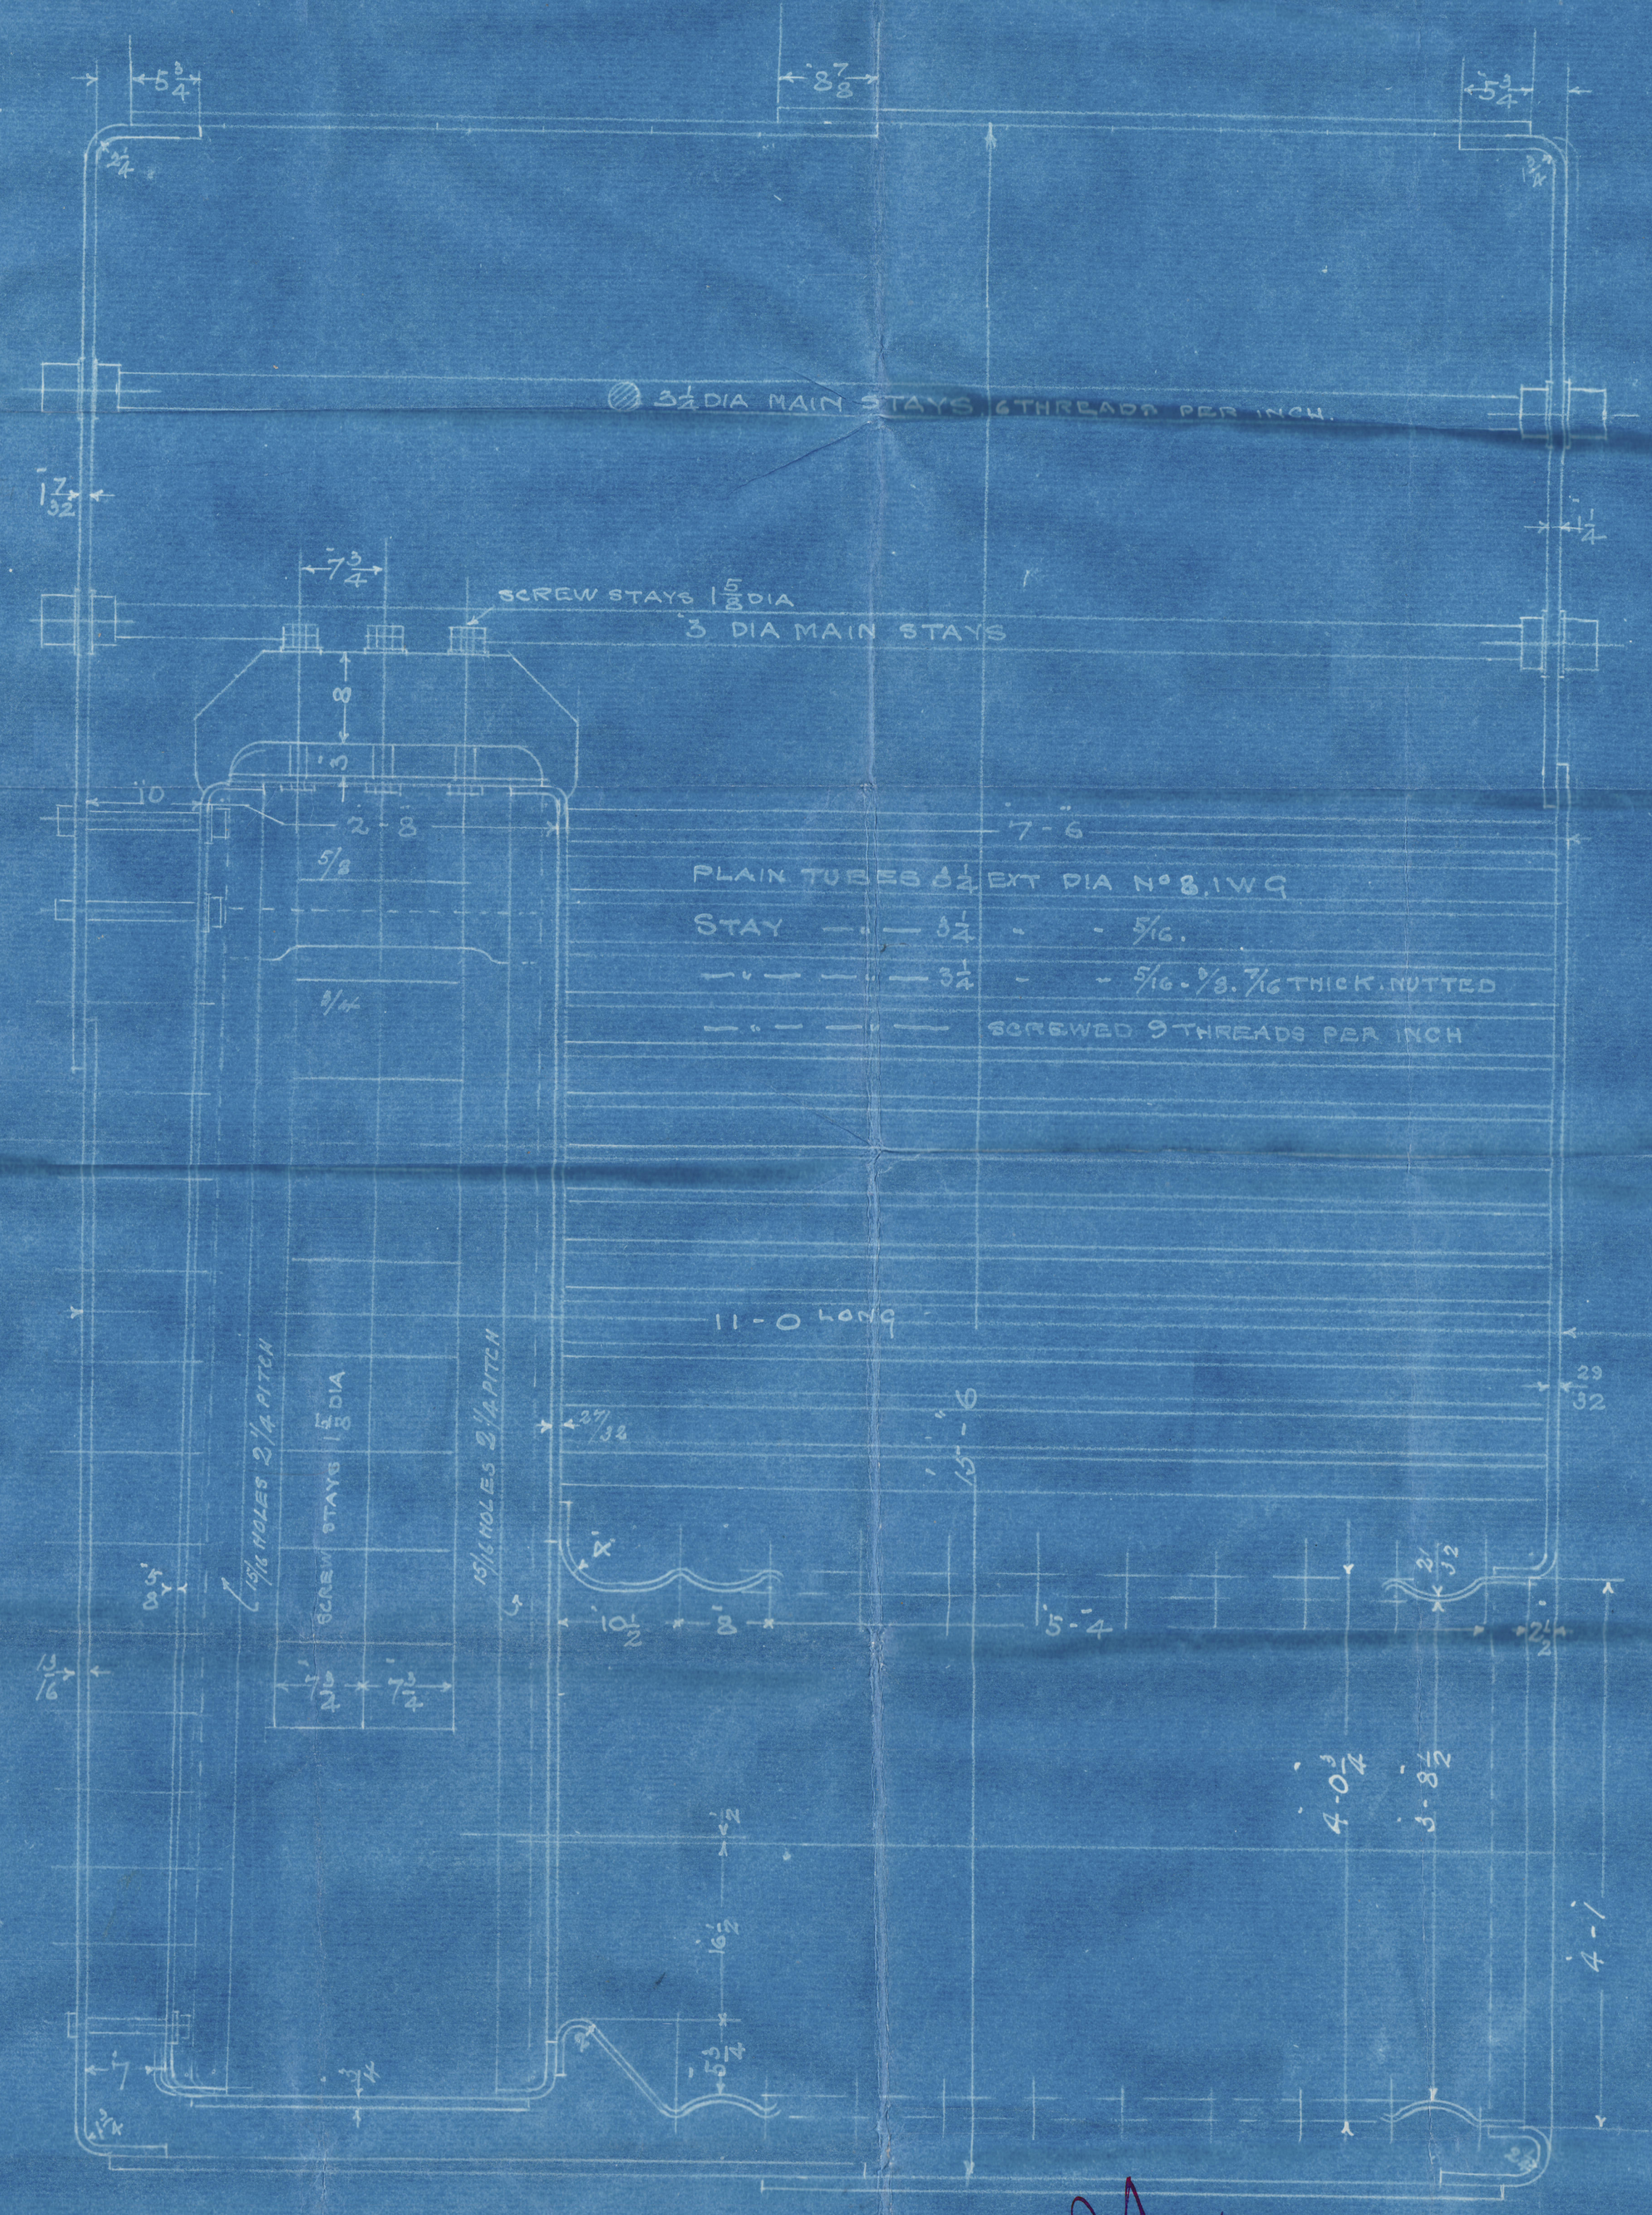

90-81-80

S2194.
 BOILERS No 172

28/12/26
 23/12/26
 22 DEC 1926
 LLOYD'S REGISTER FOUNDATION
 W291-0173

MAIN BOILERS
SS CHARTERHAGUE

RICHARDSONS
WESTGARTH & CO

No S 2194

SUNDERLAND RPT. No. 29440



© 2019

Lloyd's Register
Foundation

W291-0173