



Opening to be provided for access
for examination & cleaning purposes.




Point
Punkt D

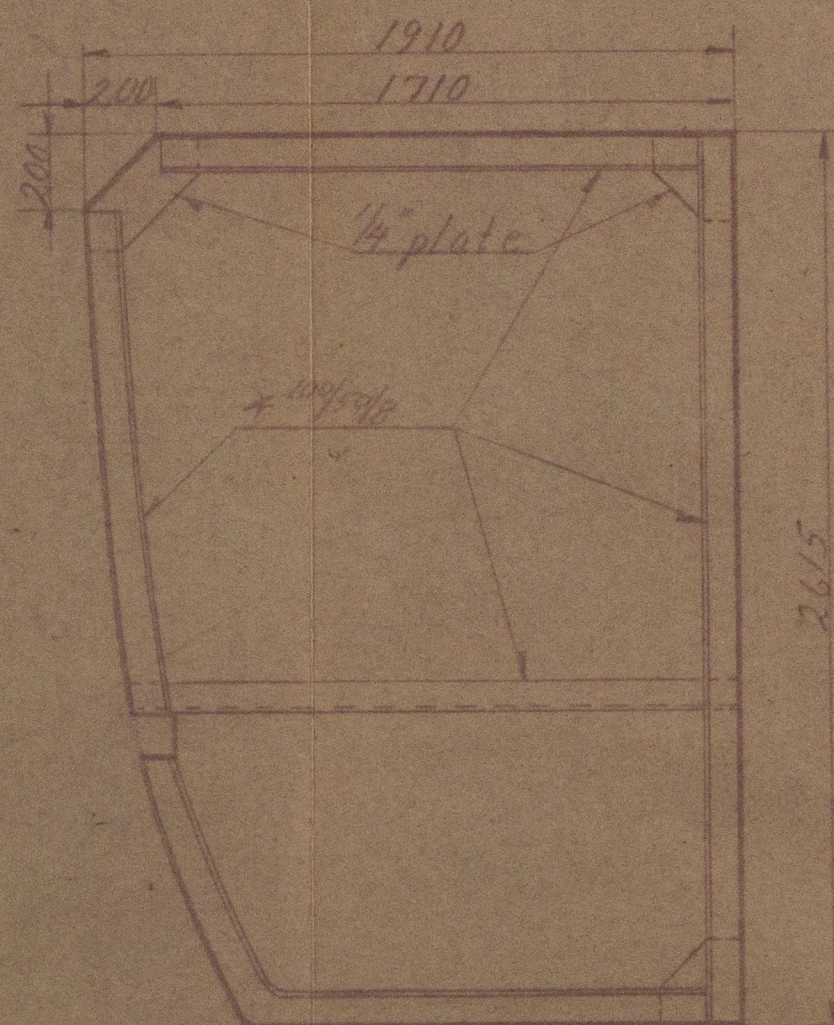

Section
Snitt A-A

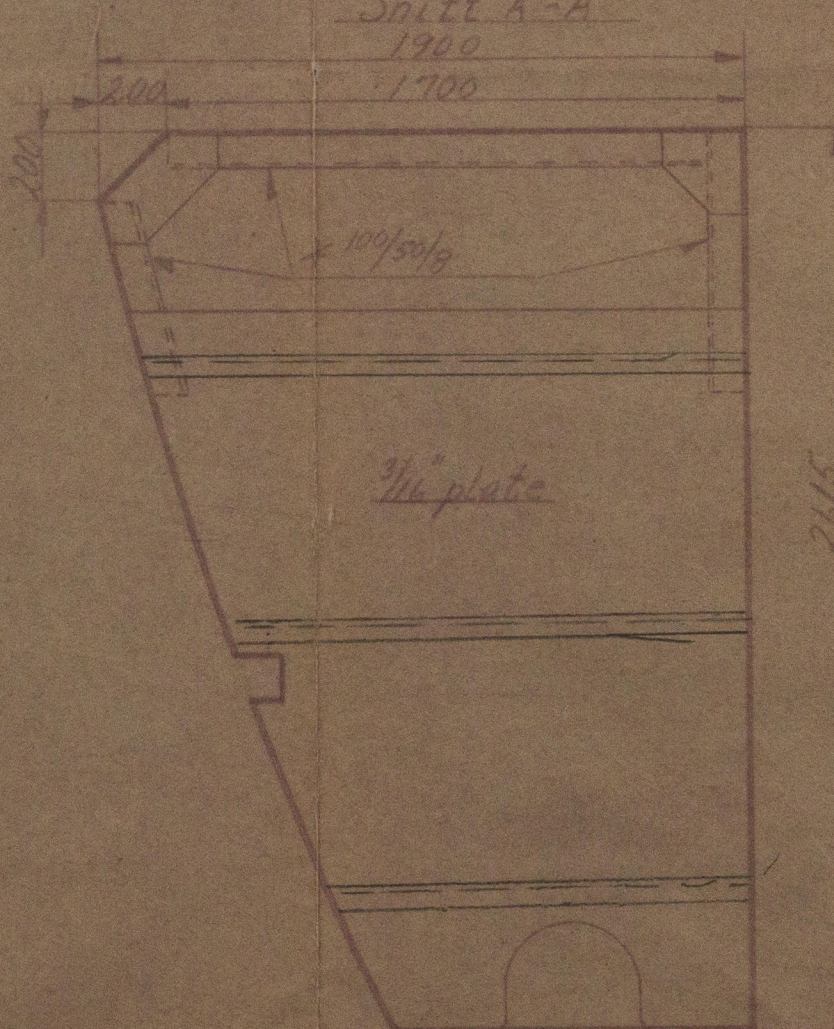

Section
Snitt B-B

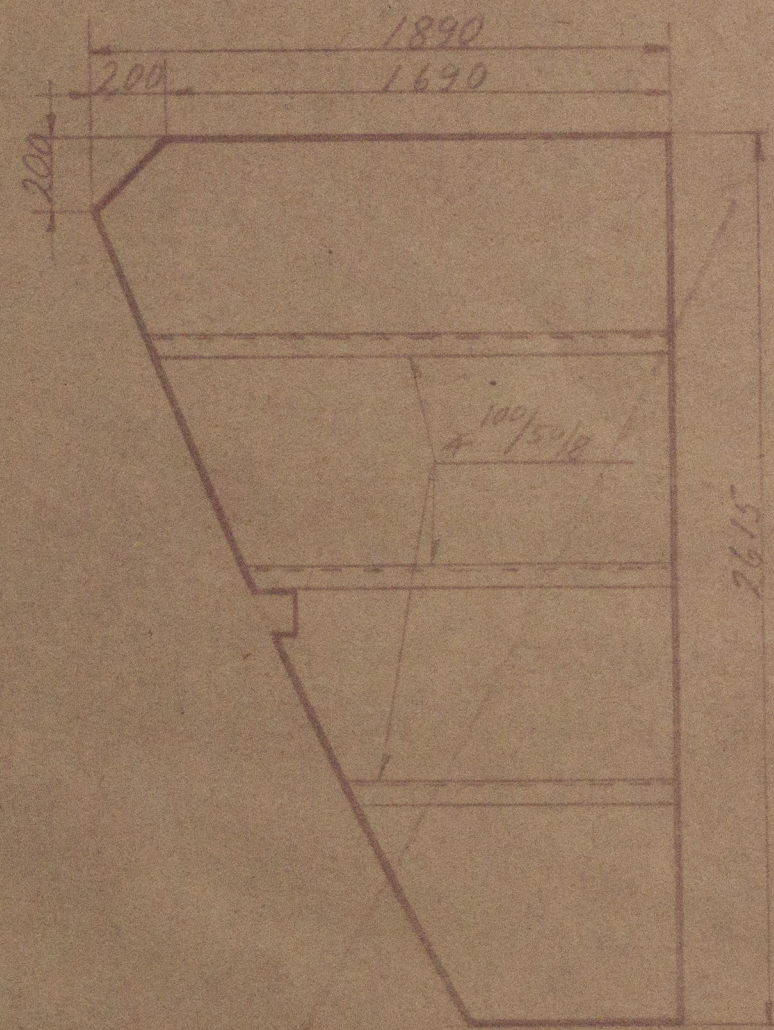

Section
Snitt C-C

The remaining requirements of Section 20
of the Rules 1938-9 to be complied with so
far as they are applicable.

The tank will be built welded of 1/4" plate -
Tanken sveises av 1/4" plater

ca 9 tonn

LONDON COPY.

Nr	Ant	Gjenstand og dim.	Matr.	Supplerende tegninger
		Fuel oil tank		
		Brensel-oljetank for 1/5 Hellelund		
		M=120		
		45 MOSS MEK. VERKSTED		
		For O.Nr: 318 Veritas 1/5		
		F.Nr. 682		
		Erstattet for		
		Erstattet av		



© 2019
Lloyd's Register
Foundation

W295-0177

mv. "HÆLLESUND"

OSLO REPORT No. 5442

1 plan - fuel oil tank

W295-0177



© 2019

Lloyd's Register
Foundation