

m.o. "HELLESUND"

OSLO RPT No. 5442

1 plan - fuel oil tank.



W295-0178




© 2019

Lloyd's Register  
Foundation




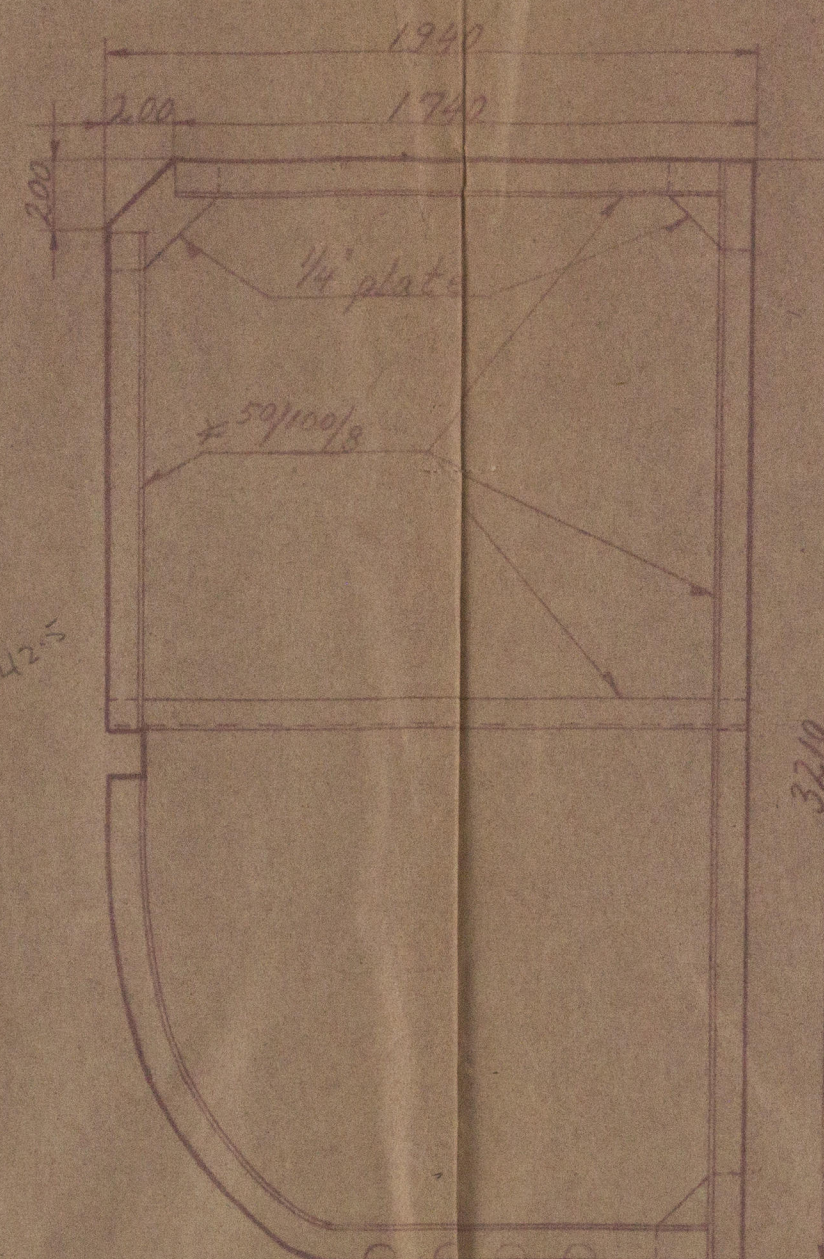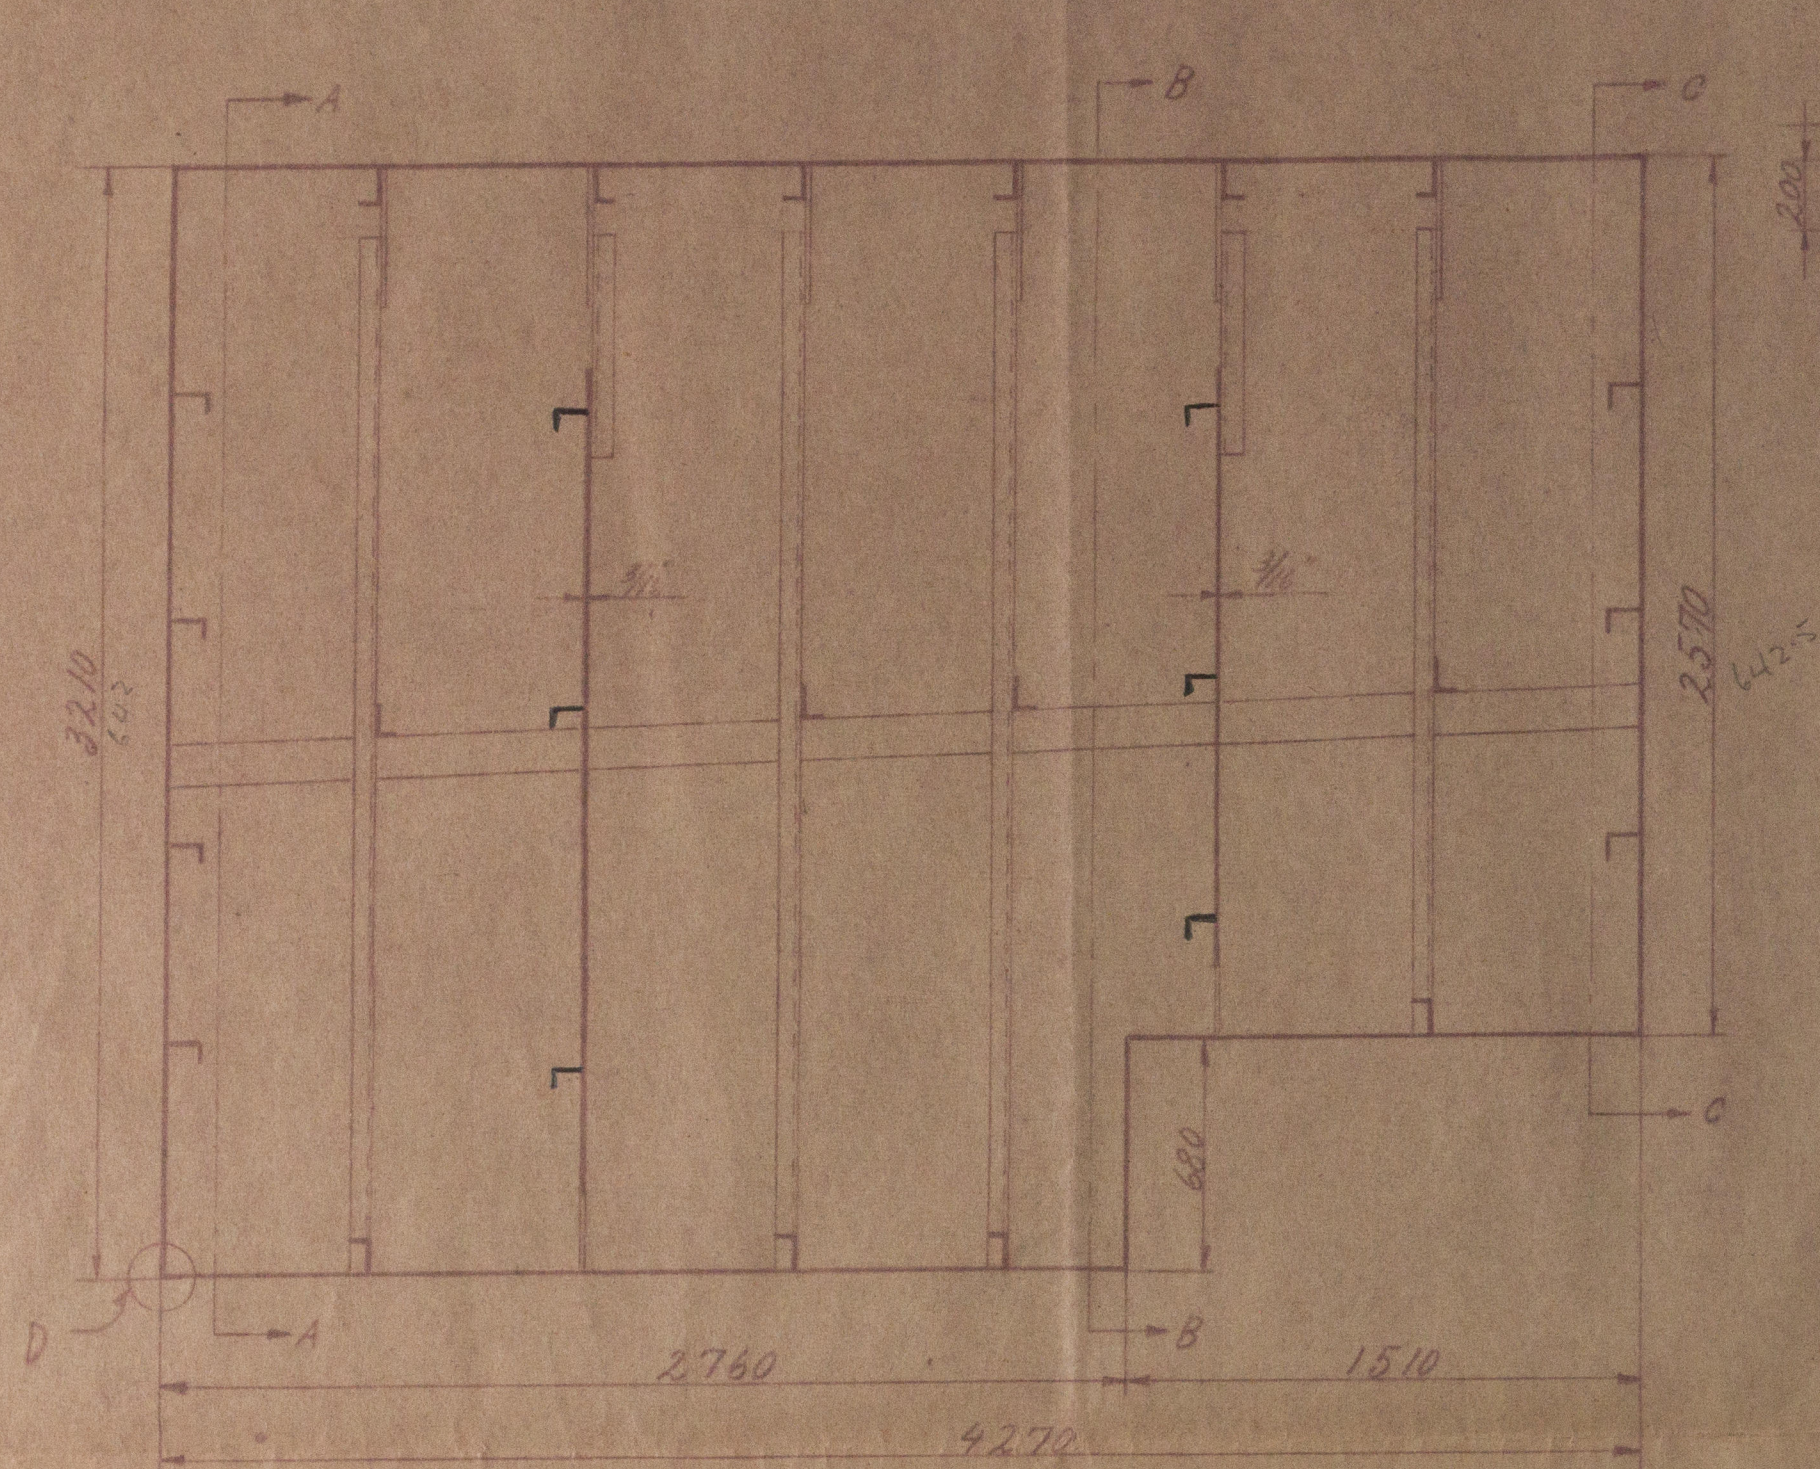

Snitt A-A

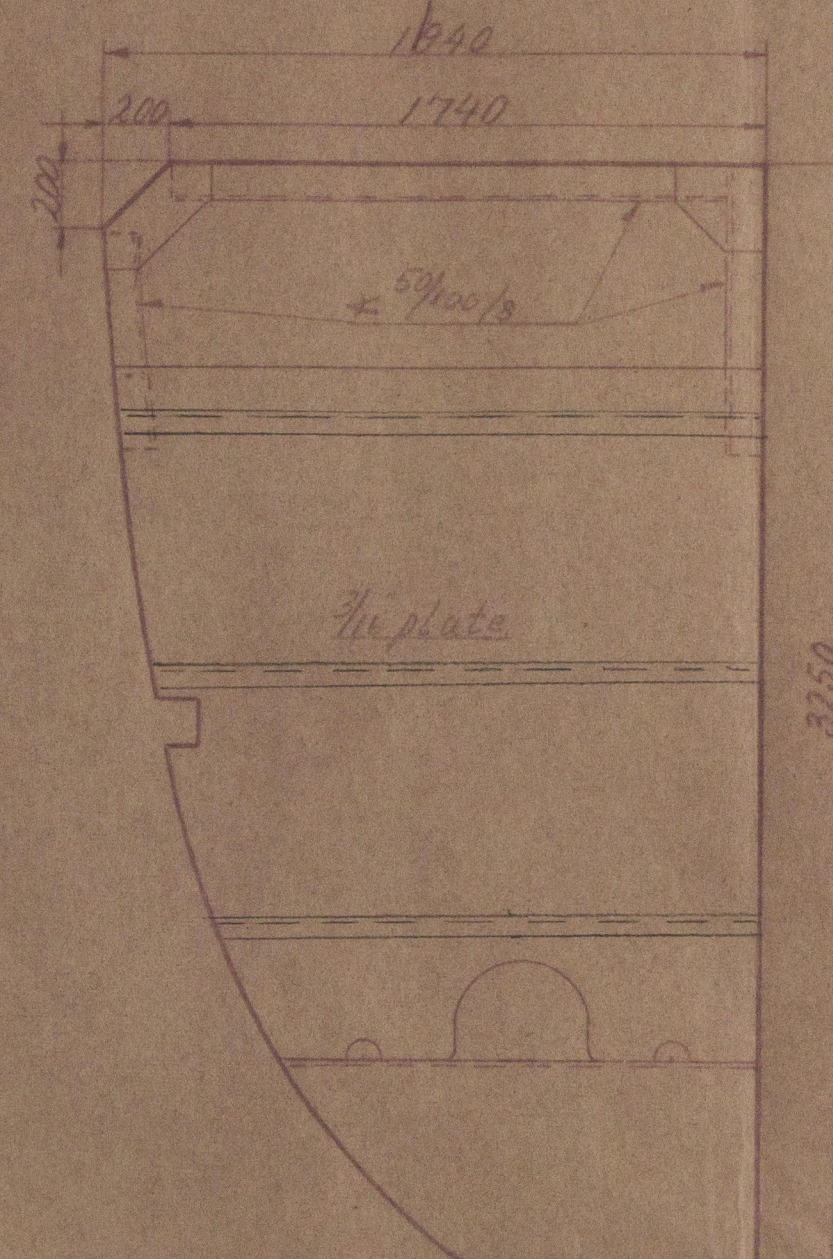


Snitt B-B

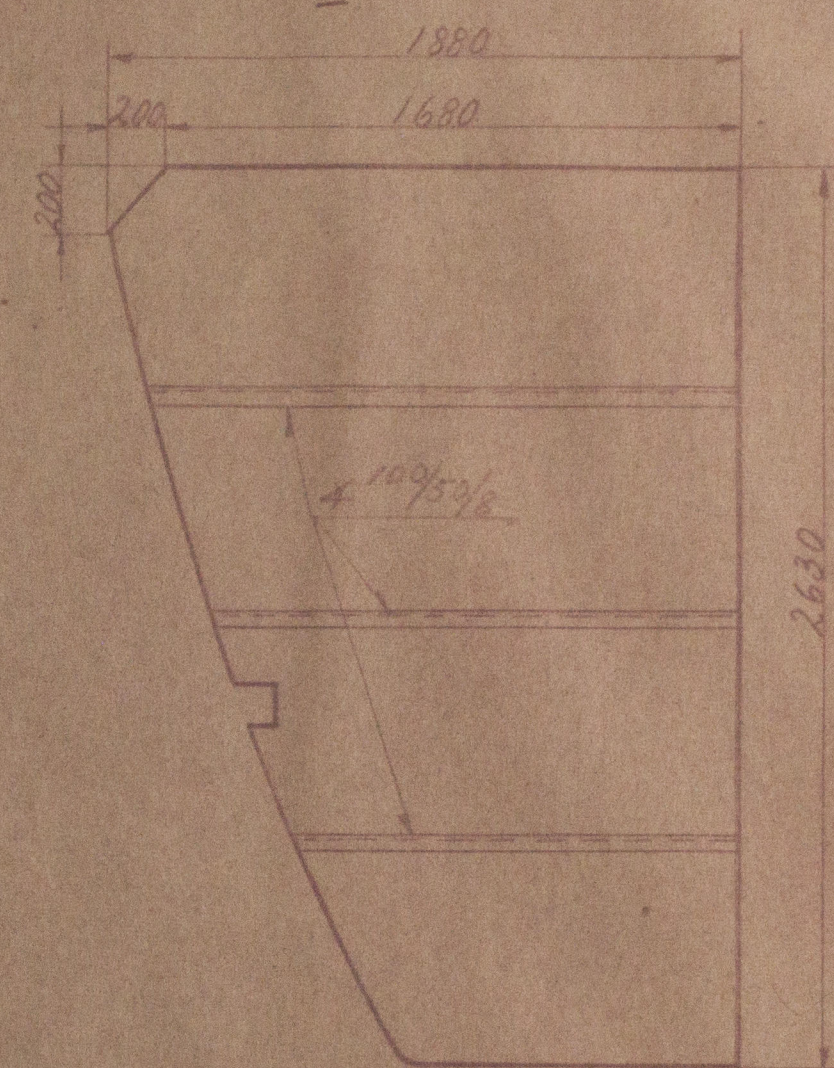

Snitt C-C

Tanken reises av 1/4 plater  
ca. 18 tonn.

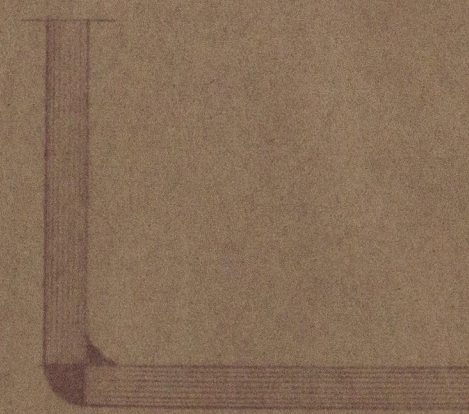

Punkt D

Opening to be provided for access  
for examination & cleaning purposes.

4270  
2760

The remaining requirements of Section 20  
of the Rules 1932-9 to be complied with so  
far as they are applicable.

LONDON COPY.

Nr	Ant.	Gjenstand og dim.	Matr.	Supplerende tegninger:
		Fuel oil tank Brensel-oljetank for "H. Hellesund"		
		M. 1/20		
		4/5 MOSS MEK. VERKSTED.		
		For O.Nr.: 318 Veritas		
		F.Nr. 682		
		Erstatning for:		
		Erstattet av:		

13-8-39



© 2019

Lloyd's Register  
Foundation

W295-0178