
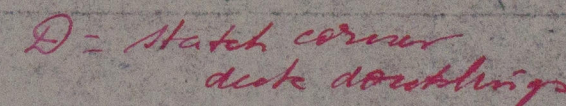


— SAN CRISTOBAL —
LOYDS DIMENS. 139.3' x 23.5' x 11.4' - DEPTH MOULDED 12'-7 1/2"
SCALE: 1/8" = 1'-0"

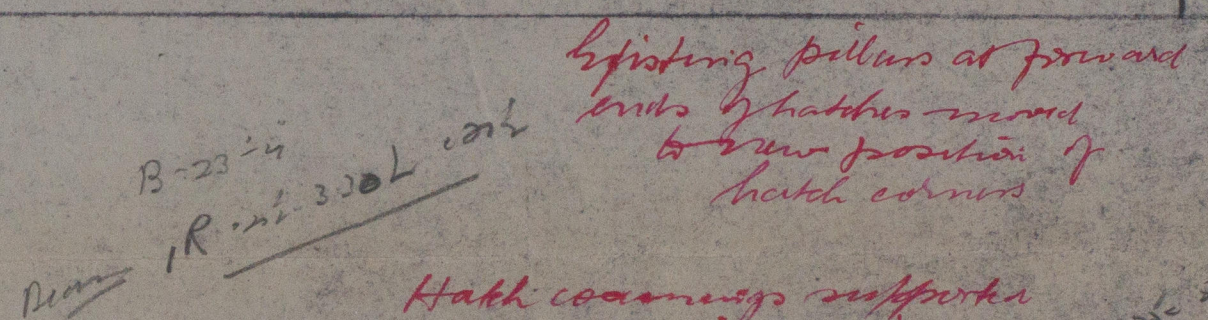

LR
Lloyds Register
5295-013701

SP. Hellsund, (ex San Cristobal
Martin)
Ool. rept. No. 493).

Alterations to nos. 1 & 2 hatchling.

W295-0197



© 2019

Lloyd's Register
Foundation